

WILSON HAMILTON & CO LTD
17 JUNE 1940
PORT-GLARROW


MASTS, WINCHES, WINDLASS, DECKHOUSES ETC
SUPPORTED TO SURVEYOR'S SATISFACTION

S.S. "MARIETTA E."

PROFILE & DECK PLAN.

SCALE $\frac{1}{8}" = 1 \text{ FOOT}$

DIMENSIONS: L.B.P. 415'-0". BREADTH MOULDED 60'-2". DEPTH MOULDED 38'-3" TO UPPER DECK. TO CLASS LLOYDS*
100.A1. WITH A FREEBOARD CORRESPONDING TO A DRAUGHT NOT EXCEEDING THAT CONTEMPLATED
BY THE RULES FOR A COMPLETE SUPERSTRUCTURE VESSEL HAVING A TONNAGE OPENING.
WITH SPECIAL NOTATIONS: LONGITUDINAL FRAMING AT BOTTOM AND DECK.
ISHERWOOD COMBINATION SYSTEM. ARCFORM PATENT (N.B. NEW BRITISH STANDARD)

 

W^m Hamilton & C^o.


N. 439.

Profile & DT. plans
as Built.

S. S. MARIETTA E.

York 1st E. P. H. W.

W192-0118

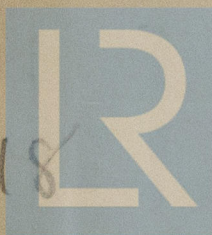

© 2019

Lloyd's Register
Foundation