




20 DEC 1938

AFTER OIL FUEL BUNKERS
LLANDAFF CASTLE
No 5026/
SCALE 1/4 INCH - ONE FOOT
BUNKERS TESTED TO 42'6 ABOVE BASE

Reinforcing

Boundary Bulkheads	Scams to Butts	By	36	2 1/2"
Stiffeners	Stiffeners	By	6	1 1/2"
Stiffeners to Shell	Stiffeners to Shell	By	3/4"	1 1/2"
Bar to Tank Top	Bar to Tank Top	By	3/4"	1 1/2"

Steel Head 48" G above Base
Flash Band of Deck is above 130' F.

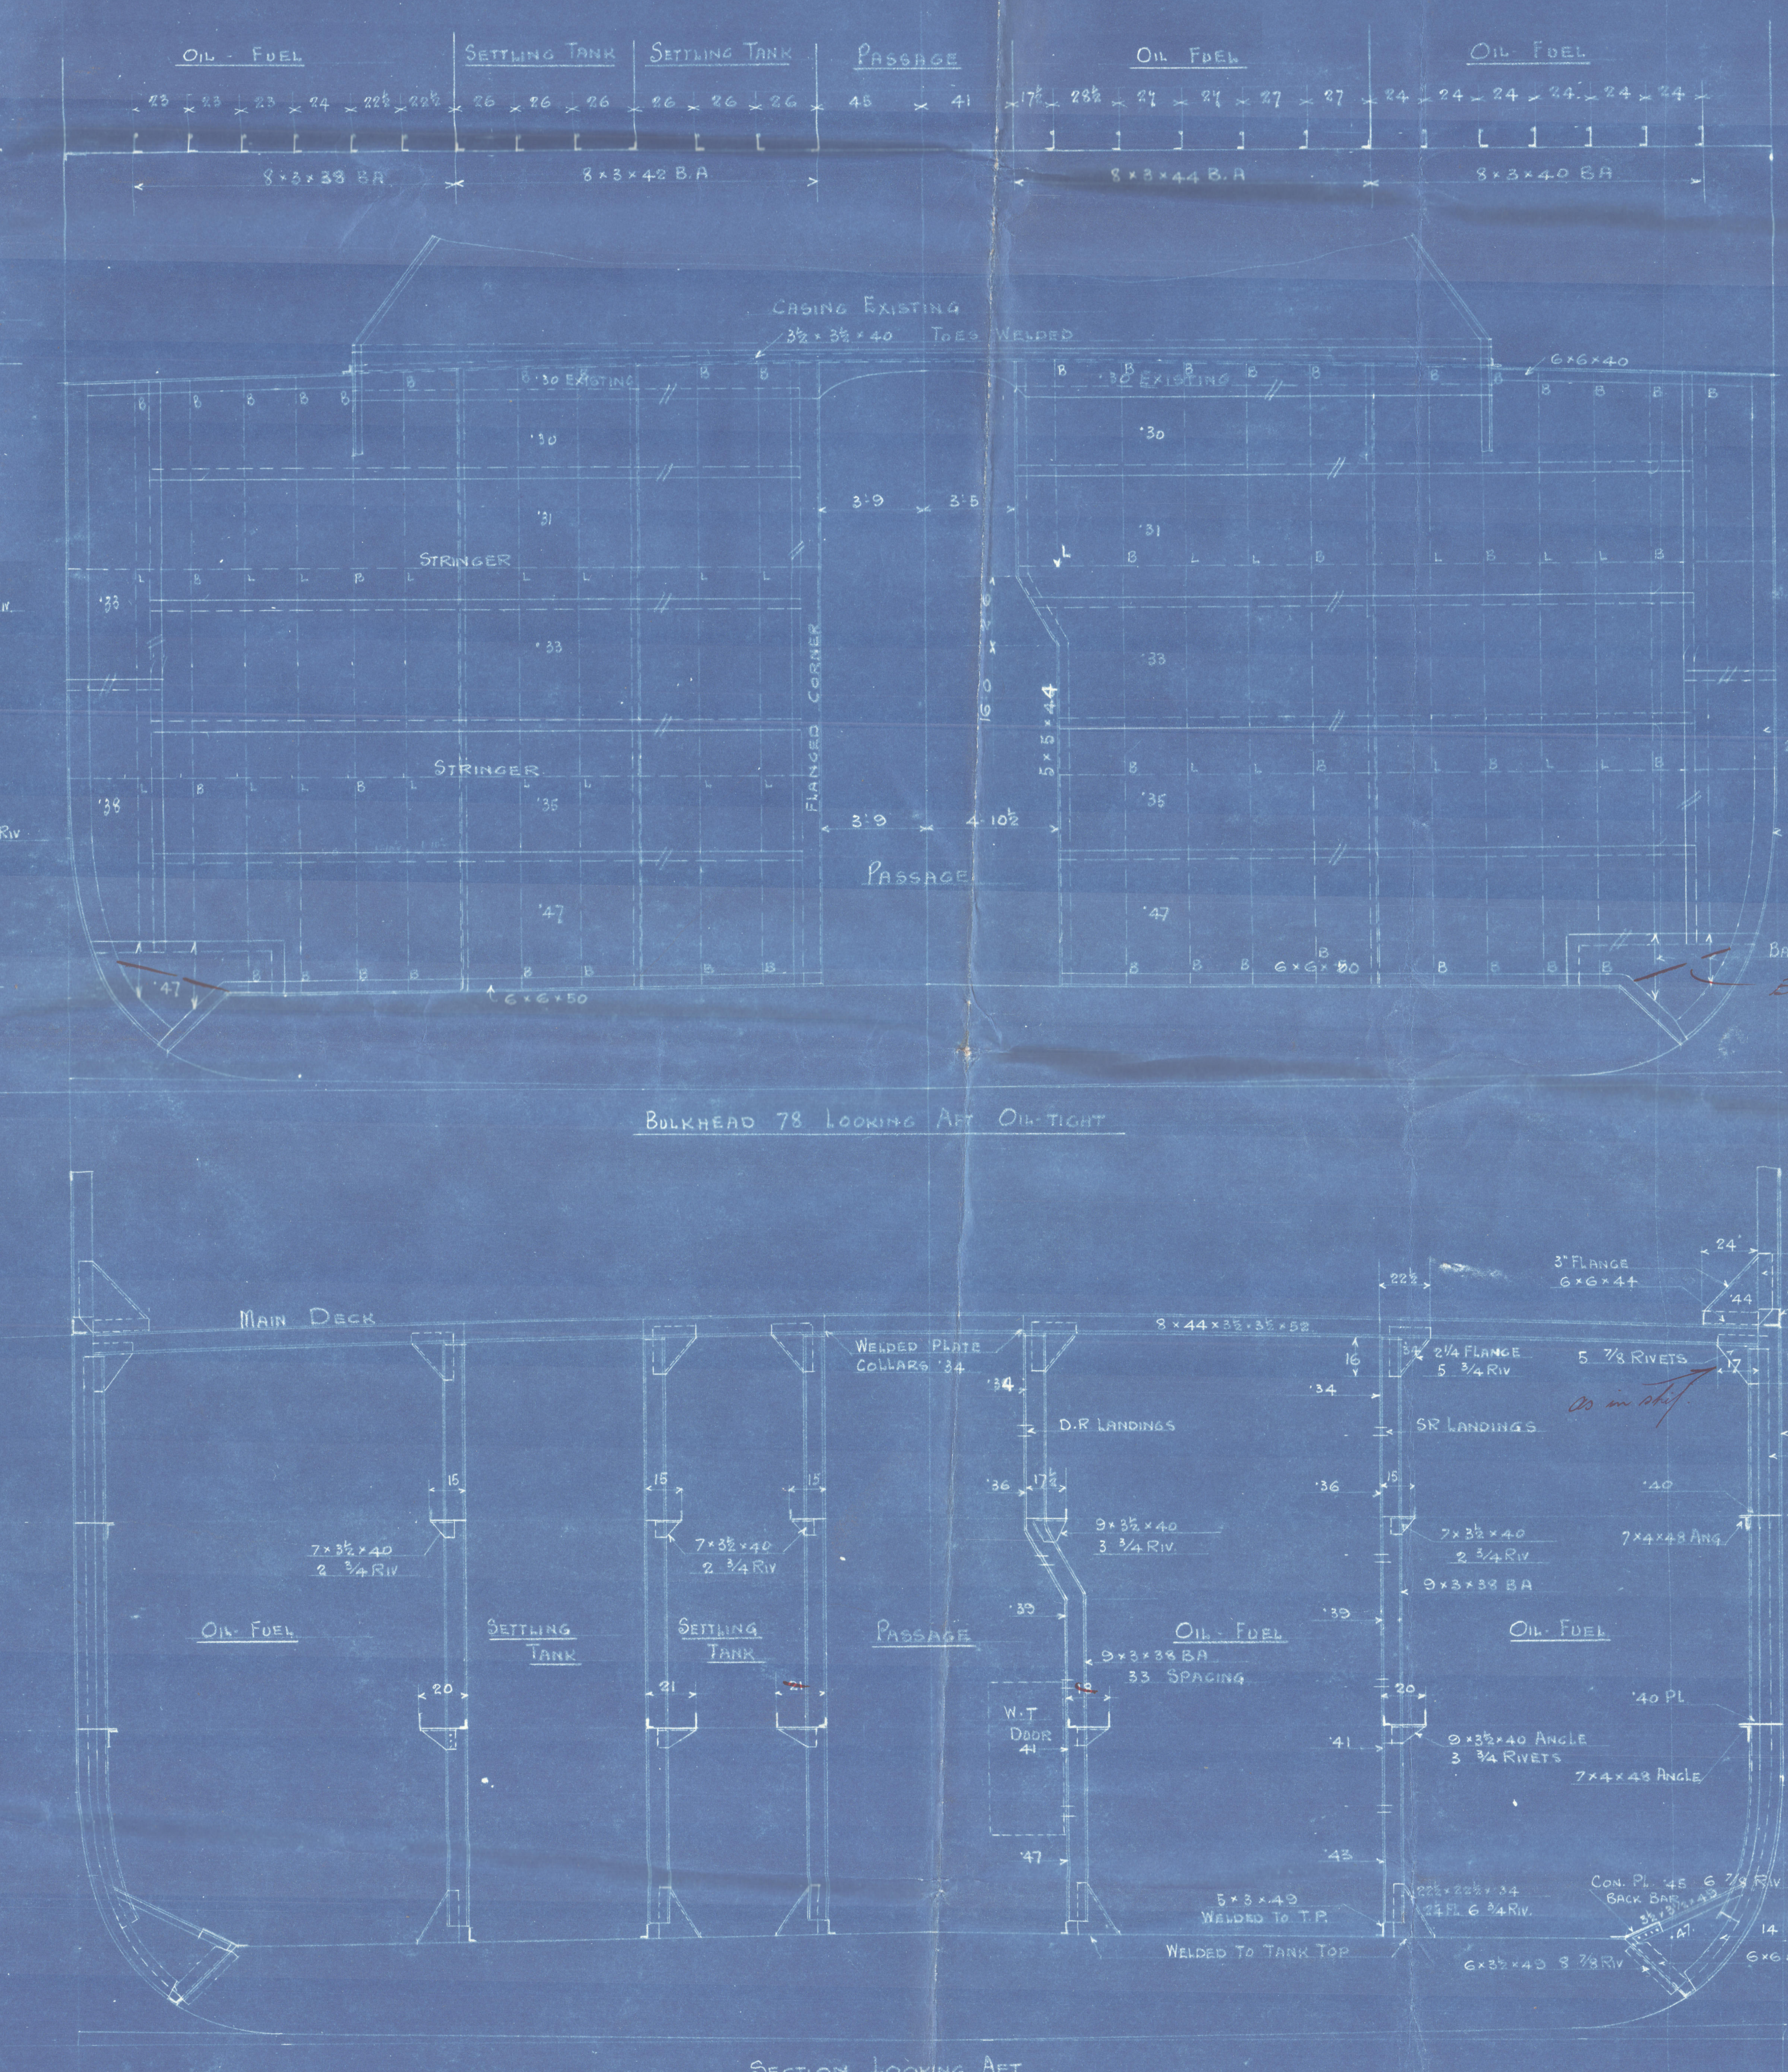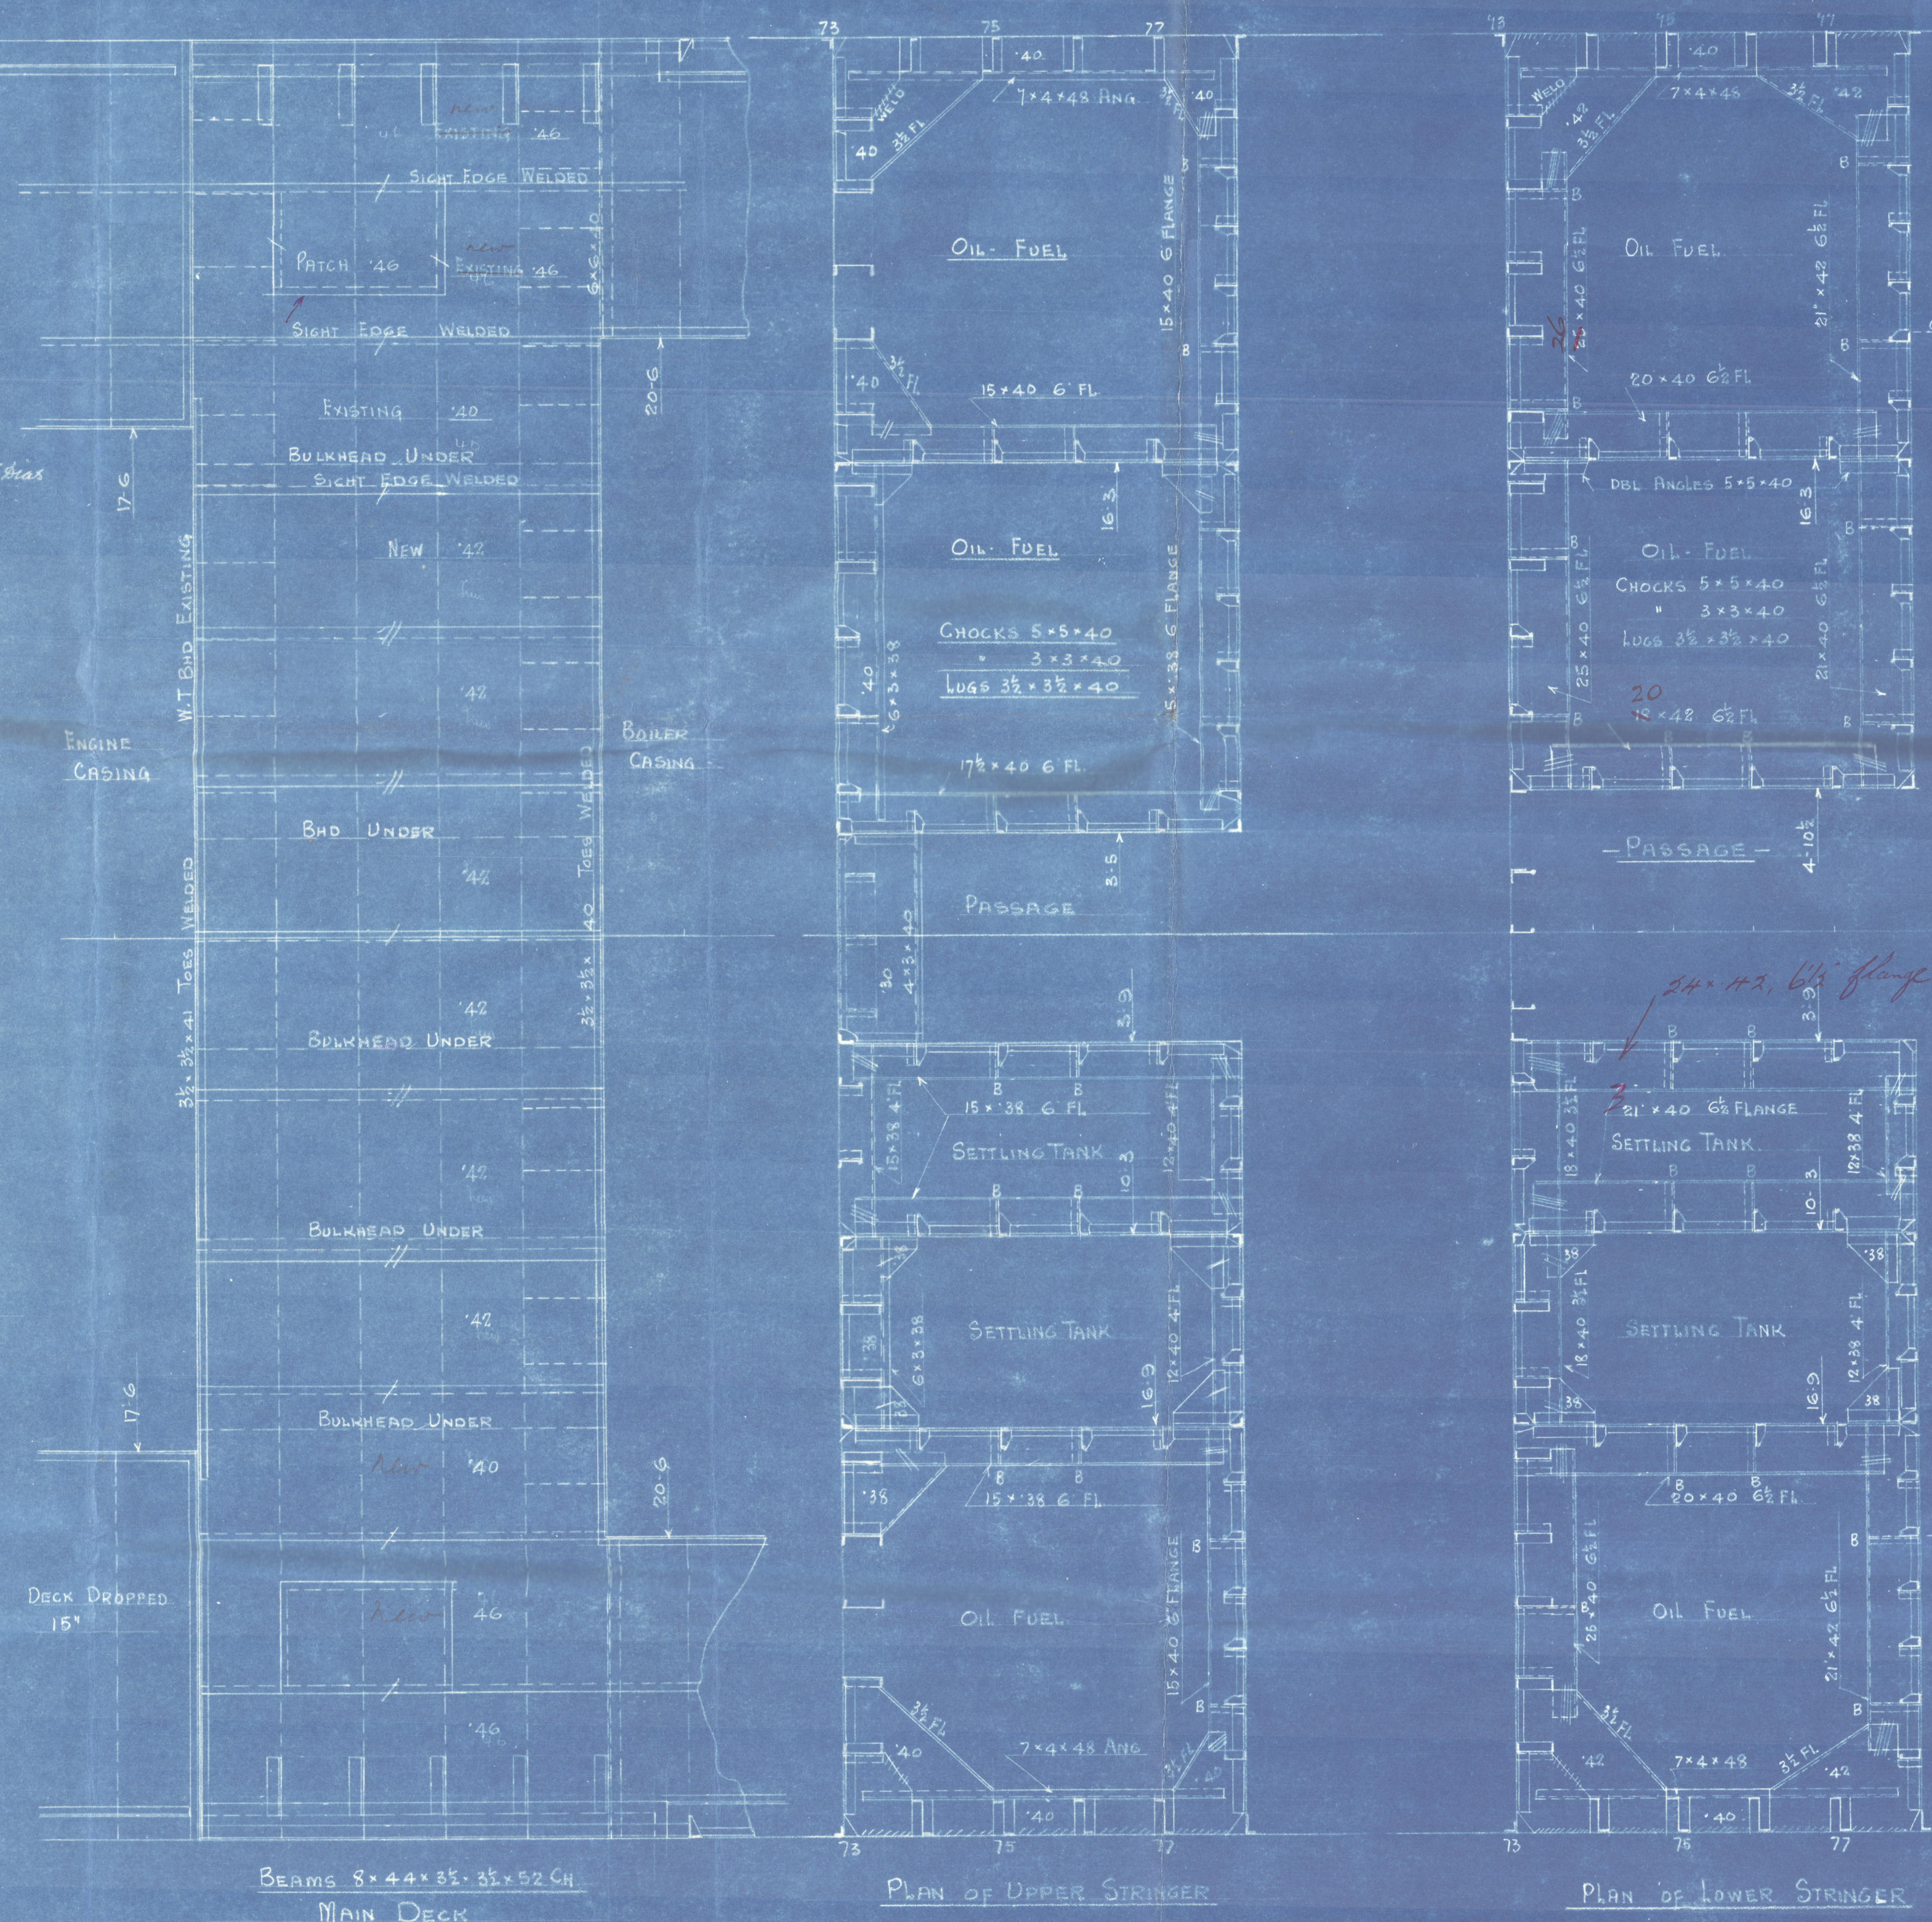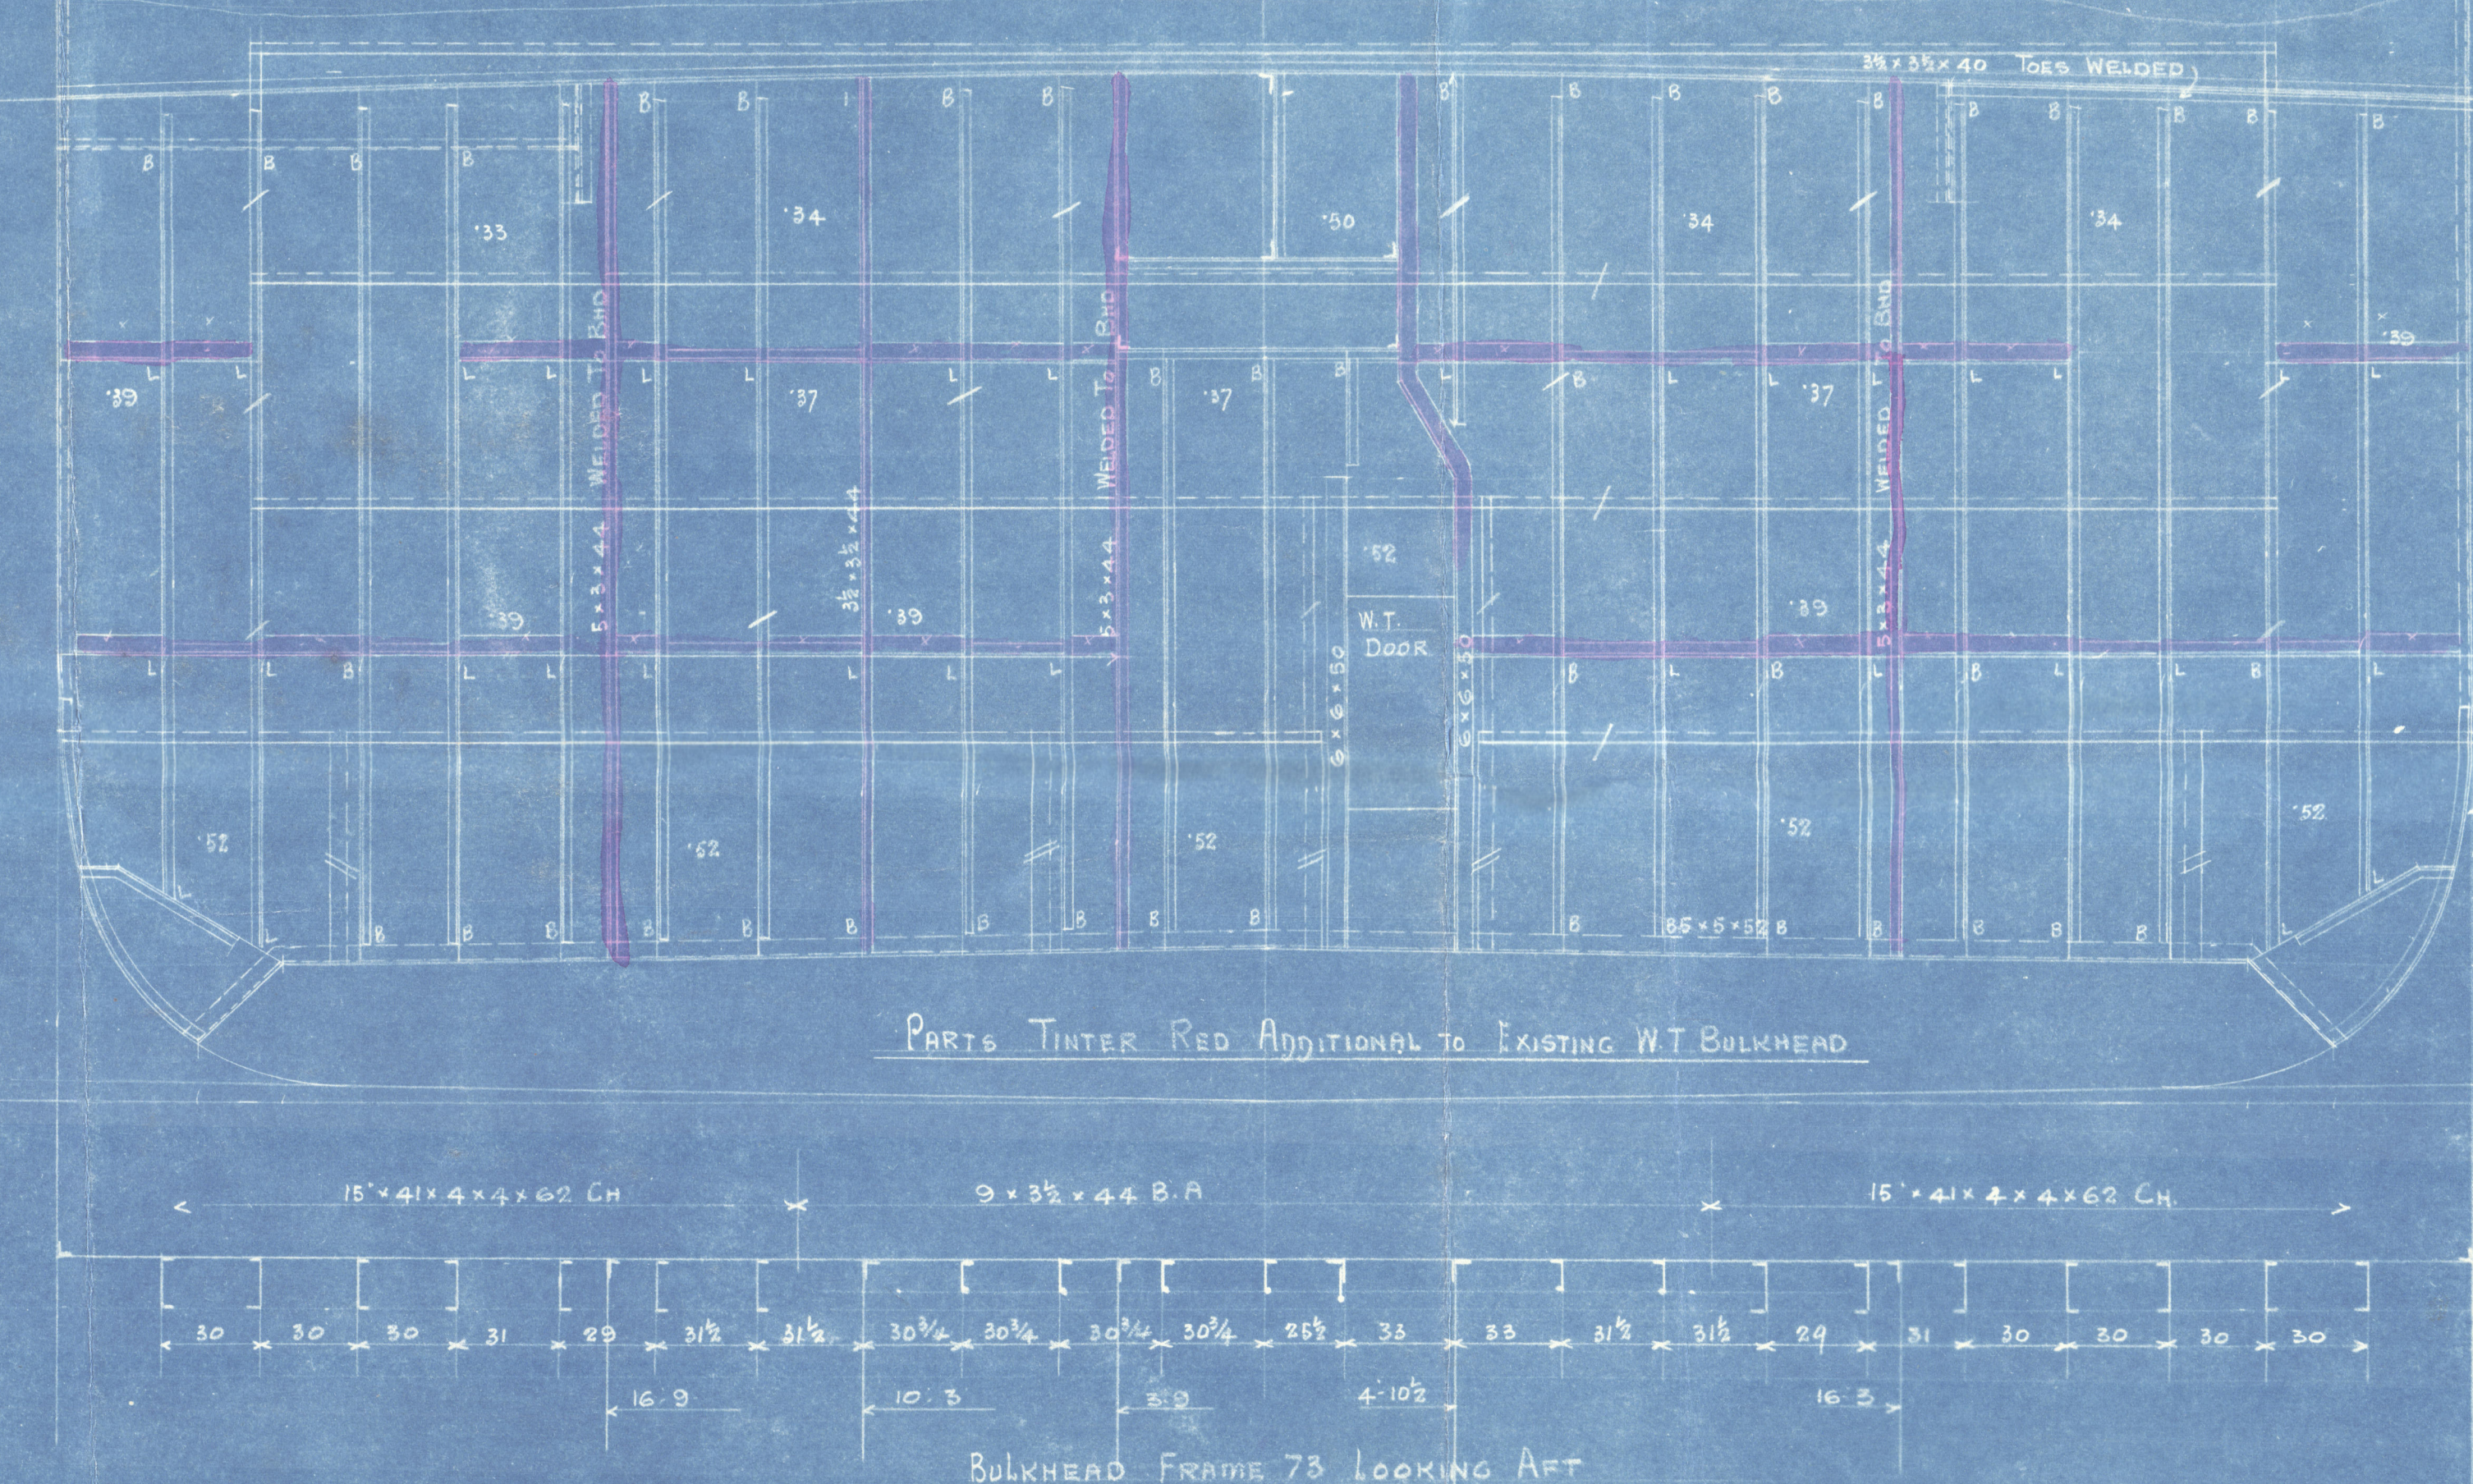

PETER OIL FUEL BUNKERS
LLANDAFF CASTLE

"Llandaff Castle"
Bel Rpt 12394.

After Oil Fuel Bunkers.

W193-0084



© 2021

Lloyd's Register
Foundation