


S. S. "MIRLO."
EXTENSION RINGS FITTED TO

SCALE 2" = 1 FT.

BULB ANGLE STIFFENING RINGS - STARBOARD FURNACE - PORT BOILER.

4 IN N^o DOUBLE RINGS MADE & FITTED.

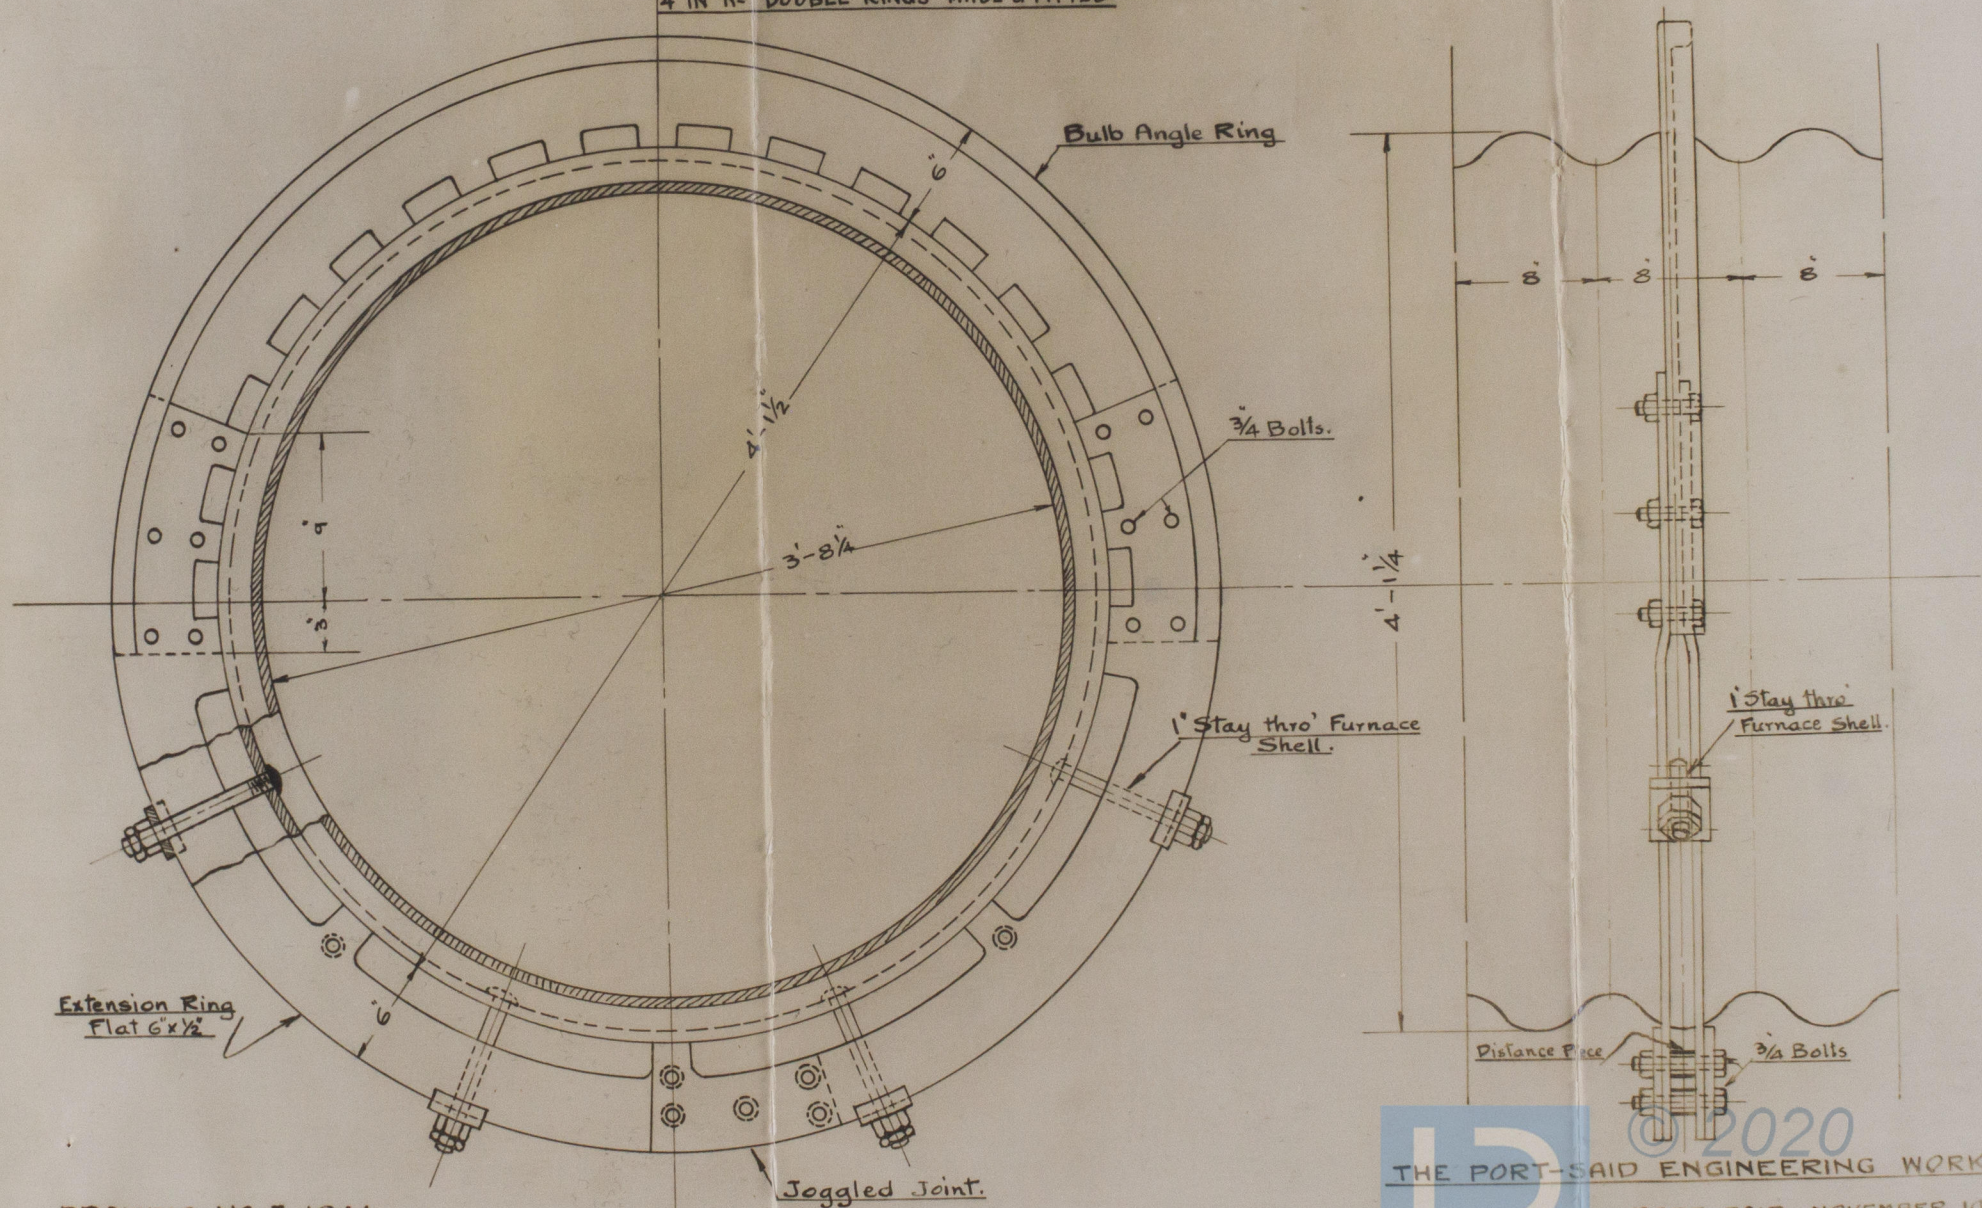

DRAWING N^o J. 1844.

© 2020
 THE PORT-SAID ENGINEERING WORKS.

PORT-SAID, NOVEMBER, 1937.

Lloyd's Register
 Foundation



© 2020

Lloyd's Register
Foundation

W196-0317.2