



Hawthorn Leslie & Co.
P.S. No. 452 + 456
425' x 53' 9 1/2" x 31' 10 1/2" M.M.


Class 104.1. *Scilla* & Co.
Midship Section.

Midship 'PORT ALBANY'



Maritima
No. 62568

5 - FEB. 1913

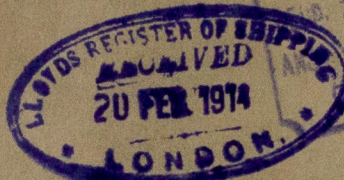

S.W. HAYTHORPE, LONDON
20 JUN. 1912

now
"Maritima"

Clan Graham

S.S. PORT LINCOLN

NEWCASTLE ON TYNE

REPORT No. 62568

@ Port Macquarie

S.S. PORT MACQUARIE









NEWCASTLE ON TYNE

REPORT No. 62980


S.S. "PORT ALBANY"

NEWCASTLE ON TYNE

REPORT No. 66207

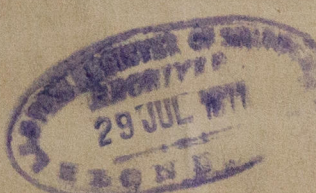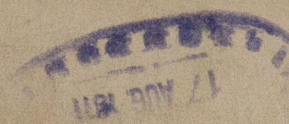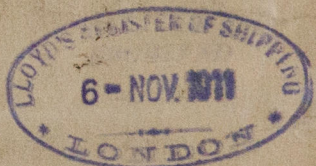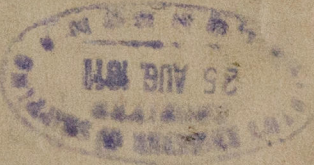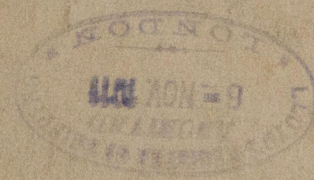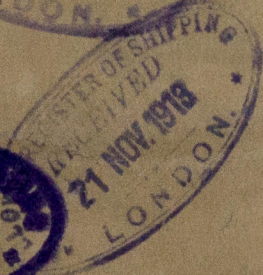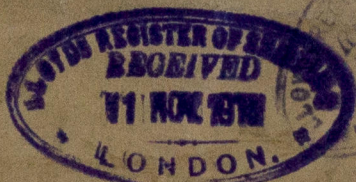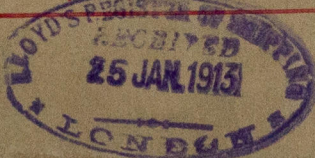

SAT MAY 9 - 1914

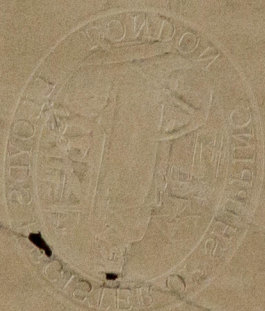

W/197-0011



© 2019

Lloyd's Register
Foundation
G. HALDEN & CO. LTD