


C. D. Holmes also
recommended plan for Nos 1108 & 9

W.P. 200lbs

4/12/15




S.S. "Cibacora" Hull No. 29498
S.S. "Paraday" ~~29526~~

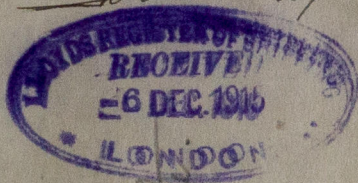

1108
No 3147
Lloyds test
400lbs
10-7-16 FLS

1109
No 3153
Lloyds test
400lbs
1-8-16 FLS

To be returned for duplicate

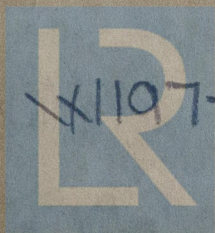


© 2019

0082

Lloyd's Register
Foundation