






— S.S. THORDIS —

Profile & Section Plan  
of vessel as built

Moore & Scott Iron Works  
No 110.

Now named "Mound-Parnes."

S.Fo.2476.

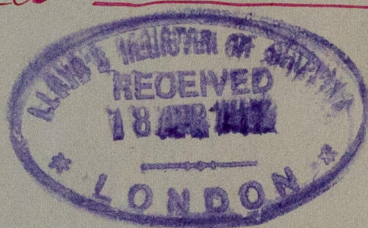

X1197-0183



© 2019

Lloyd's Register  
Foundation