

Commercial Boiler Workers

Call.

W197-0184



© 2019


Lloyd's Register
Foundation

"Thordis"
Copy of Approved plan
of Main boilers as fitted
to Russos Moore & Scott SS N° 116


Seattle Rpl. N°

S. 40 Rpl. N° 2476

Mount Pines

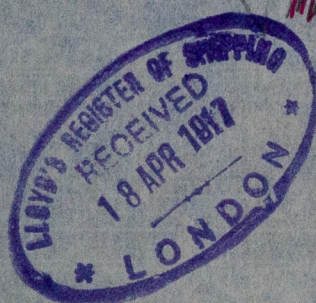

X1197-0184

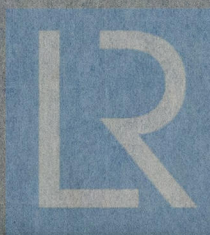

© 2019

Lloyd's Register
Foundation