

LLOYDS NUMERALS

MIDSHIP SECTION

N° 162

PRINCIPAL DIMENSIONS

LENGTH B.P. 348-0
BREADTH EXT 50-0
DEPTH M.D. 25-8

CLASS 100 A.1

SCALE 2" = 1 FOOT

SHEER FORWARD 8-0
" AFT 3-9
" 1/2 L FOR 4-5
" AFT 2-1

ERECTOR'S


EQUIPMENT	FREEBOARD
POOP	27-08
BRIDGE	100-00
FORCILE	36-25
TOTAL	163-33
	165-16

SALOON HOUSE = 18x7
ENGINEERS = 24x7

1/2 GIRTH	47-72
1/2 BEAM	24-90
DEPTH	26-68
1ST NUMBER 2 DECK RULE	99-30
LENGTH	346-66
2ND NUMBER	344-23-34
DEPTHS TO LENGTH	12-99
UNDER DECK TONNAGE	3330
EQUIPMENT NUMBER	36432
1ST NUMBER 3D RULE	92-30
2ND NUMBER	346-66
	31996-70

	POOP	BRIDGE	FORECASTLE
SIDE PLATING	7/20	11/20 + 10/20	8/20
STRINGER PLATE	34 x 8/20	48 x 10/20	34 x 8/20
ANGLE	4 x 4 x 8/20	4 1/2 x 4 1/2 x 11/20	4 x 4 x 8/20
DECK PLATING	5/16 IRON	9/16 IRON	9/20 UNDER WINDLASS
TIES			18 x 9/20
BEAMS	6 1/2 x 3 x 8/20 B.A.	7 x 3 1/2 x 10/20 B.A.	BULB 10 x 10/20
GIRDERS	5 x 4 x 11/20	5 x 4 x 12/20	ANGLES 3 1/2 x 3 1/2 x 7/20
PILLARS	2 1/8 DIA	2 1/8 DIA	

IRON DECK 8/16 BUTTS DOUBLE RIV

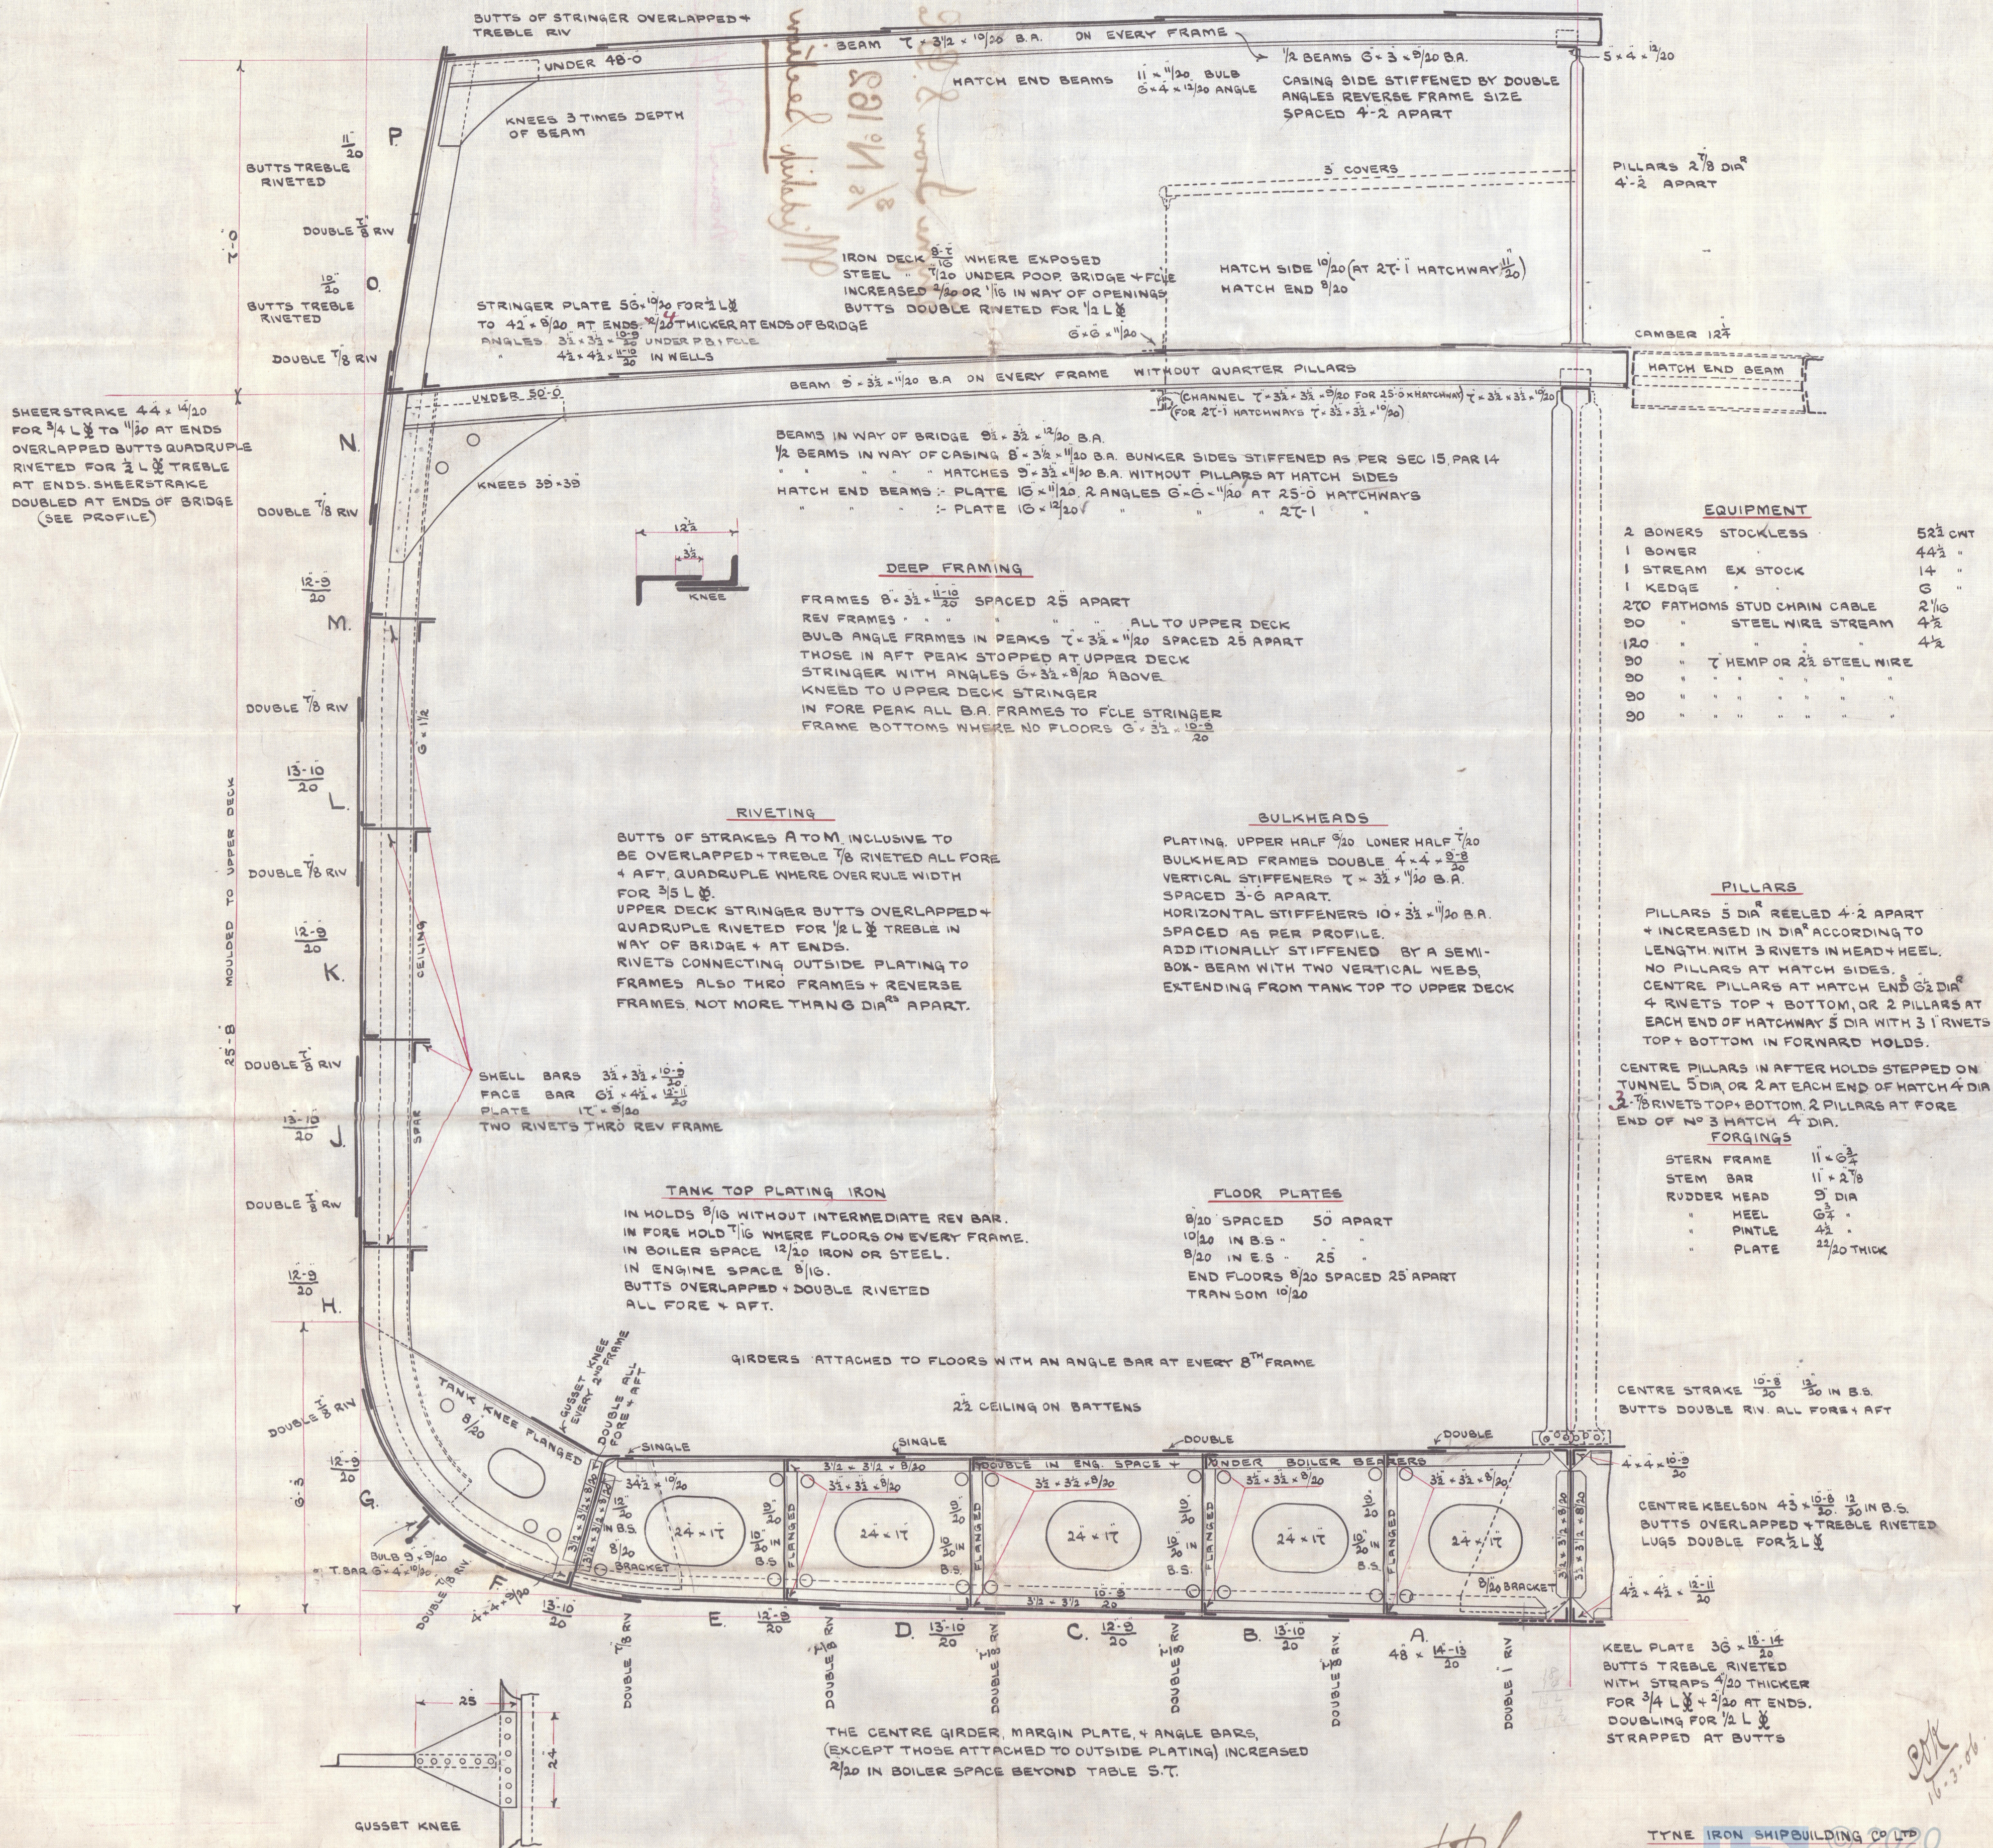

TYNE IRON SHIPBUILDING CO. LTD
WILLINGTON-QUAY-ON-TYNE

TRACING N° 164 T 15/3/06

W198-0157

"Mount Mycale"

No 162.

52345

18

© 2020

Lloyd's Register
Foundation