


4. 8. 14 (No. 255)

SCALE $\frac{1}{2}'' = \text{ONE FOOT}$

TO CLASS 100A FOR TOWING PURPOSES

107 FT X 23 FT X 12'-6" MLD

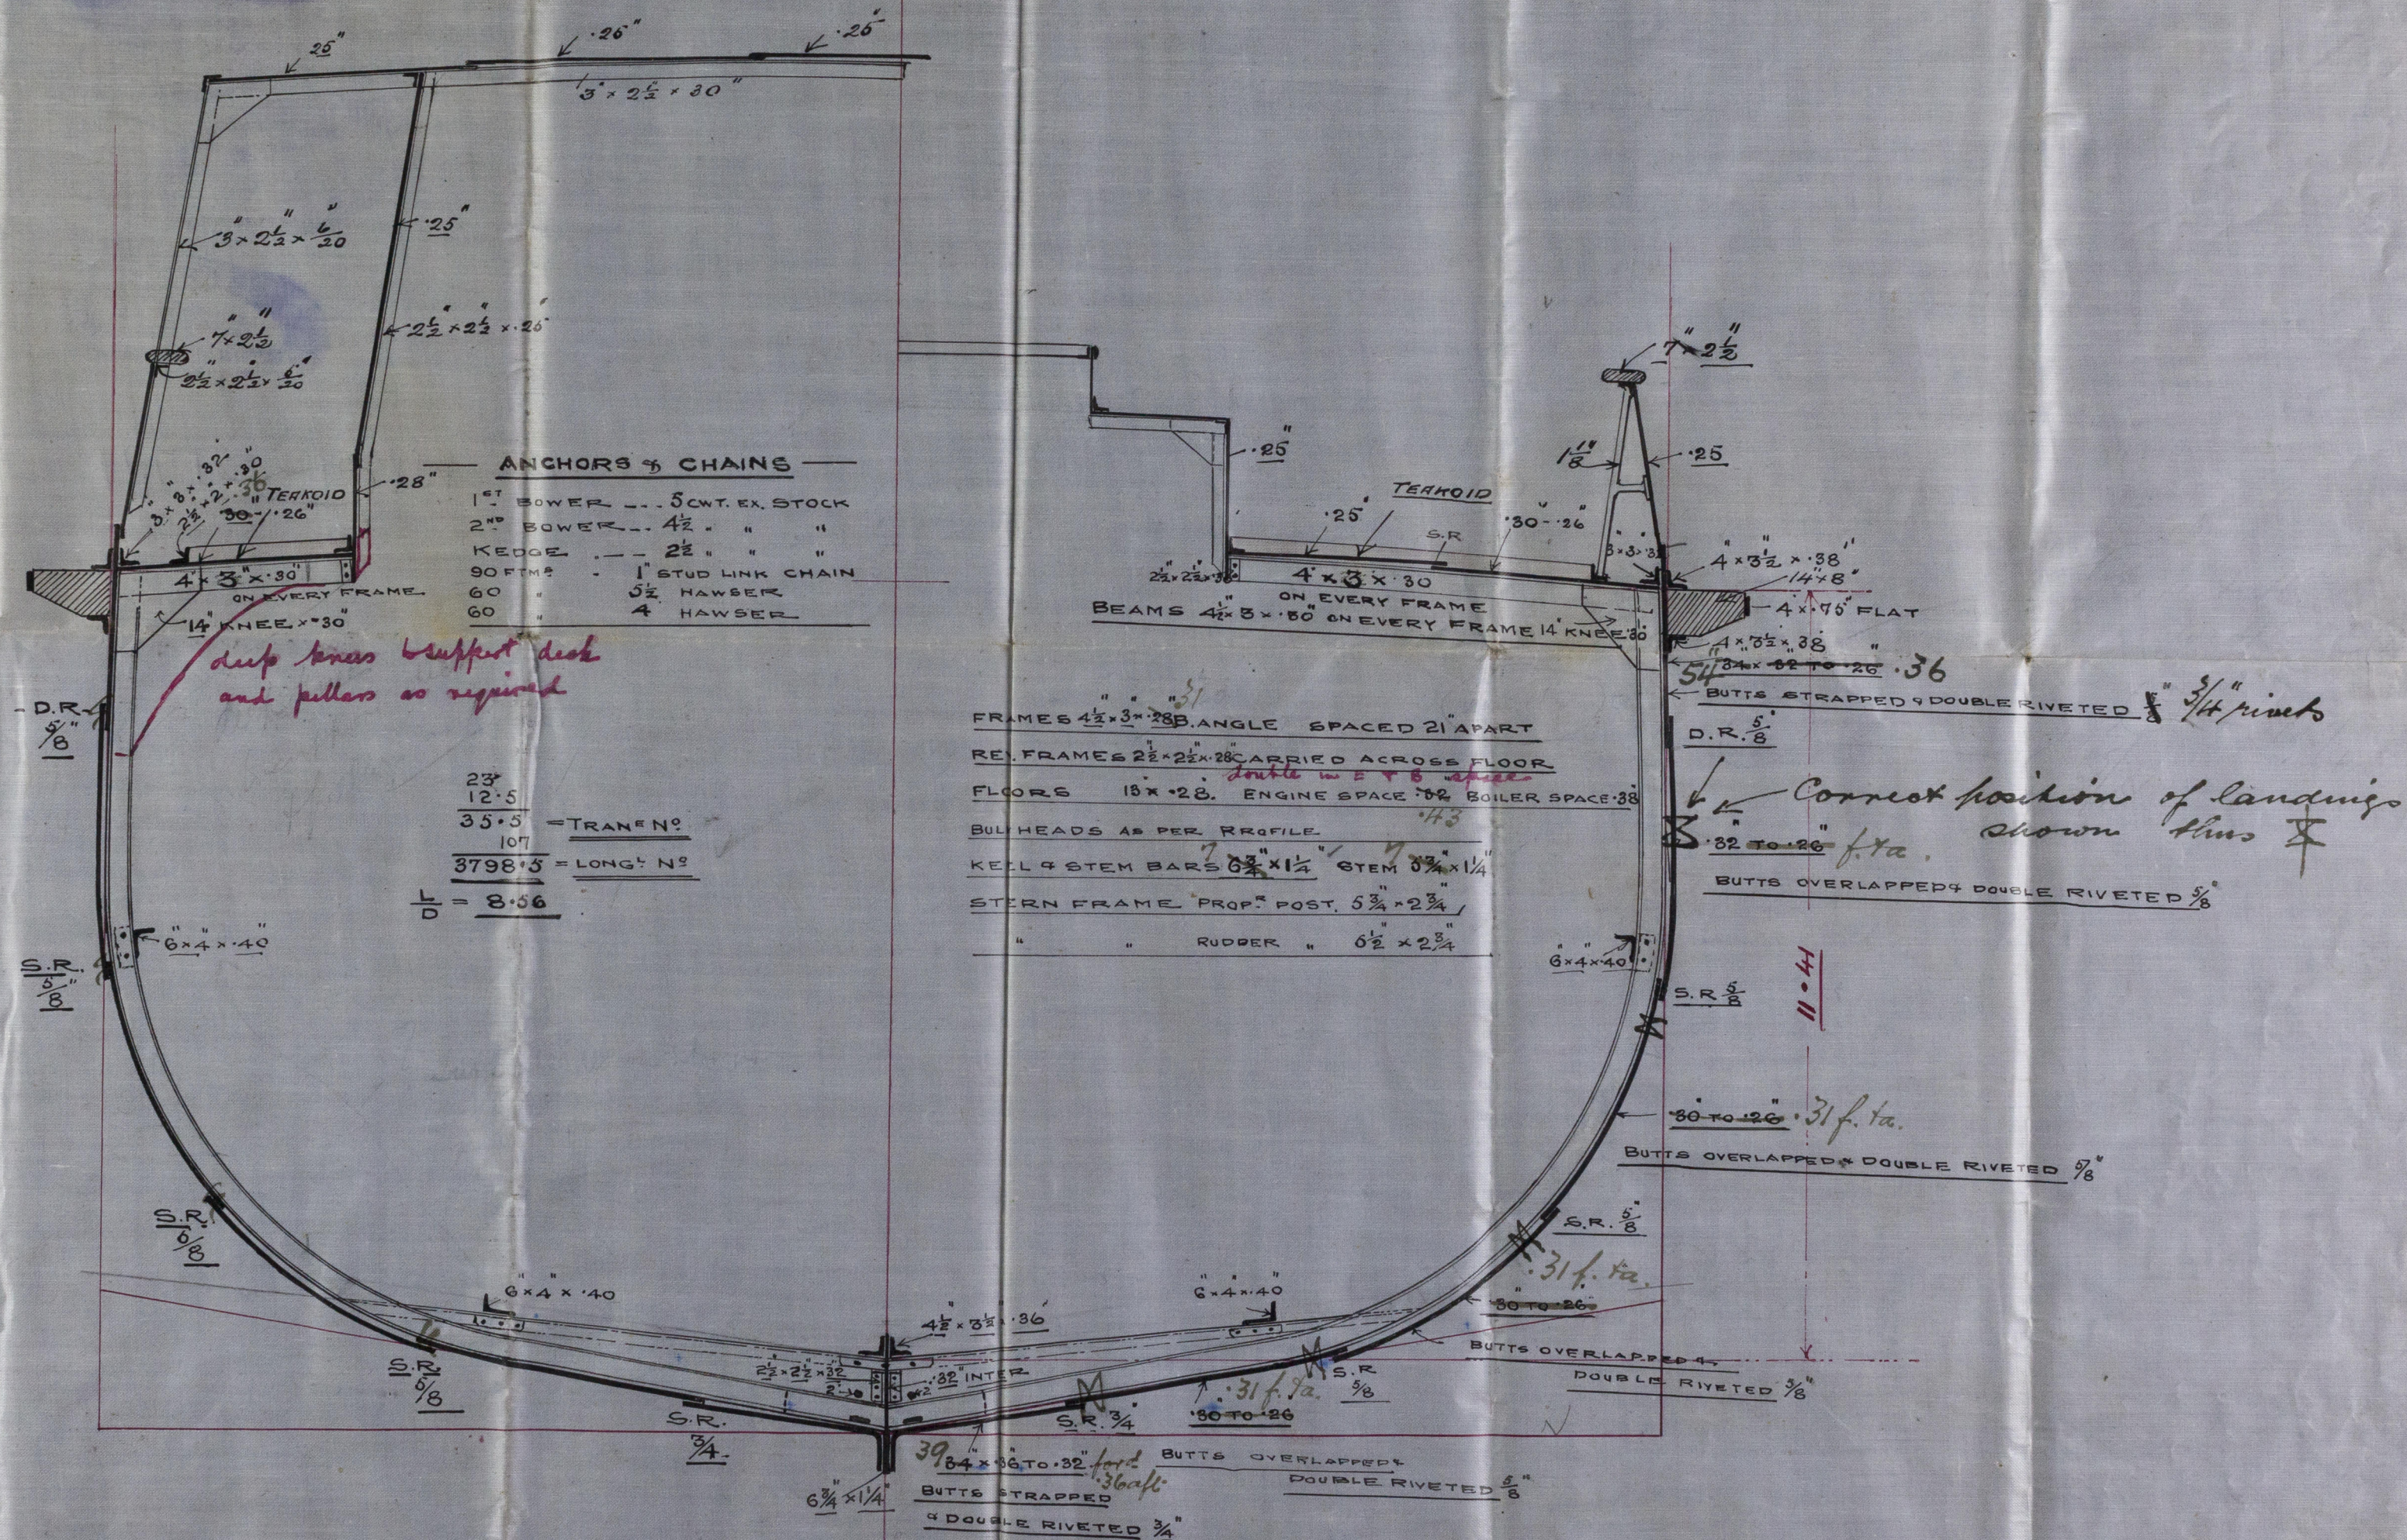

C. J.
2.1.14.

4. 8. 14

W198-0174

Scott Irons

HP 255 + 258

Midship Section

"Wrestler"

GLASGOW REPORT No. 34231.

"Muria" ex


258 "Wrestler"

GLASGOW REPORT No. 35085

"Muria"



R. Sect
No 61

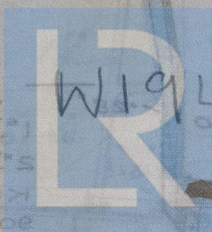

© 2020

W194 - 0174

Lloyd's Register
Foundation