

20-1-14


4. 8. 14 (No. 255)

# STEEL SCREW TUG No 255

107 FT X 23 FT X 12 FT - 6 INS. MLD.

SCALE 1/4" = ONE FOOT

TO CLASS 100A.1 FOR TOWING PURPOSES.

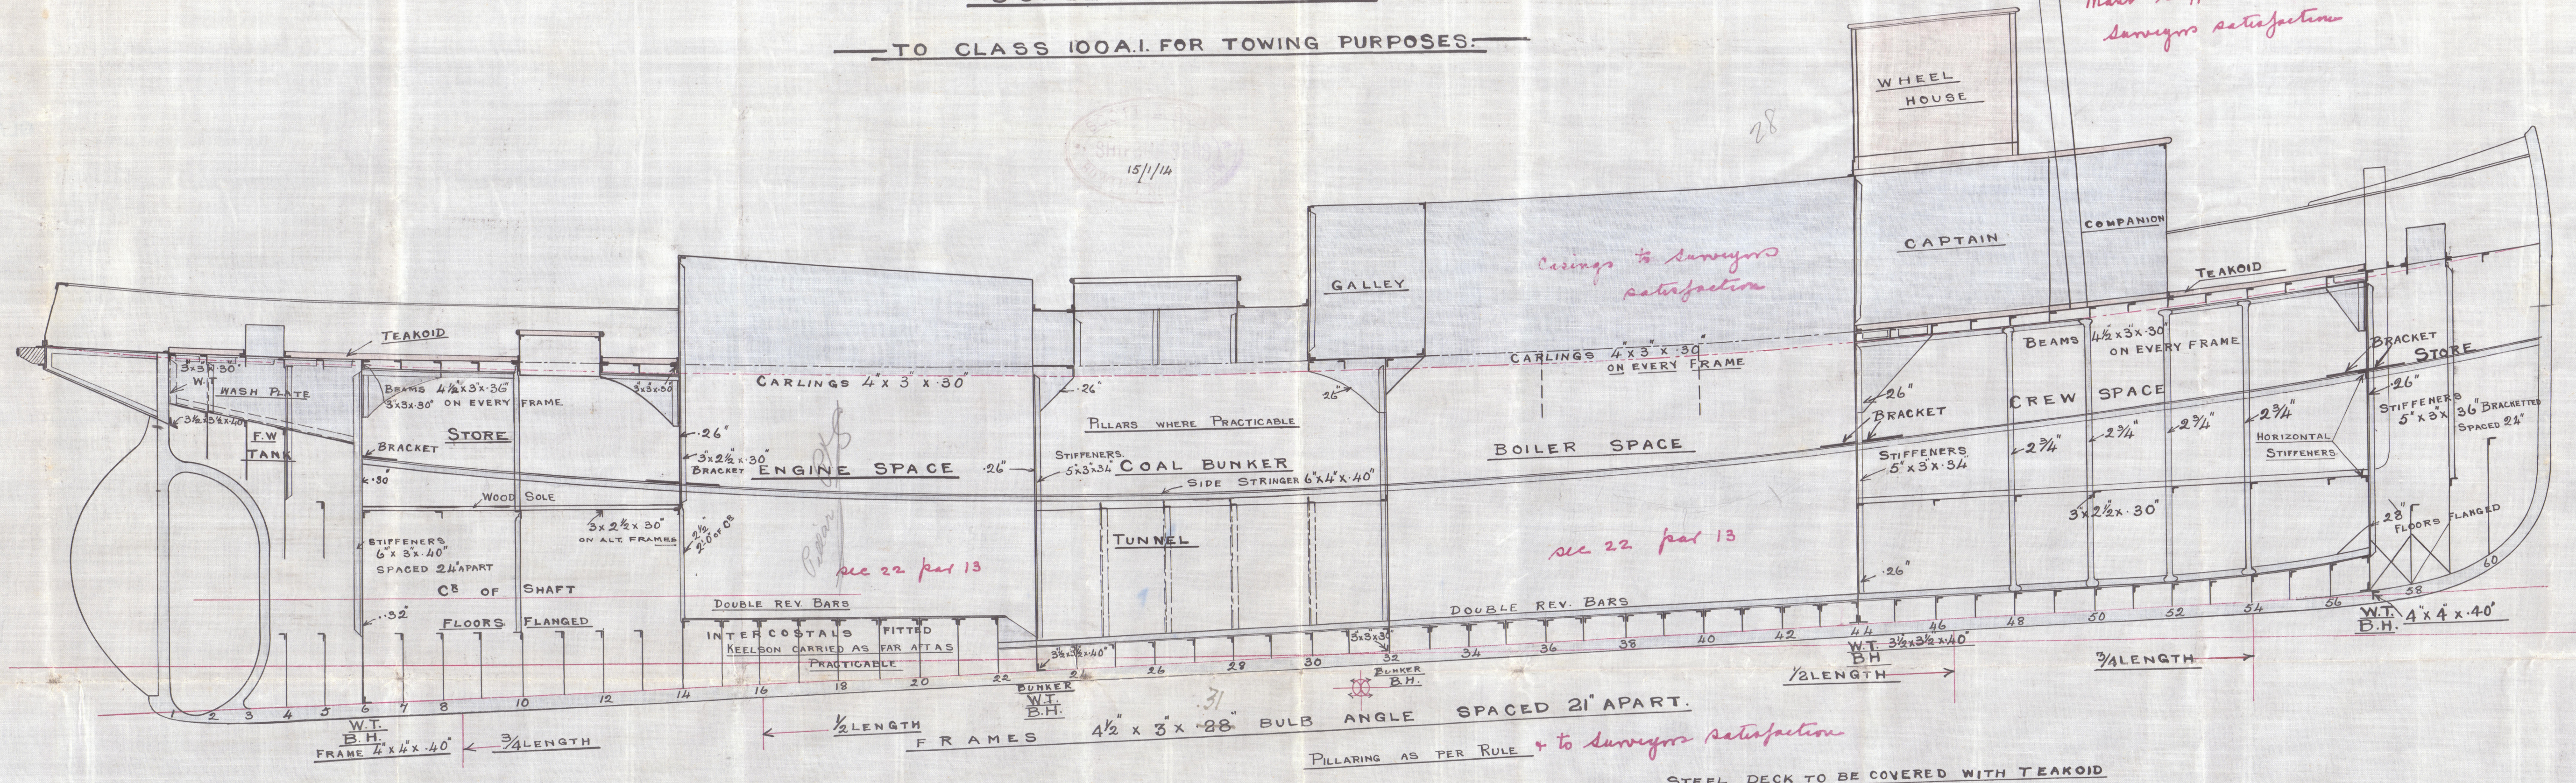

Most supported to  
Surveyors satisfaction


Casings to Surveyors  
satisfaction

see 22 part 13

PILLARING AS PER RULE + to Surveyors satisfaction

STEEL DECK TO BE COVERED WITH TEAKOID

## DECK PLAN

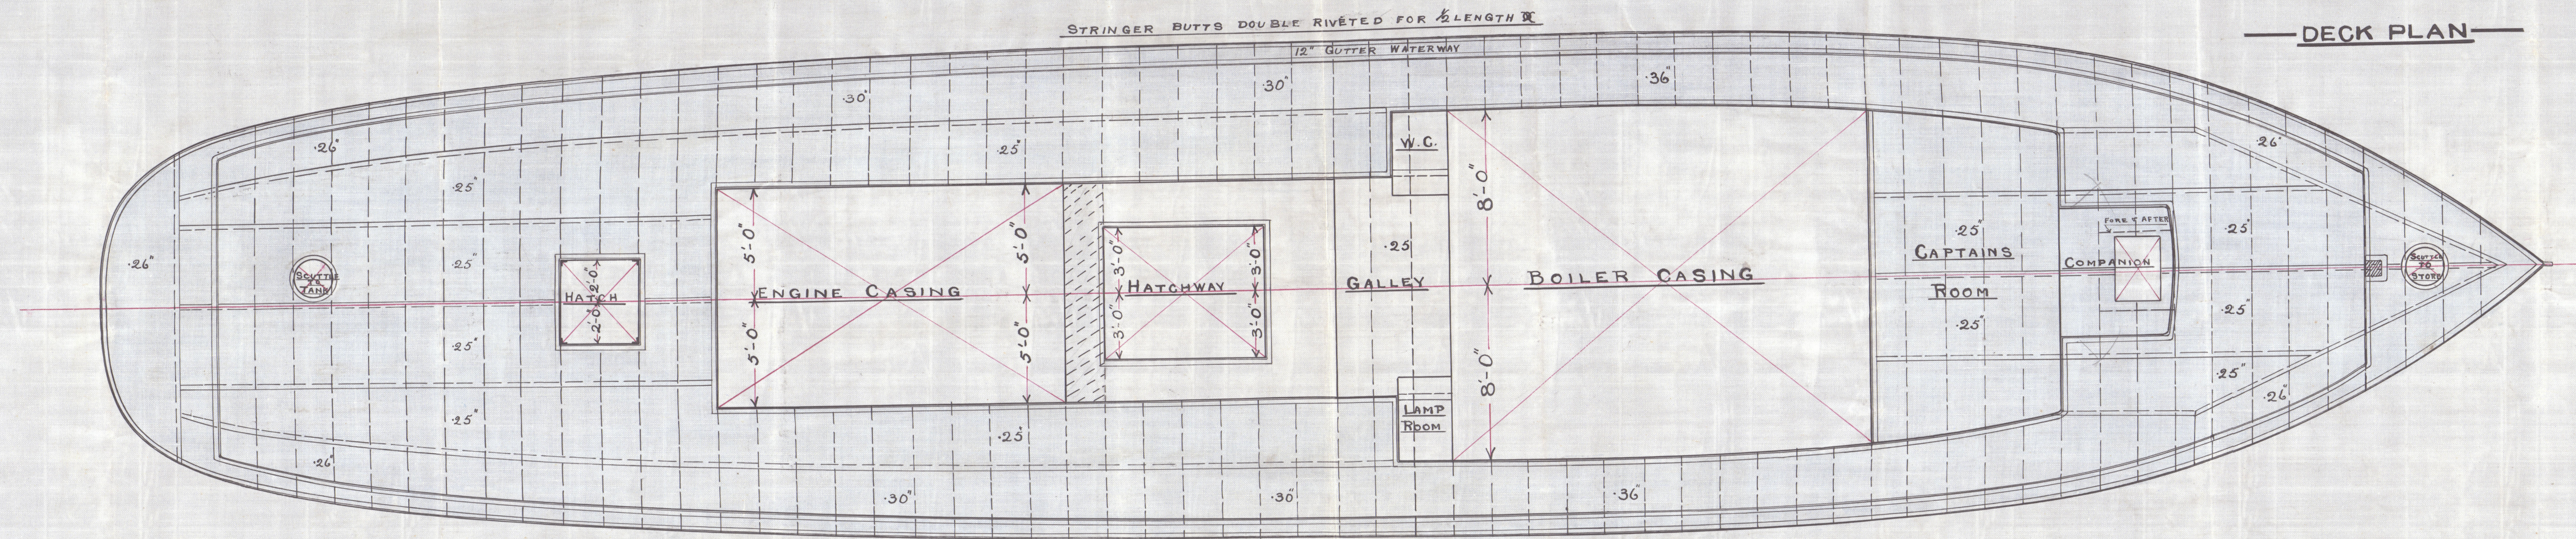

C.F.  
20-1-14  
4-8-14



Scott Bond 258  
amended profile  
deck plan

"Wrestler"

GLASGOW REPORT No. 34231

N.N. "Munia"

258 "Wrestler"

GLASGOW REPORT No. 35085

R. Sect  
No 61.



© 2020

Lloyd's Register  
Foundation