
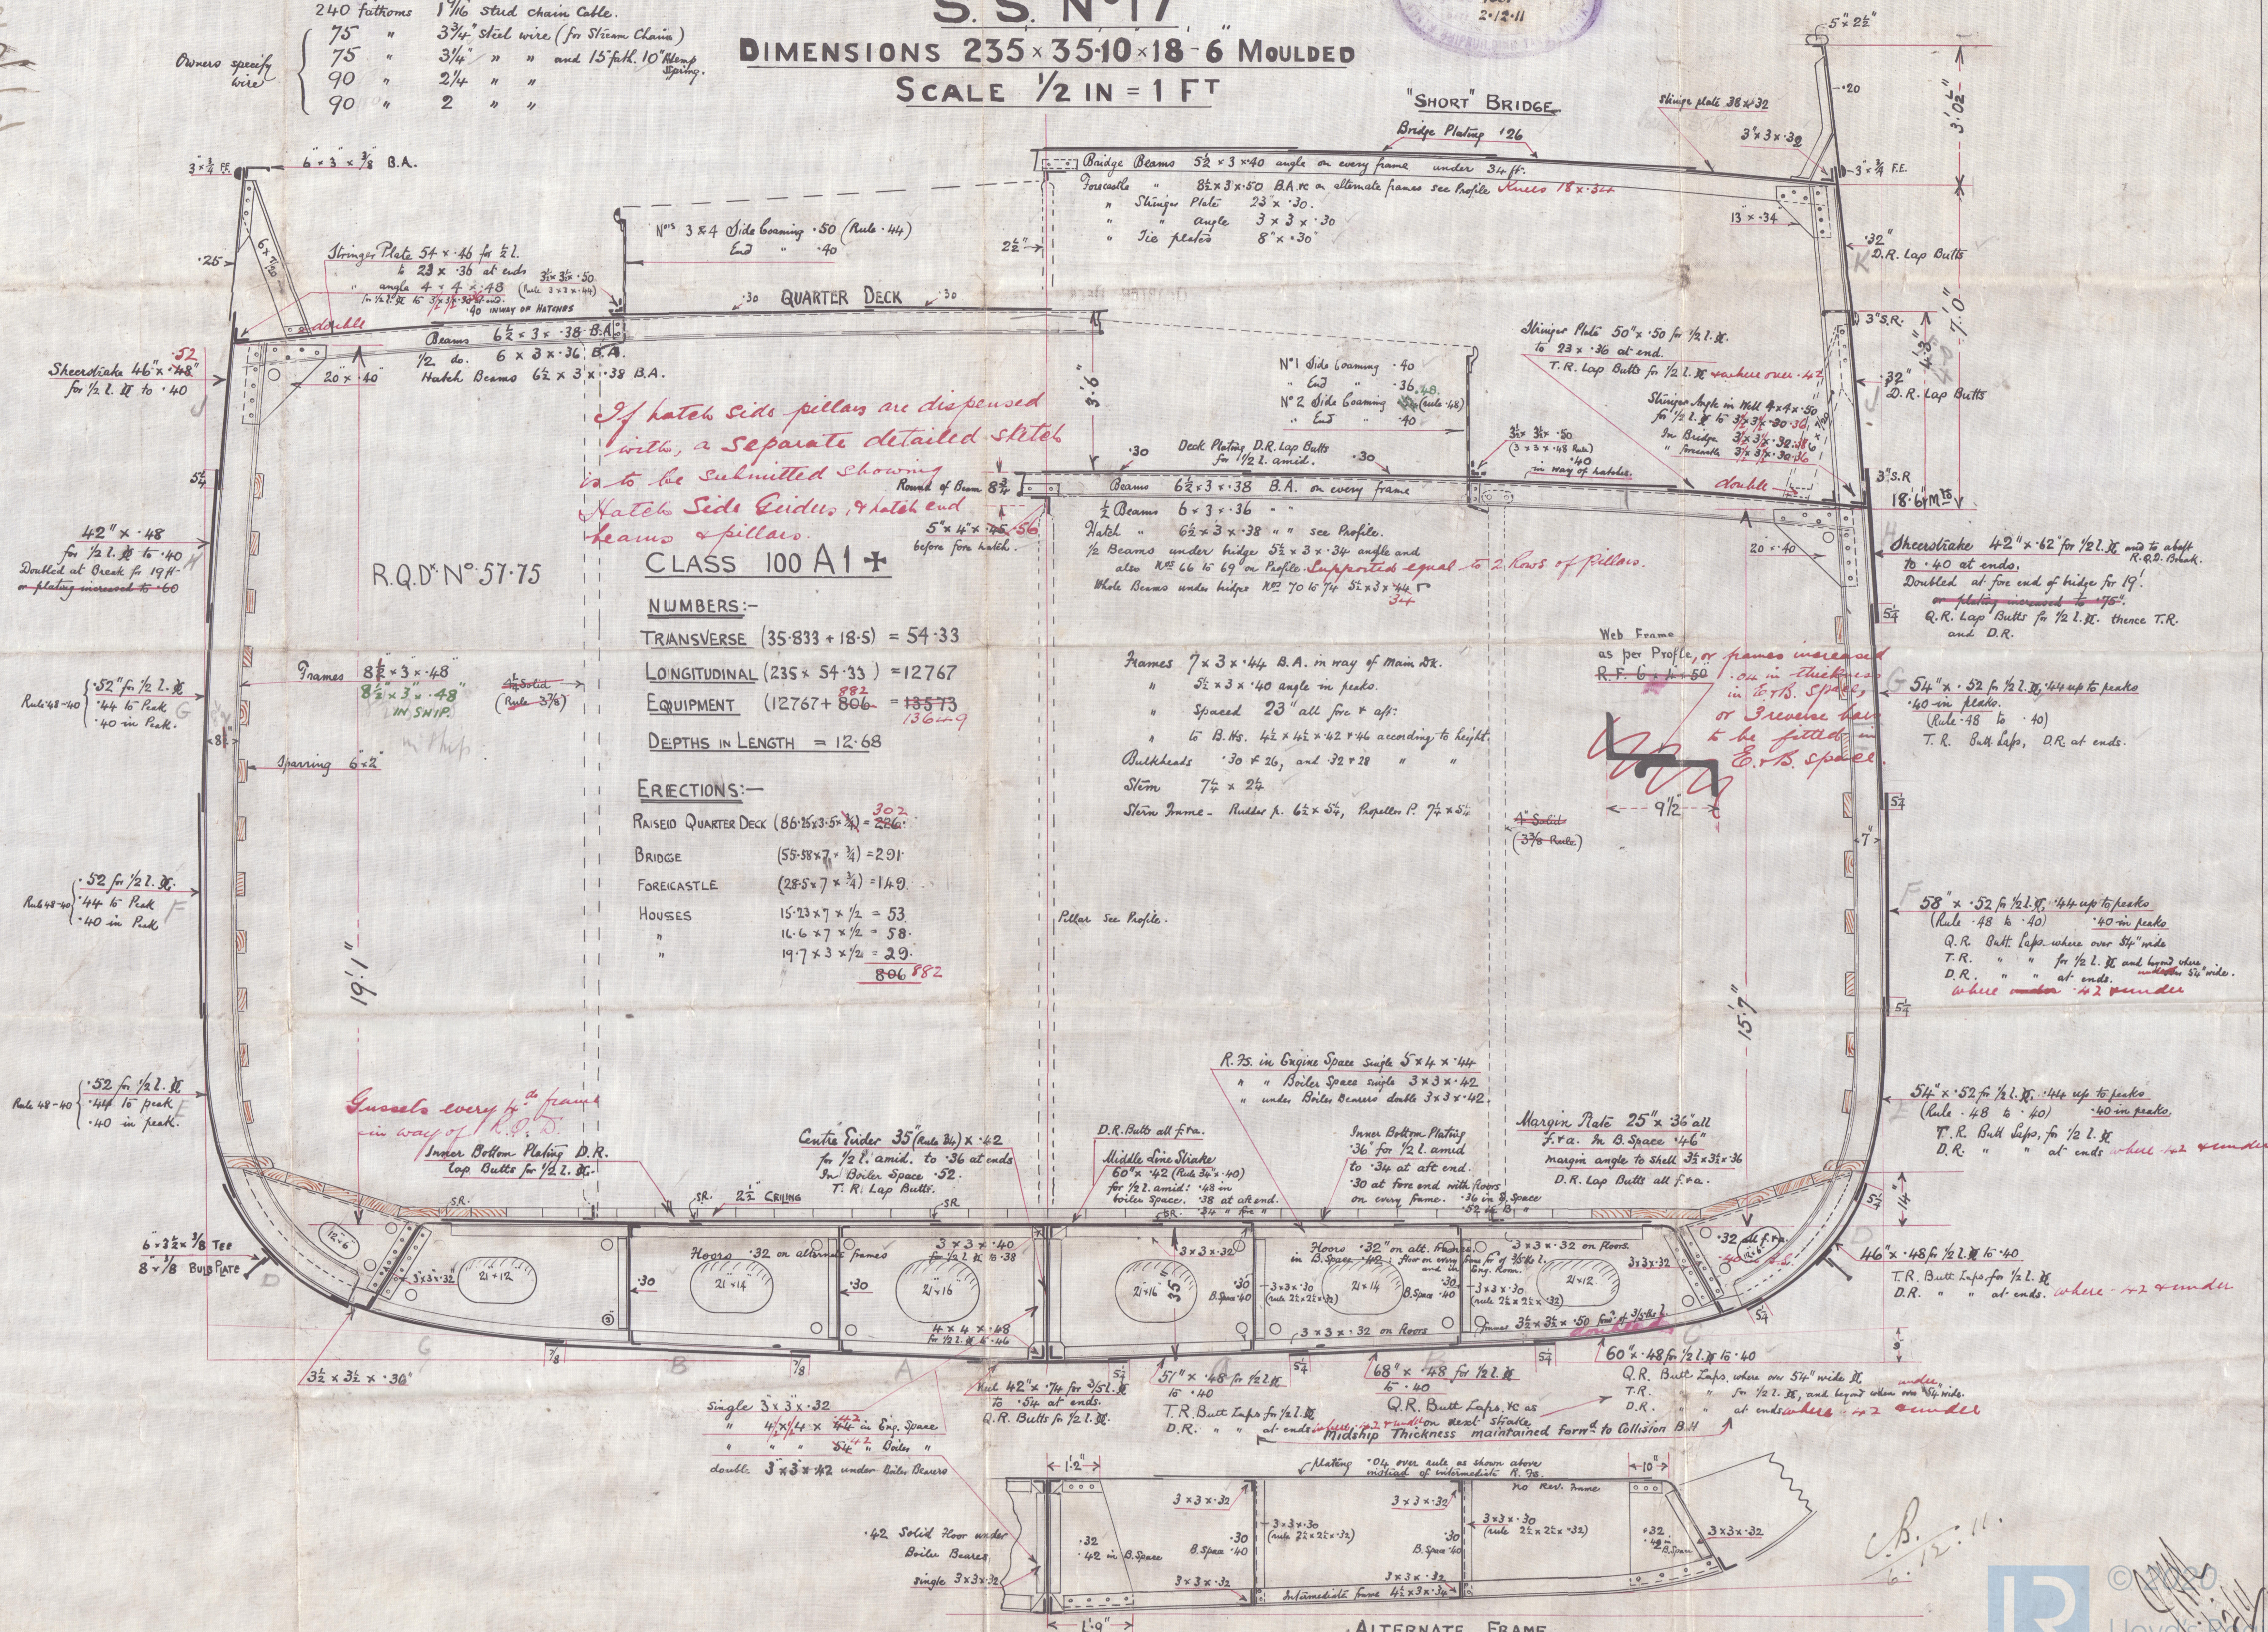


<u>Equipment</u>		
1 <sup>st</sup>	Bower Anchor	28 cuts Stockless
2 <sup>nd</sup>	" "	" " "
3 <sup>rd</sup>	" "	24 " "
1	Stream "	7 " 6x. Stock.
1	Kedge "	4 " " "
240	fathoms	1 1/2" Steel Chain Cable.
Owners specify wire	{	75 " 3 3/4" Steel wire (for Stream Chain)
		75 " 3/4" " " and 15 fath. 10" Kloop Spring.
		90 " 2 1/4" " "
		90 " 2 " "

S. S. N°17

SCALE  $\frac{1}{2}$  IN = 1 FT

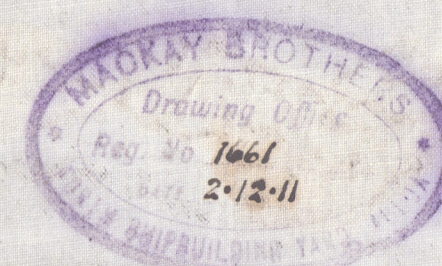

## • ALTERNATE FRAME

W198-0224



No 14

Midship Action

Messrs Mackay Bros  
Alloa

S.S. "Nestor"

Moncoussu

Lth. 13772



© 2020

Lloyd's Register  
Foundation

W198-0224