


6.12.11  
2.1.12  
10.1.12  
25.1.12  
27.2.12

# LONGITUDINAL AND DECK PLAN. S.S. No 17. DIMENSIONS:- 235'-0" x 35'-10" x 18'-6". SCALE $\frac{1}{8}$ " = 1 FOOT.



C.D.  
6.12.11.

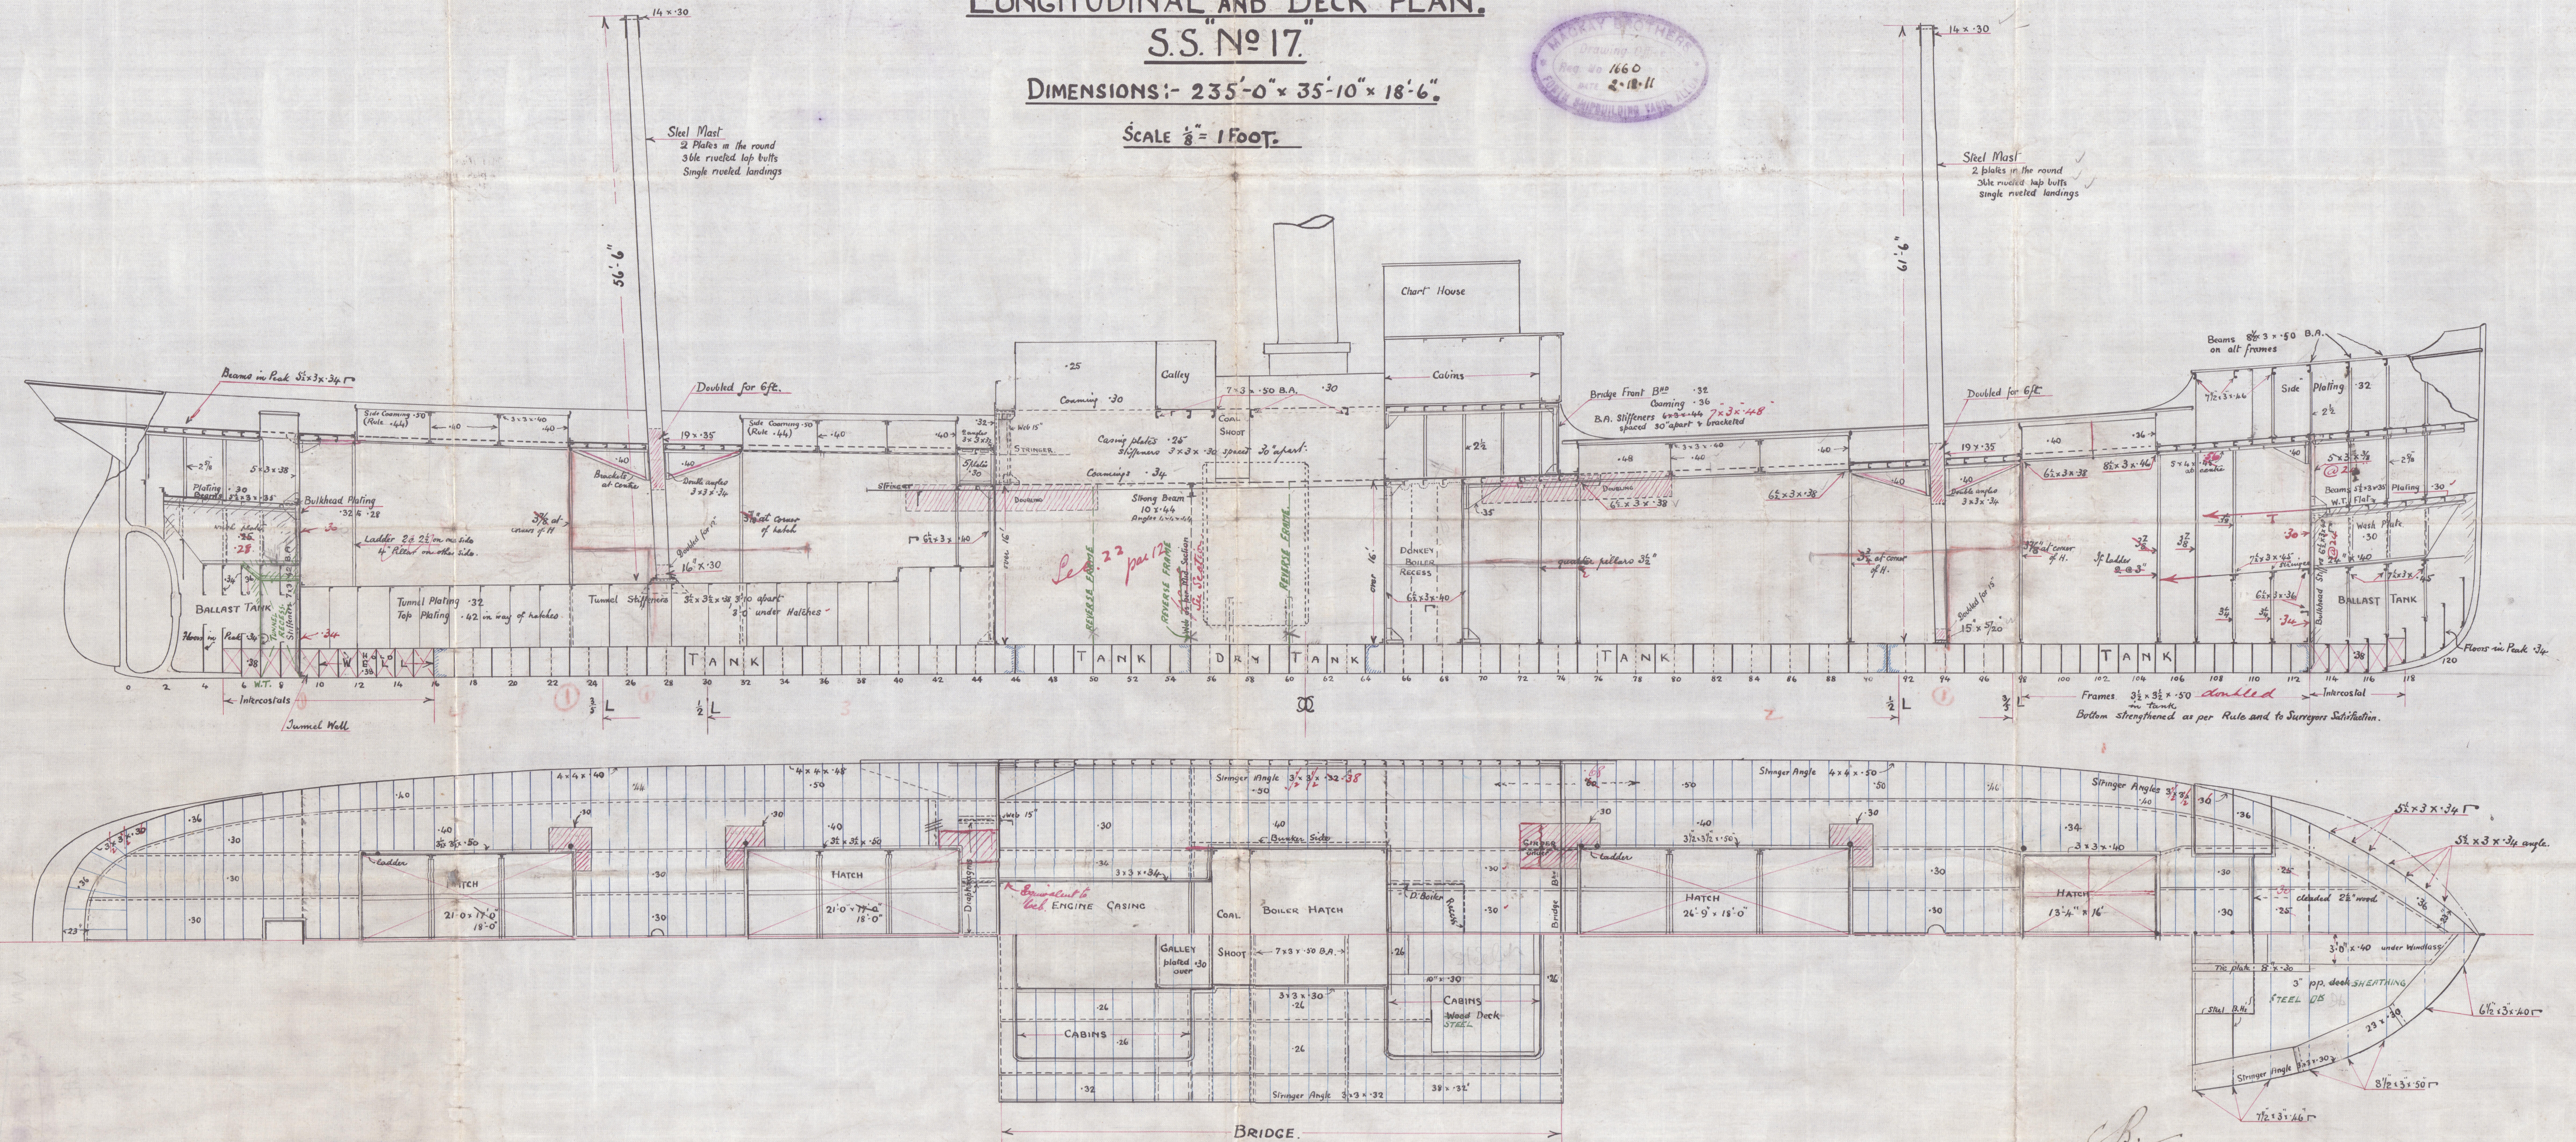

No 14


Profile Plan

Messrs Mackay Bros  
Alba

J.S. Nestor "Moncoursu"

N.W. Moncoursu

Lth. 13772.

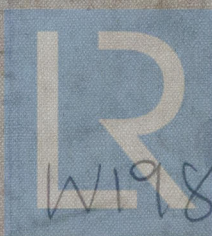

© 2020

Lloyd's Register  
Foundation

W198-0226