

Lloyd's Register of Shipping.

(Report on Vessel No. _____ Port _____)
S.S. "CHARLES M. EVEREST"

No. 481

SHIP FORGINGS OR CASTINGS.

I have to report that the undermentioned Iron ~~or Steel~~ Forgings ~~or Castings~~, manufactured by The De Lancy Forge Co of Buffalo. N. Y. for the Vessel No. 449, being built by The Harlan & Hollingsworth Corporation, of Wilmington Del. have been inspected by me as set forth below and found to be, so far as can be seen, sound.

4-10-17- 1 Iron Stern Frame (in 2 sections)


Mark on Forgings ~~or Castings~~.

Lloyd's

No. 4813-10-17FWTJ W SwadellBuffalo. N. Y.

	/ STERN FRAME.	RUDDER FRAME.	STEM.
Material* ...	<u>Scrap Iron</u>		
How made ...	<u>Forged & machined</u>		
Dimensions ...	<u>As per plan</u>		
Progress on Inspection ...	<u>Finished</u>		
Date when Inspected	<u>3rd October 1917</u>		
CASTINGS.			
Tests on Standard Test Pieces.			
Tensile Test—			
Tons per square inch			
Extension per cent. ...			
Cold Bending Test—			
Angle before fracture			
Drop Test—			
Height from ground ...			
Hammering Test—			
If made according to Rules and found satisfactory ...			

SKETCHES OF FRAMES SHOWING POSITION AND DESCRIPTION OF WELDS OF FORGINGS.

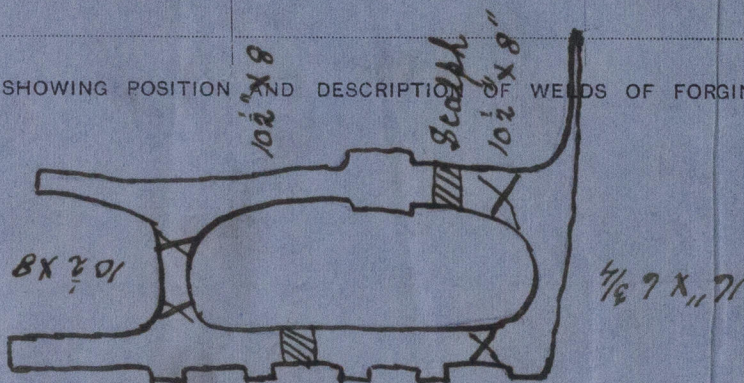

Fee (if any chargeable) £

To be paid at

* If of Iron, state whether scrap or puddled Iron. If of steel, state whether made on the Open Hearth process.