

LLOYD'S NUMBER

B-D = 35.95

L(B-D) = 4673.5

a = 11.75

B = 22.87

b = 9.93

# MIDSHIP SECTION

SCALE 1/2" = 1 FOOT

DIMENSIONS: 130'-0" BP x 23'-0" EX x 13'-11" DEPTH, 12'-3" HOLD

CLASSED 100 A.

STEEL  
STEAM TRAWLER.

ANCHORS & CHAINS.

1 ANCHOR 7/4 CWT STOCKLESS.

1 " 5 1/4 " EX STOCK.

1 " 3 " "


105 FATHOMS 1 1/16" STUD LINK CABLE

60 " 6" HAWSER.

60 " 5" WARP

16.8.15.

ENGINE BOILER CASING  
AS PREVIOUSLY APPROVED

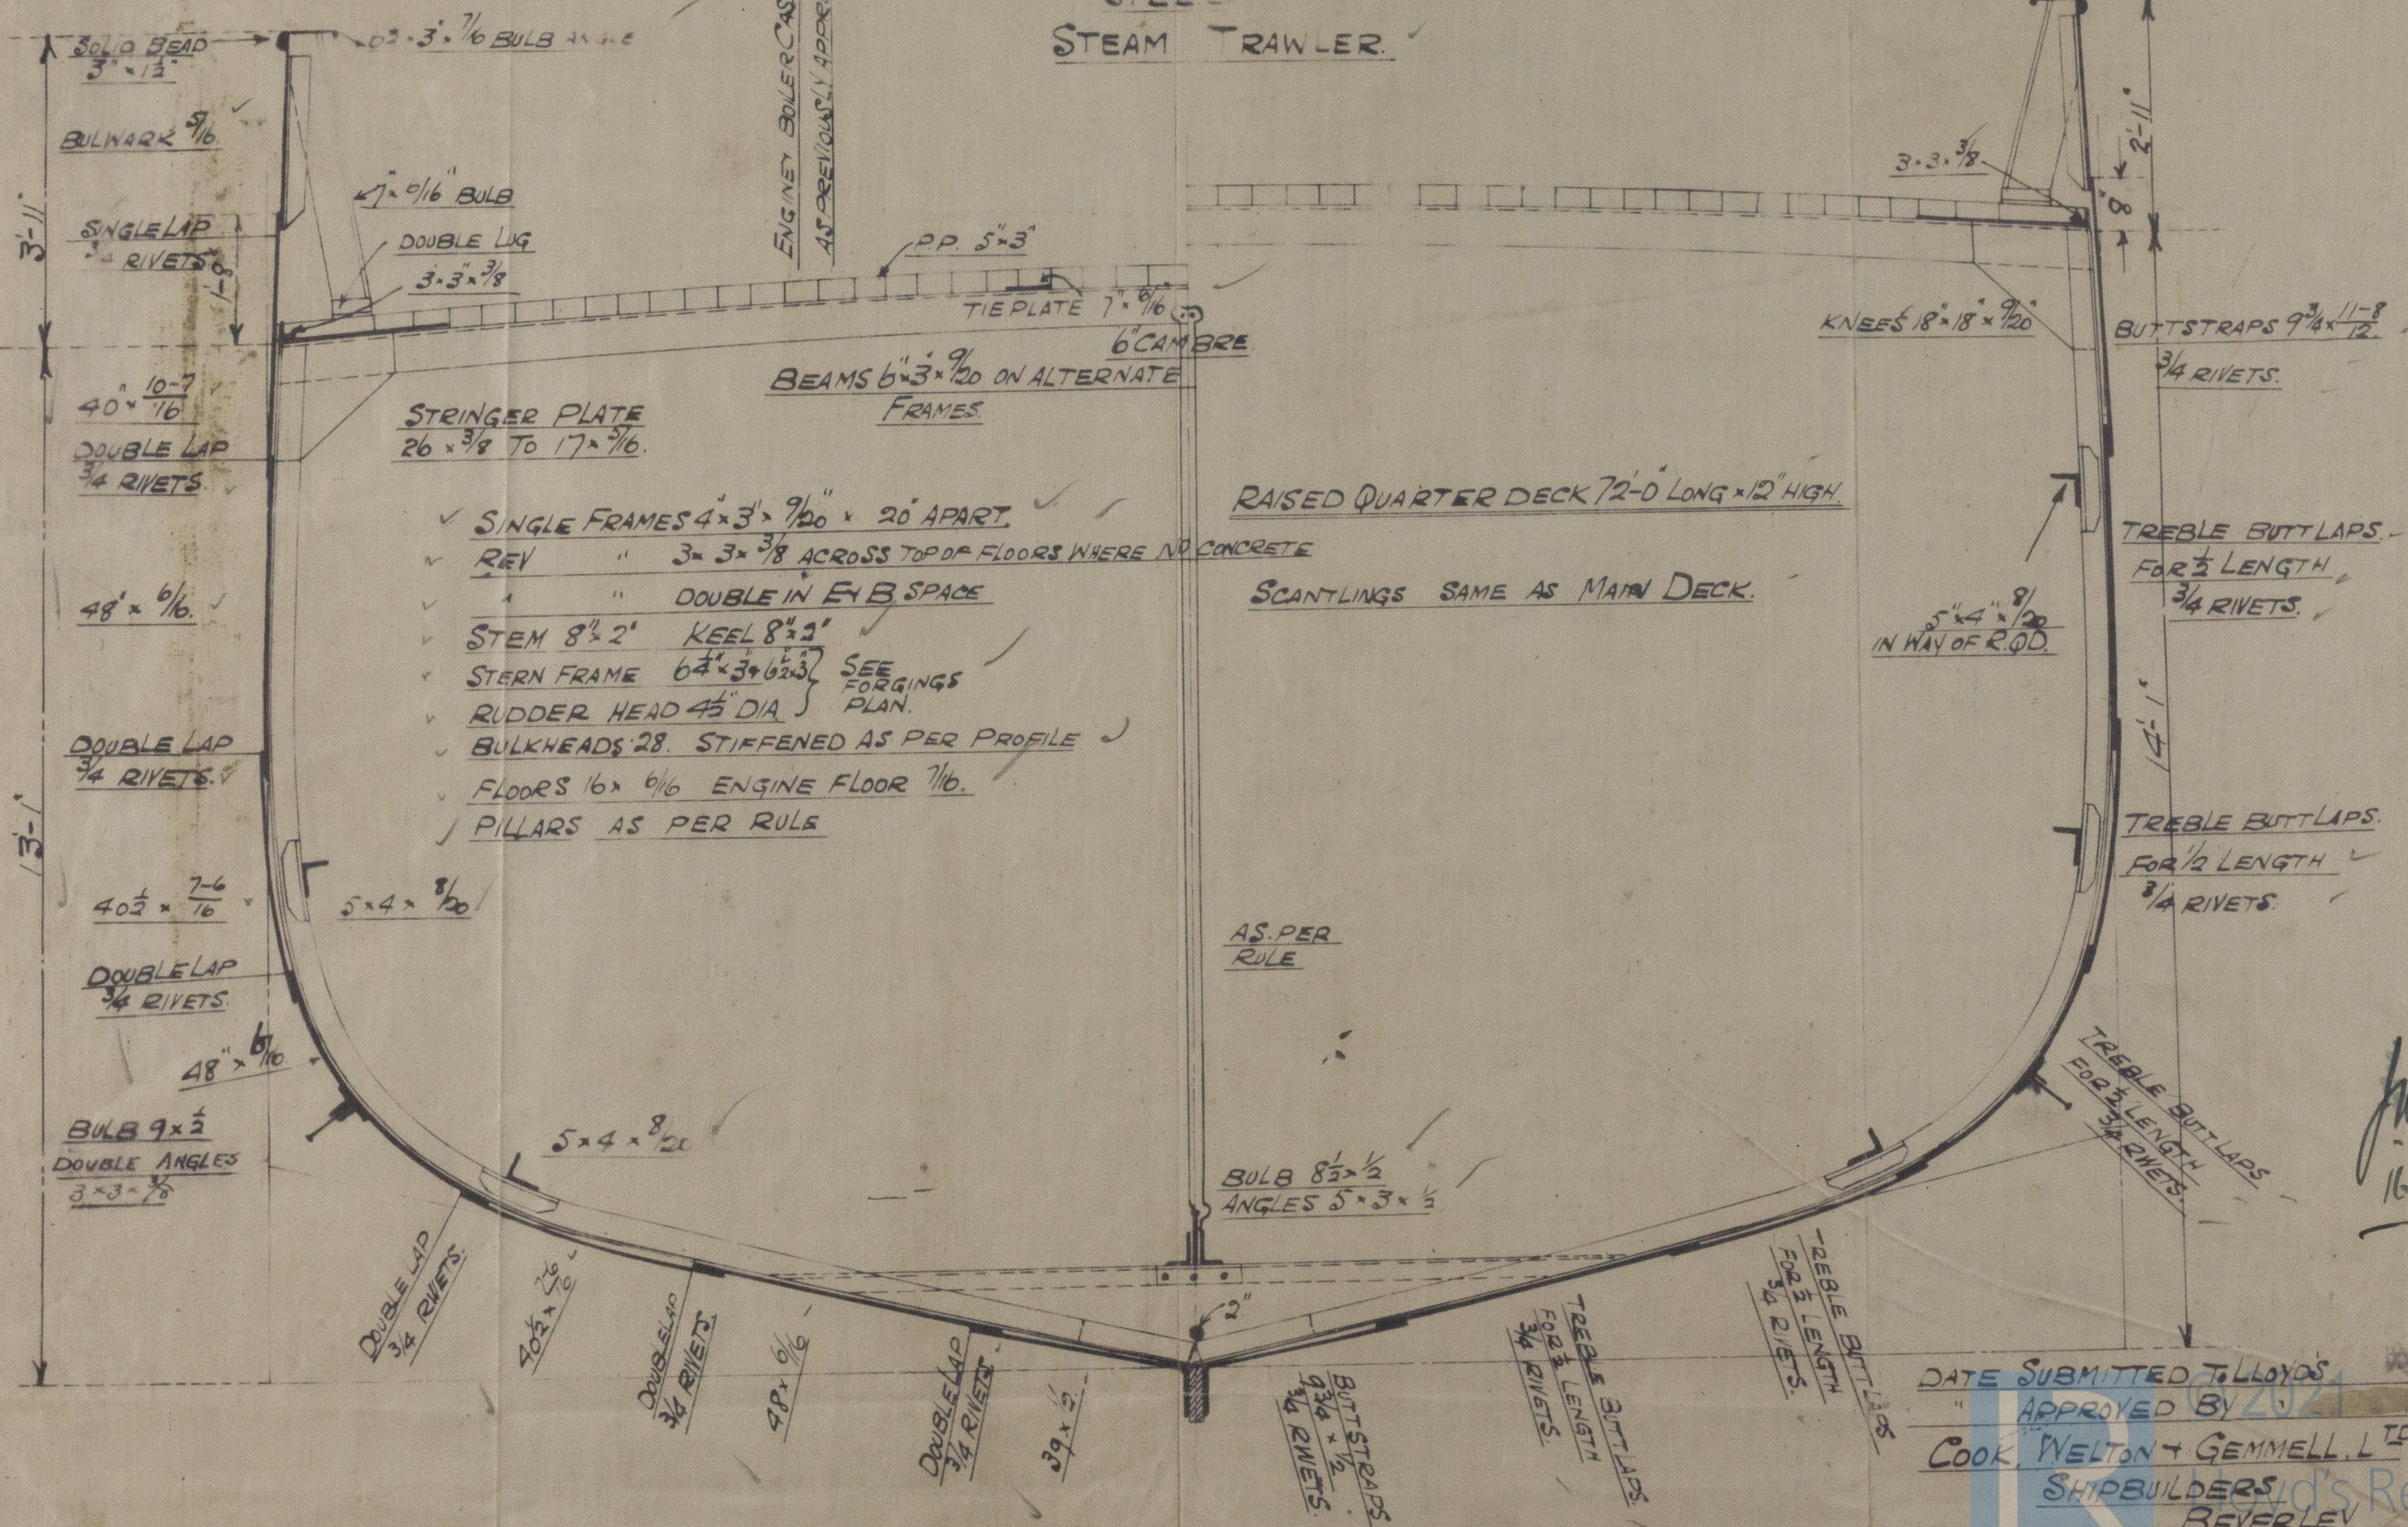

- ✓ SINGLE FRAMES 4 x 3 x 9/20 x 20' APART.
- ✓ REV " 3 x 3 x 3/8 ACROSS TOP OF FLOORS WHERE NO CONCRETE
- ✓ " " DOUBLE IN E & B SPACE
- ✓ STEM 8 x 2' KEEL 8 x 2'
- ✓ STERN FRAME 6 1/2 x 3 x 6 1/2 x 3' SEE FORGINGS PLAN.
- ✓ RUDDER HEAD 4 1/2" DIA.
- ✓ BULKHEADS 28. STIFFENED AS PER PROFILE
- ✓ FLOORS 16 x 6 x 6/16 ENGINE FLOOR 7/16.
- ✓ PILLARS AS PER RULE

RAISED QUARTER DECK 72'-0" LONG x 12" HIGH.

SCANTLINGS SAME AS MAIN DECK.

AS PER  
RULE

fw  
16.8.15

DATE SUBMITTED TO LLOYD'S 1915

APPROVED BY 1915

COOK WELTON & GEMMELL LTD

SHIPBUILDERS' Register  
BEVERLEY

W199-0043




N<sup>os</sup> 357-8


*Lois ex*  
s/s John Appleby Hull Rpt No. 29974

*Lois*  
MIDSHIP SECTION

COOK WELTON & GEMMELL

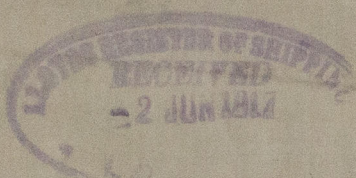

s/s John Arthur  
Hull Rpt No 30001.

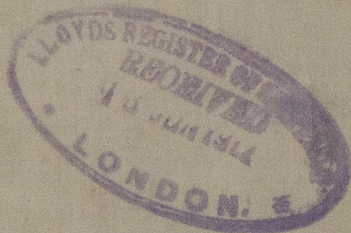

W199-0043



© 2021

Lloyd's Register  
Foundation