

11. 7. 13.

UPPER DECK.

-ENGINE SPACE.

- BOILER SPACE

POCKET
BUNKER.

4 ANGLES $6 \times 6 \times 50$

TWARTSHIP BRACKET:
PILLAR OVER INTERCOSTAL

no manholes to be cut immediately under pillars

- ELEVATION

SECTION THRO' E. & B. CASING.

SCALE $\frac{1}{2}'' = 1 \text{ FOOT.}$

W. T. BULKHEAD BELOW.

W. T. BULKHEAD BELOW.

B.
20.6.13.

file
6.6.13

for
6-6-13

PLAN.

 Date 30-5-13
 No. 699

© 2019
Lloyd's Register
Foundation


420-0068

Arthur M. H. L. L. L.
No 216


Plan of Casings & Framing

Chelabros

S.S. "MAGDALA"
NEWCASTLE-ON-TYNE
Report No 65937

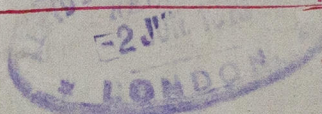

JUN 24 1913

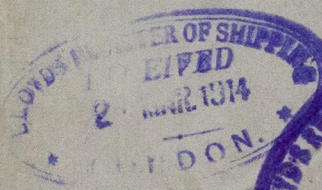

Lloyd's Register
Foundation

W20-0068