






9.5.13

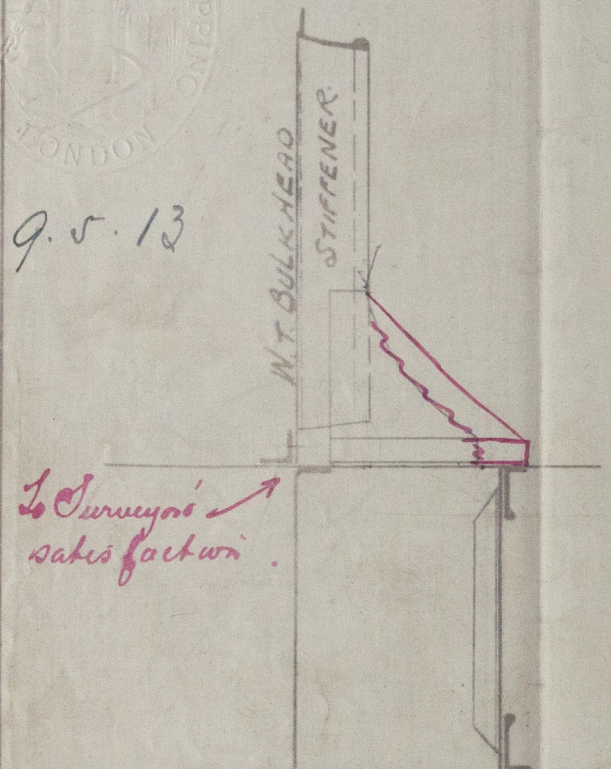

S. S. N<sup>o</sup> 216.

SKETCH OF BRACKET FLOOR SHOWING ADDITIONAL SUPPORTS FOR BULKHEAD STIFFENERS, ON N<sup>os</sup> 36, 64, 86 & 125.

SCALE  $\frac{1}{2}$ " = ONE FOOT.

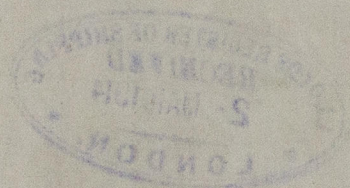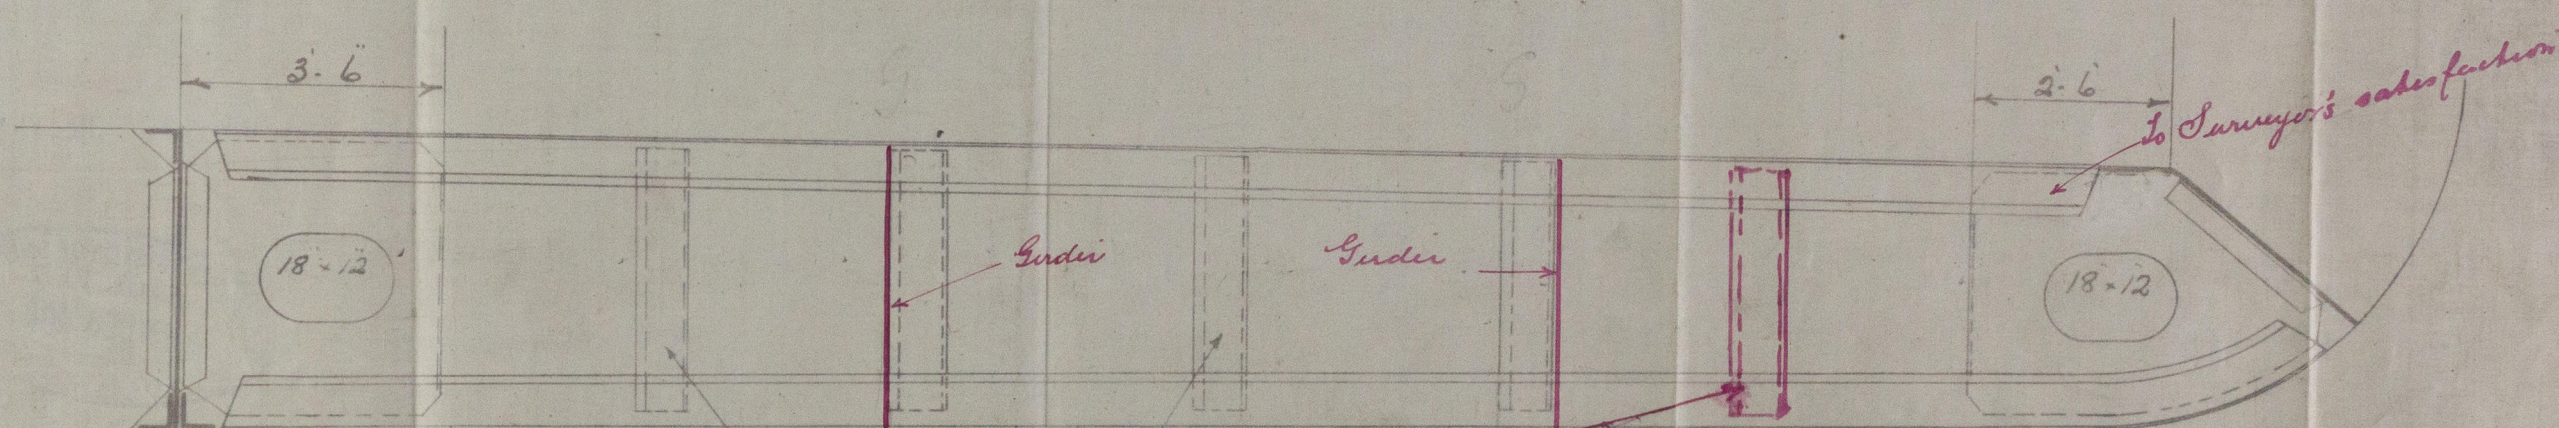

EXTRA SUPPORTS

7' 3" x 402 m

with 4 rivets through frames & reverse frames



9.5.13

Lloyd's Register  
Foundation

W20-0069




Lloyds

Bill

MAY 13 1913

Amthunthland S/B Co  
No. 216

Sketch of additional stowage  
to floor adjoining Bulkheads  
in way of brackets to B.H. Stowage

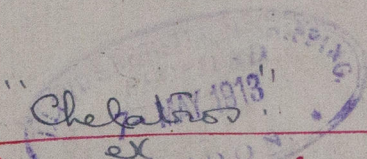

SS. MAGDALA

NEWCASTLE-ON-TYNE

Report No. 65937



Lloyd's Register  
Foundation

W20-0069