


S.S. No. 216. PUMPING PLAN.

SCALE $\frac{1}{8}$ " = 1 FOOT.
 DIMENSIONS 360.0 B.P. x 51.8 BREADTH MOULDED x 26.0 DEPTH MOULDED TO MAIN DECK. UNDER DECK TONNAGE 3600 APPROX.

28/5/13

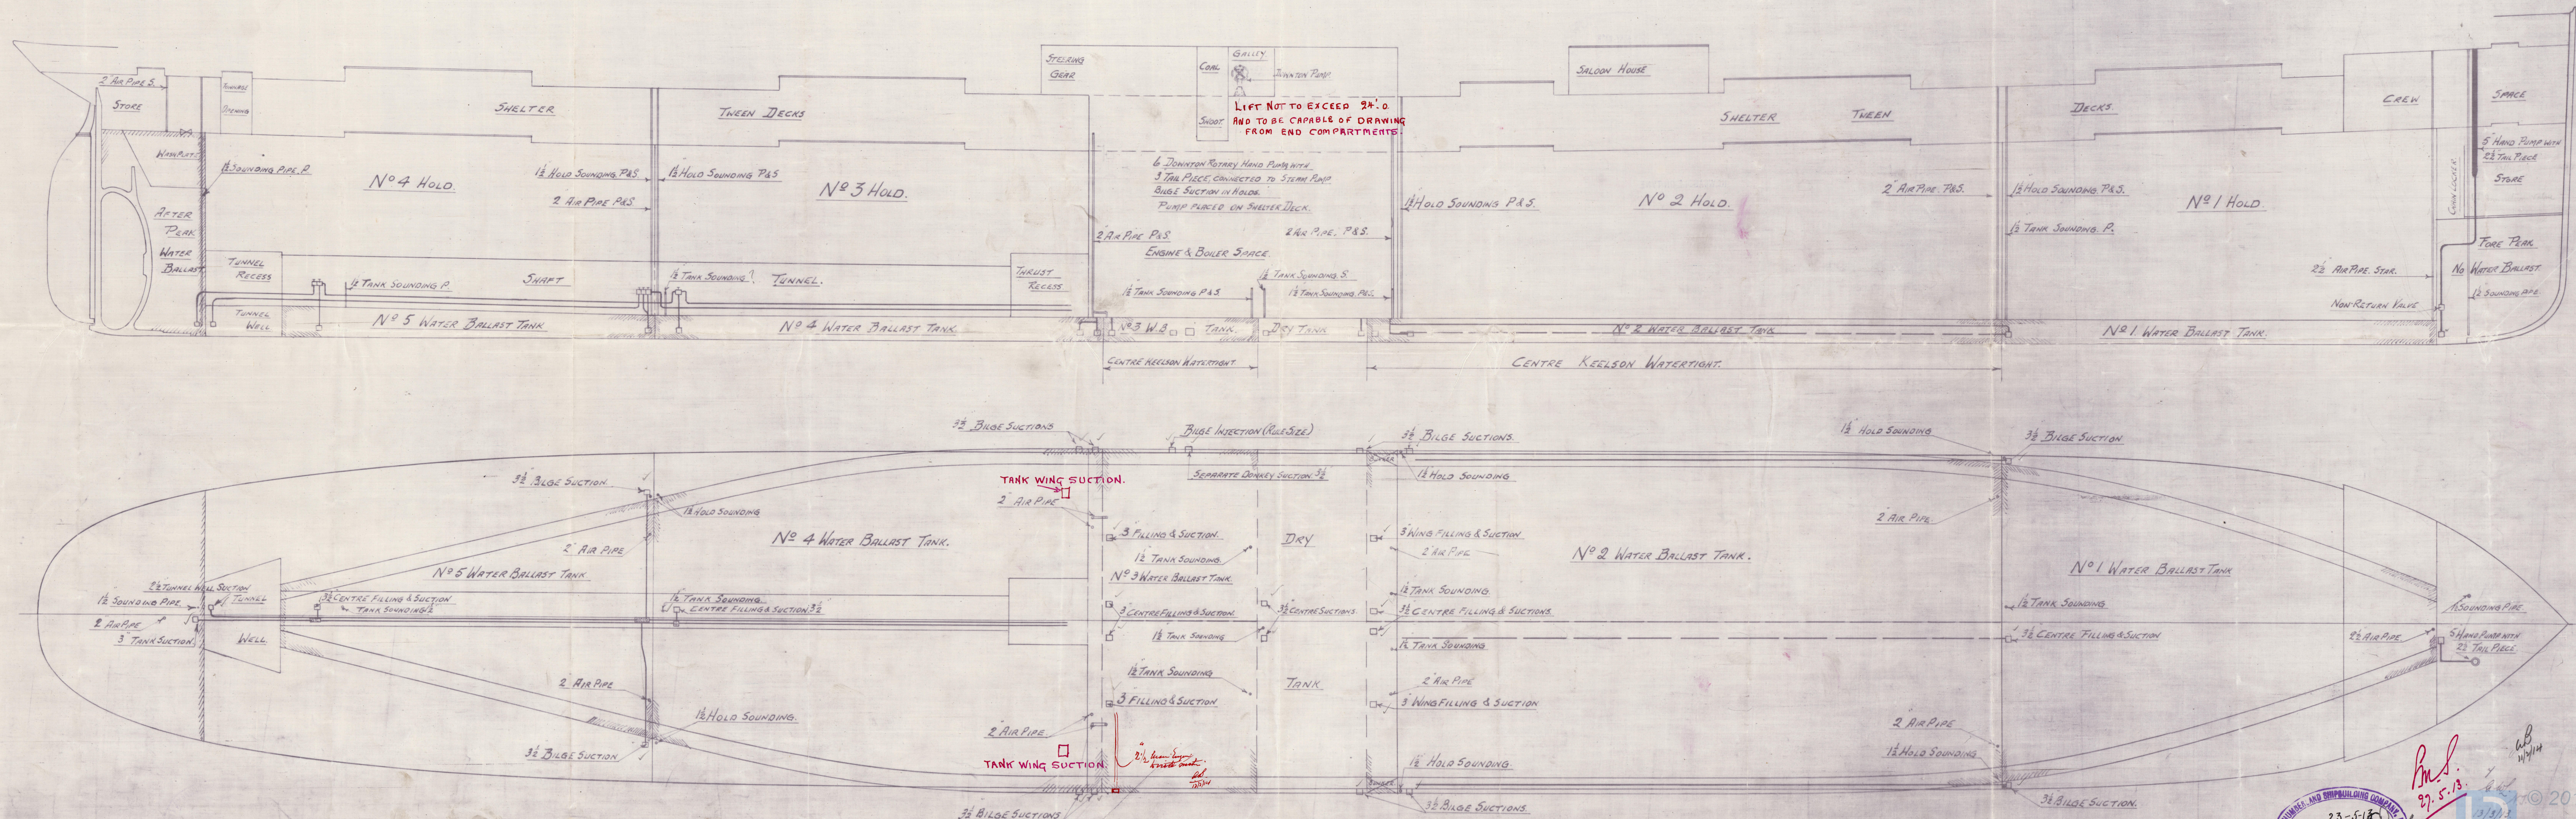

NOTED AND APPROVED
 Date 23-5-13
 No. 681
 H. ROWDON, N. 100

27.5.13

Amthumberland S.B. Co. Ltd.

No 216

Plan of Pumping Arrangements



MAY 30 1918



S/S Magdala
"Chelator"

SS "MAGDALA"

WEST HARTLEPOOL. 14845

NEWCASTLE-ON-TYNE. Report No. 65937



© 2019

Lloyd's Register
Foundation

W20-0071