


# SKETCH SHOWING QUINTUPLE RIVETED BUTTLAP. S.S. 216.

SCALE 3" = 1 FOOT.

20.6.13

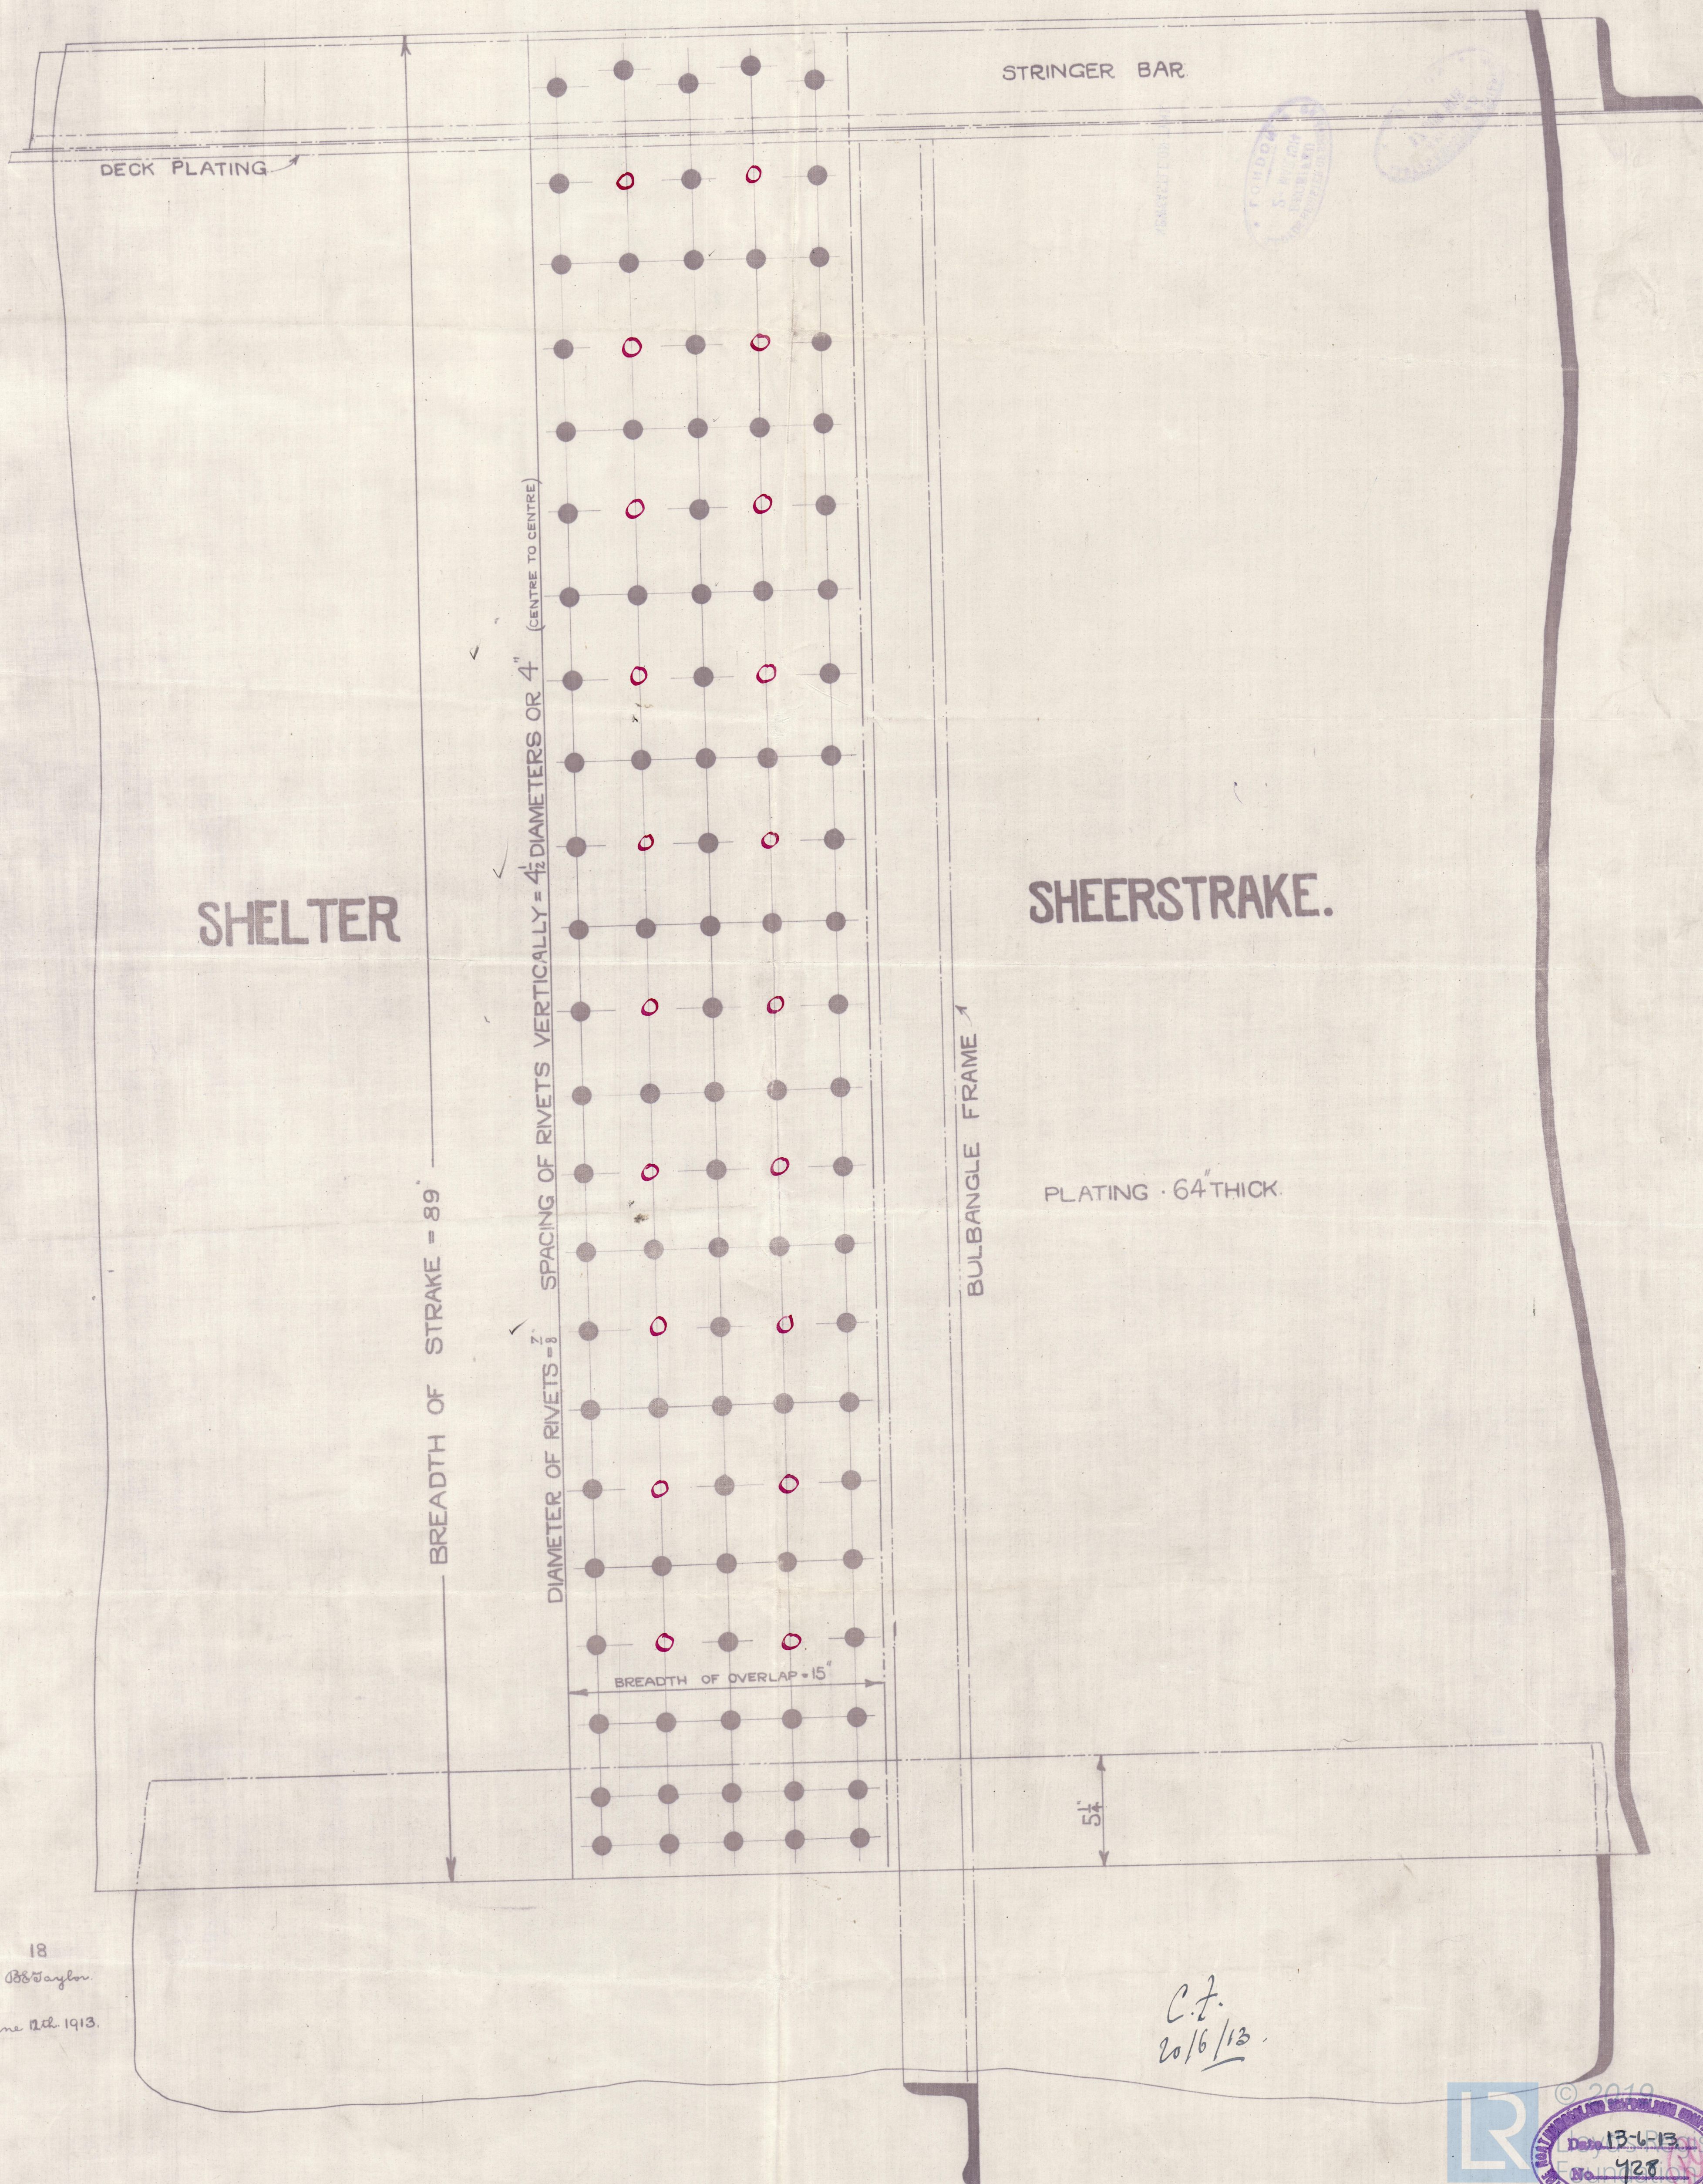




Northumberland S.P. Co. Ltd

No 216

Shetel 7 Luntupke mited Bults

JUN 23 1913

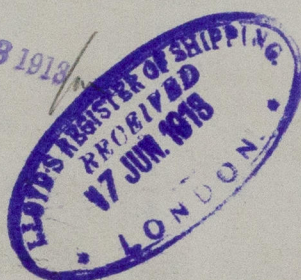

Chelatros

S.S. "MAGDALA"

NEWCASTLE-ON-TYNE.

Report No 65937



© 2019

Lloyd's Register  
Foundation

W20-0072