


SKETCH SHOWING QUINTUPLE RIVETED BUTTLAP.

S.S. 216.

SCALE 3" = 1 FOOT.

15.7.13

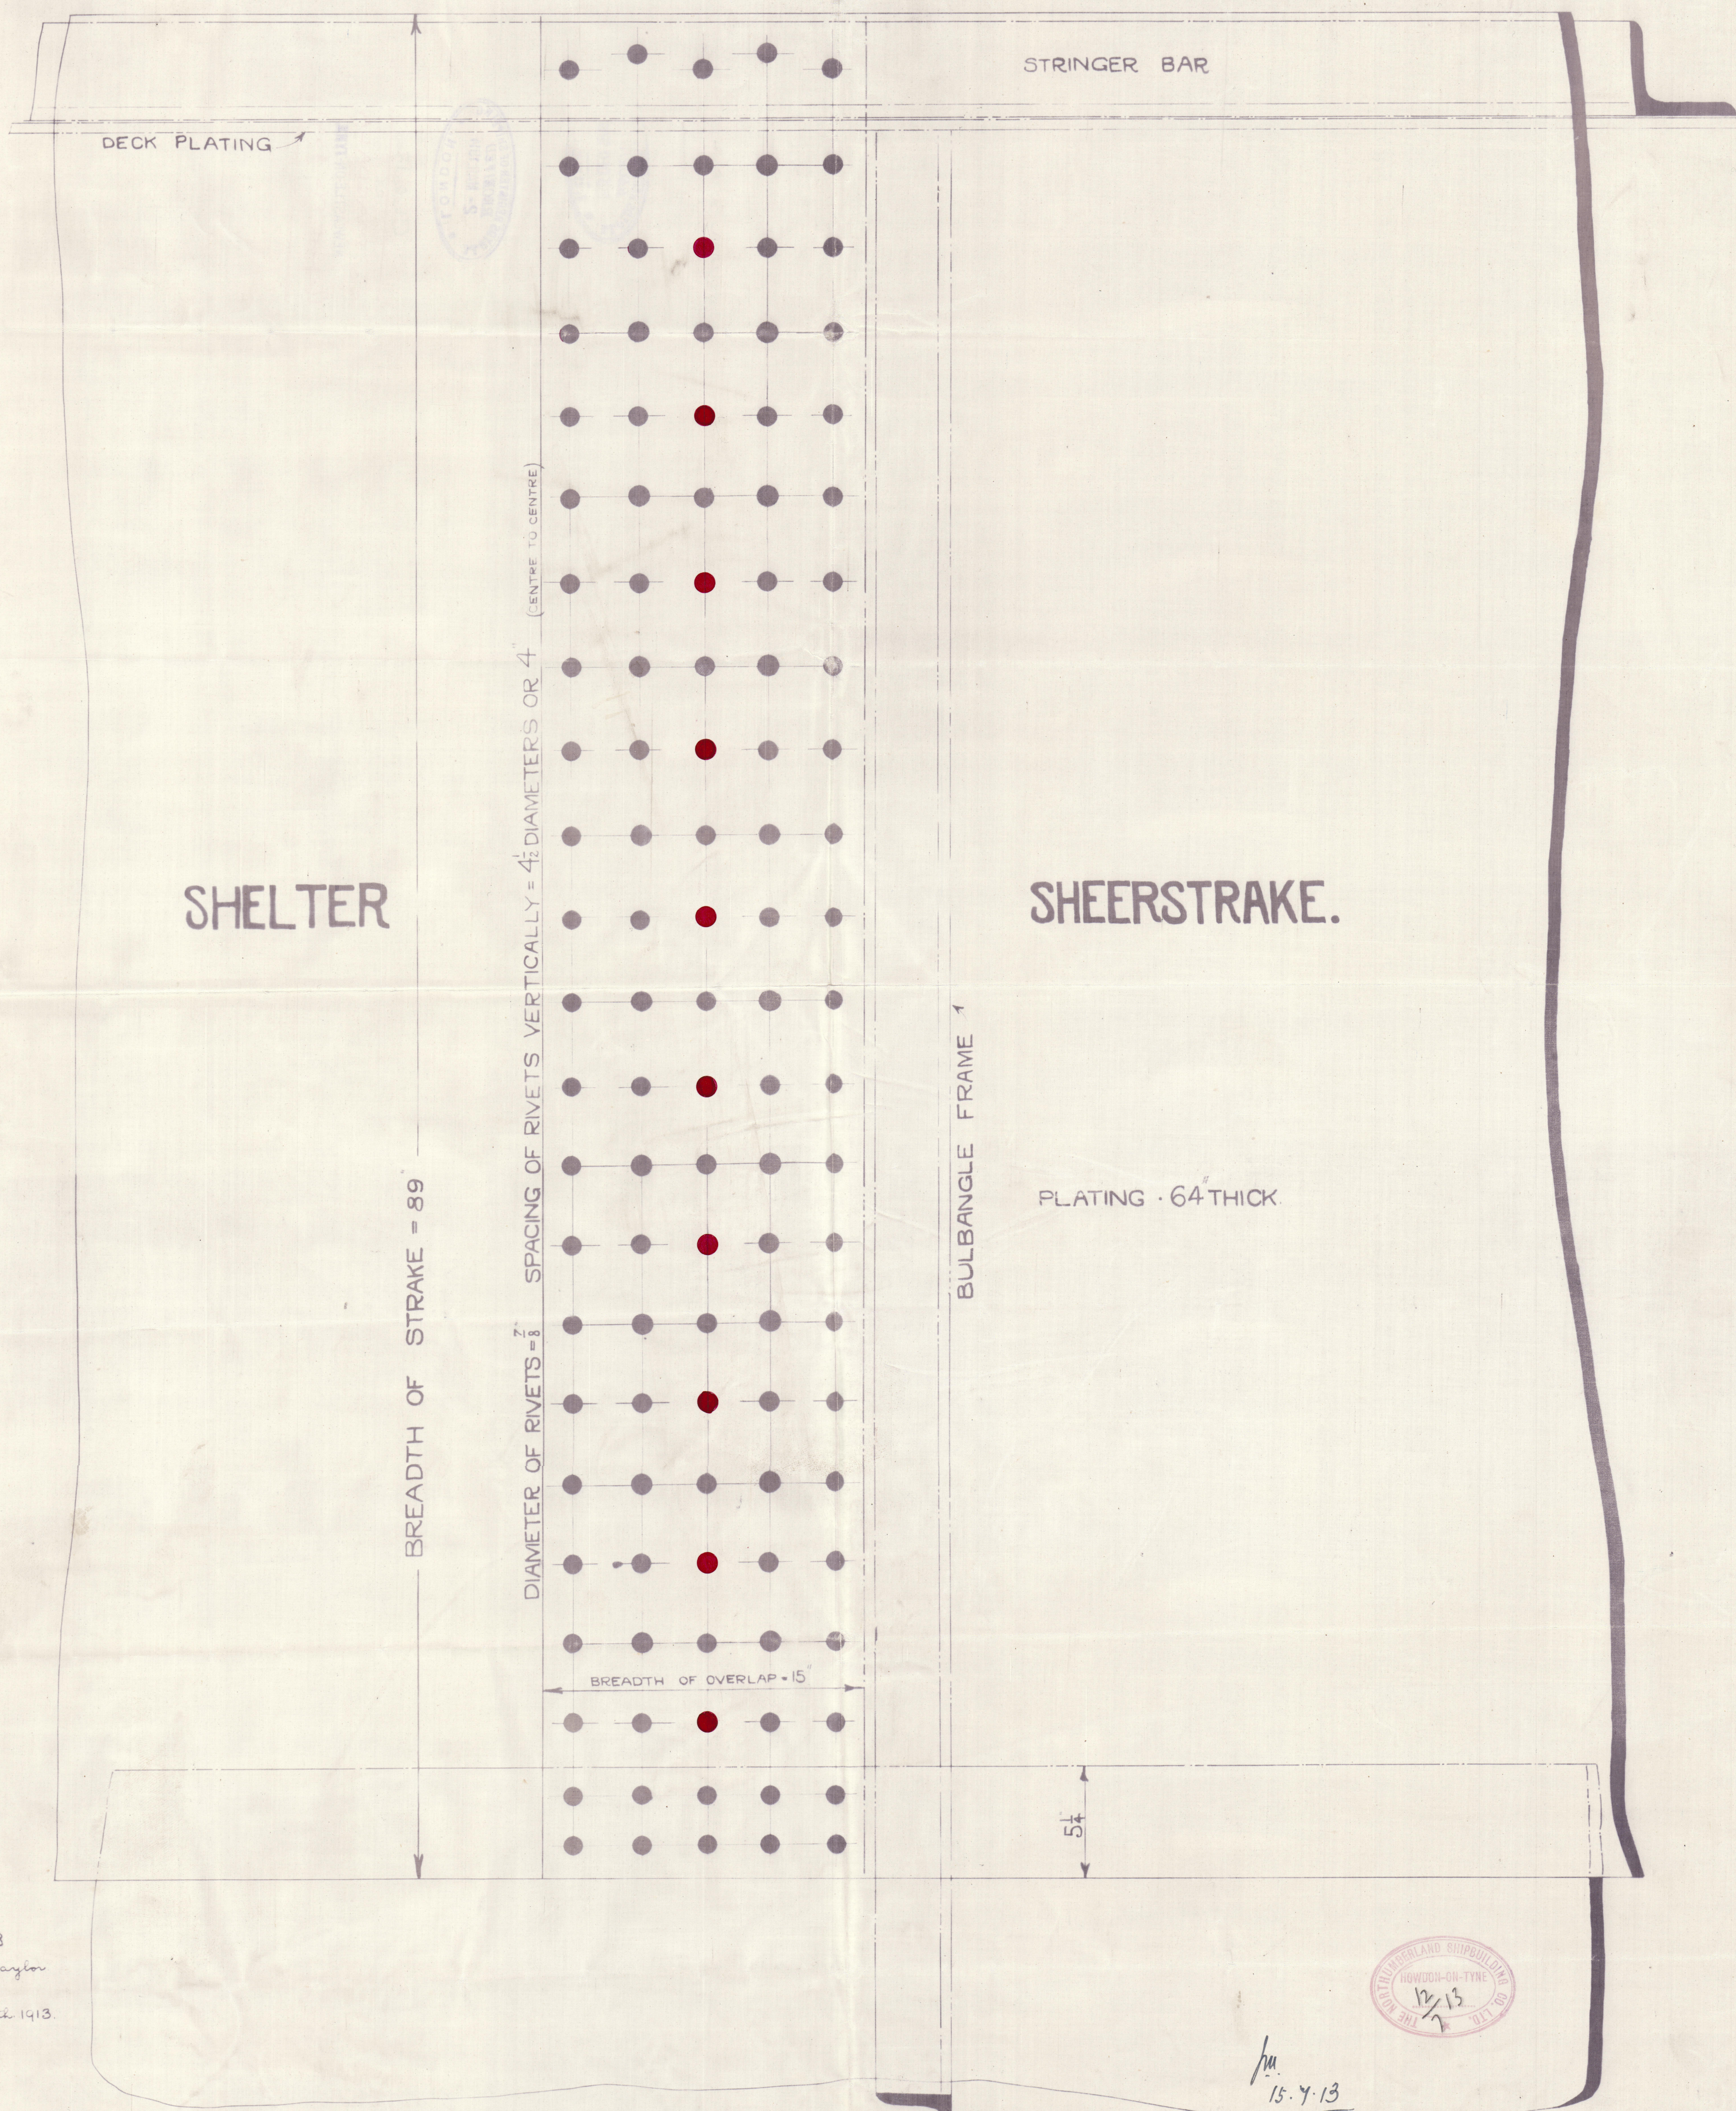

18

B.S. Taylor

June 12th 1913.



© 2019

Lloyd's Register Foundation

W20-0073

N^o 216

Quintuple Butt



"Chelatis"
ex

S.S. "MAGDALA"
NEWCASTLE-ON-TYNE

Report No 65937



© 2019

Lloyd's Register
Foundation

W20-0073