



B. Taylor

S.S. 216.

PLAN SHOWING PROPOSED SUBSTITUTION OF A ROUND PILLAR ON N° 89 FRAME.

SCALE $\frac{1}{8}$ " = 1 FOOT.

June 2nd. 1913.

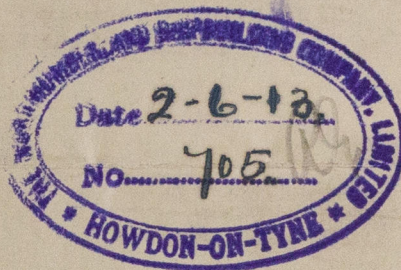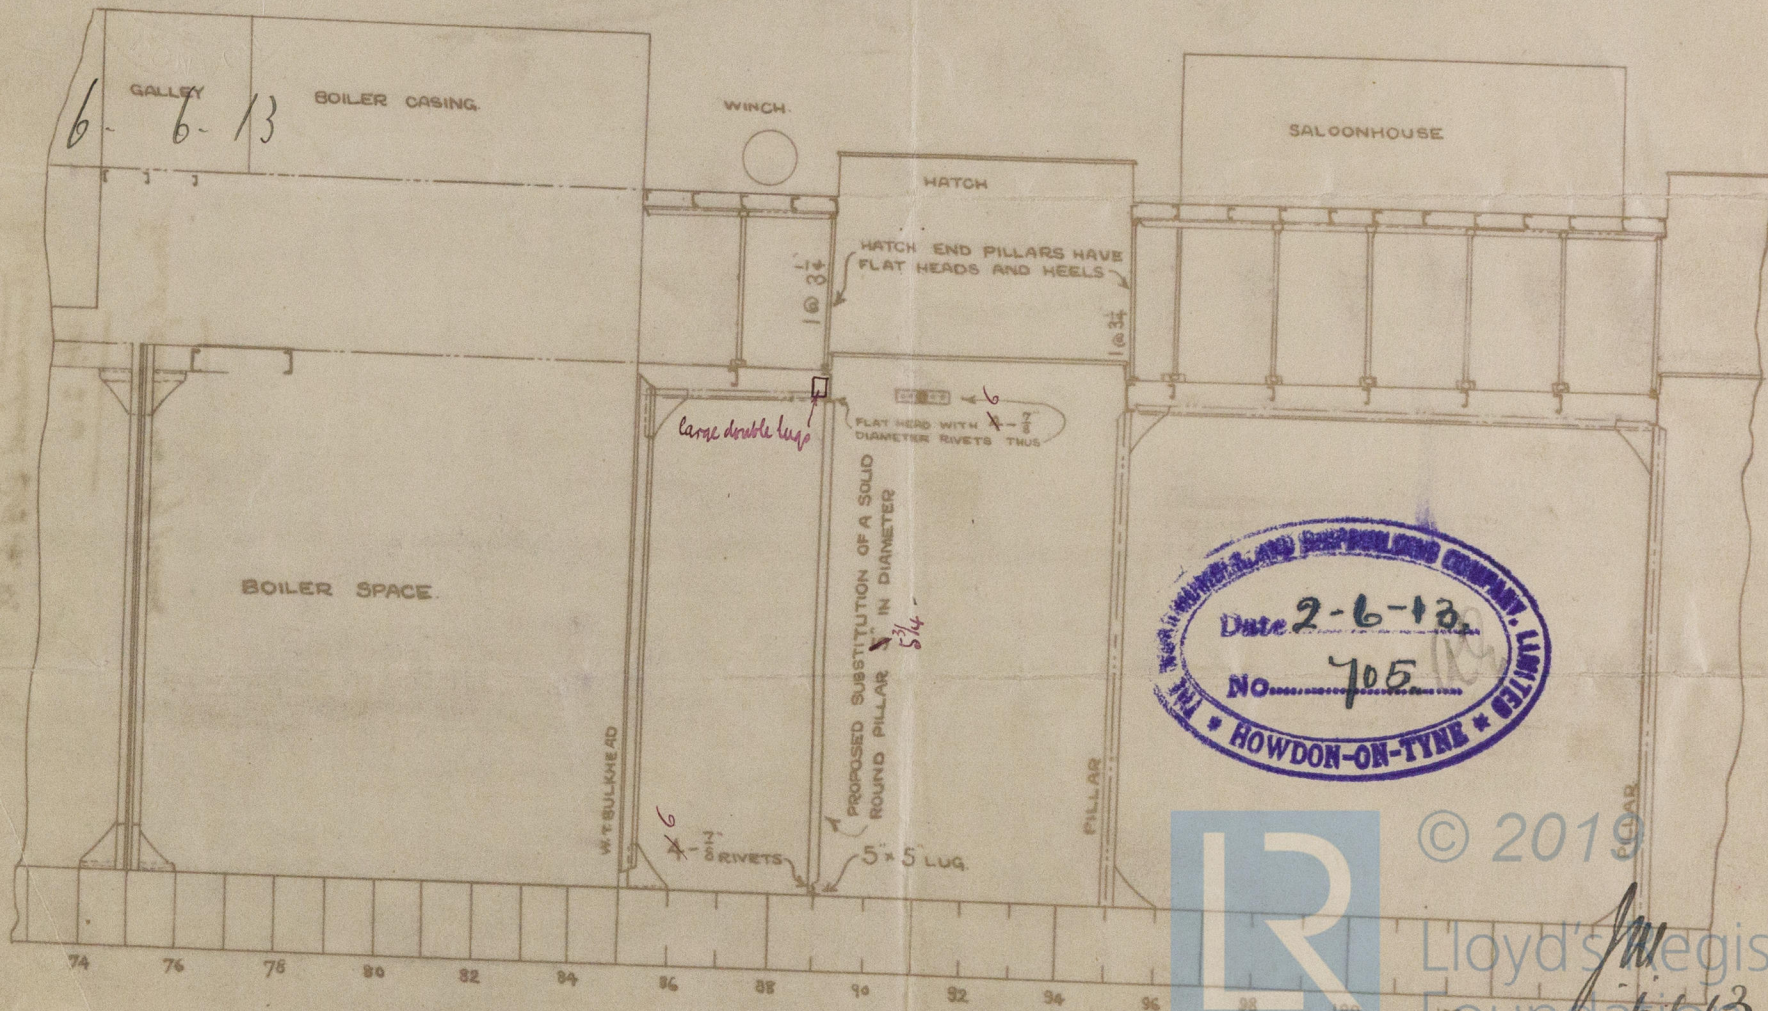

© 2019

Lloyd's Register
Foundation

W20-0074

Anthracite 213.6.44.

No. 216

Round pillar in 89 frame

JUN 9 1918

S.S. MAGDALA
NEWCASTLE-ON-TYNE.

Report No. 15937



© 2019

Lloyd's Register
Foundation

W20-0074