

25-4-13
116.5-13.
6.6-13
11.7-13
23.9-13
9.10-13

S.S. N° 216 MIDSHIP SECTION


SCALE 1/2" = 1 FOOT.

DIMENSIONS LENGTH B.P. 360' BREADTH MID 51'-8" DEPTH MID 34' TO SHELTER DECK

LLOYDS 100 A.I. CLASS

NUCLEARS	
BREADTH MID	51.66'
DEPTH	25.91'
LENGTH B.P.	359.50'
ERECTOR'S	2232
CASINGS	252
LENGTH + DEPTH TO SHELTER DECK	10.57'
EQUIPMENT NO	30370
2	22.5

EQUIPMENT	
2 BOWER ANCHORS STOCKLESS	5 1/2" CURS EACH
1 " " " "	4 7/8" " "
1 STREAM " " STOCK	15 " "
1 KEDGE " " " "	6 1/2" " "
2 TO FATHOMS 2 1/4" STEEL CHAIN CABLE	
40 " " " " " "	4 1/2" STEEL WIRE FOR STEAM CHAIN
120 " " " " " "	TOW LINE
2.890 " " " " " "	OWNERS' CONSENT
2.890 " " " " " "	

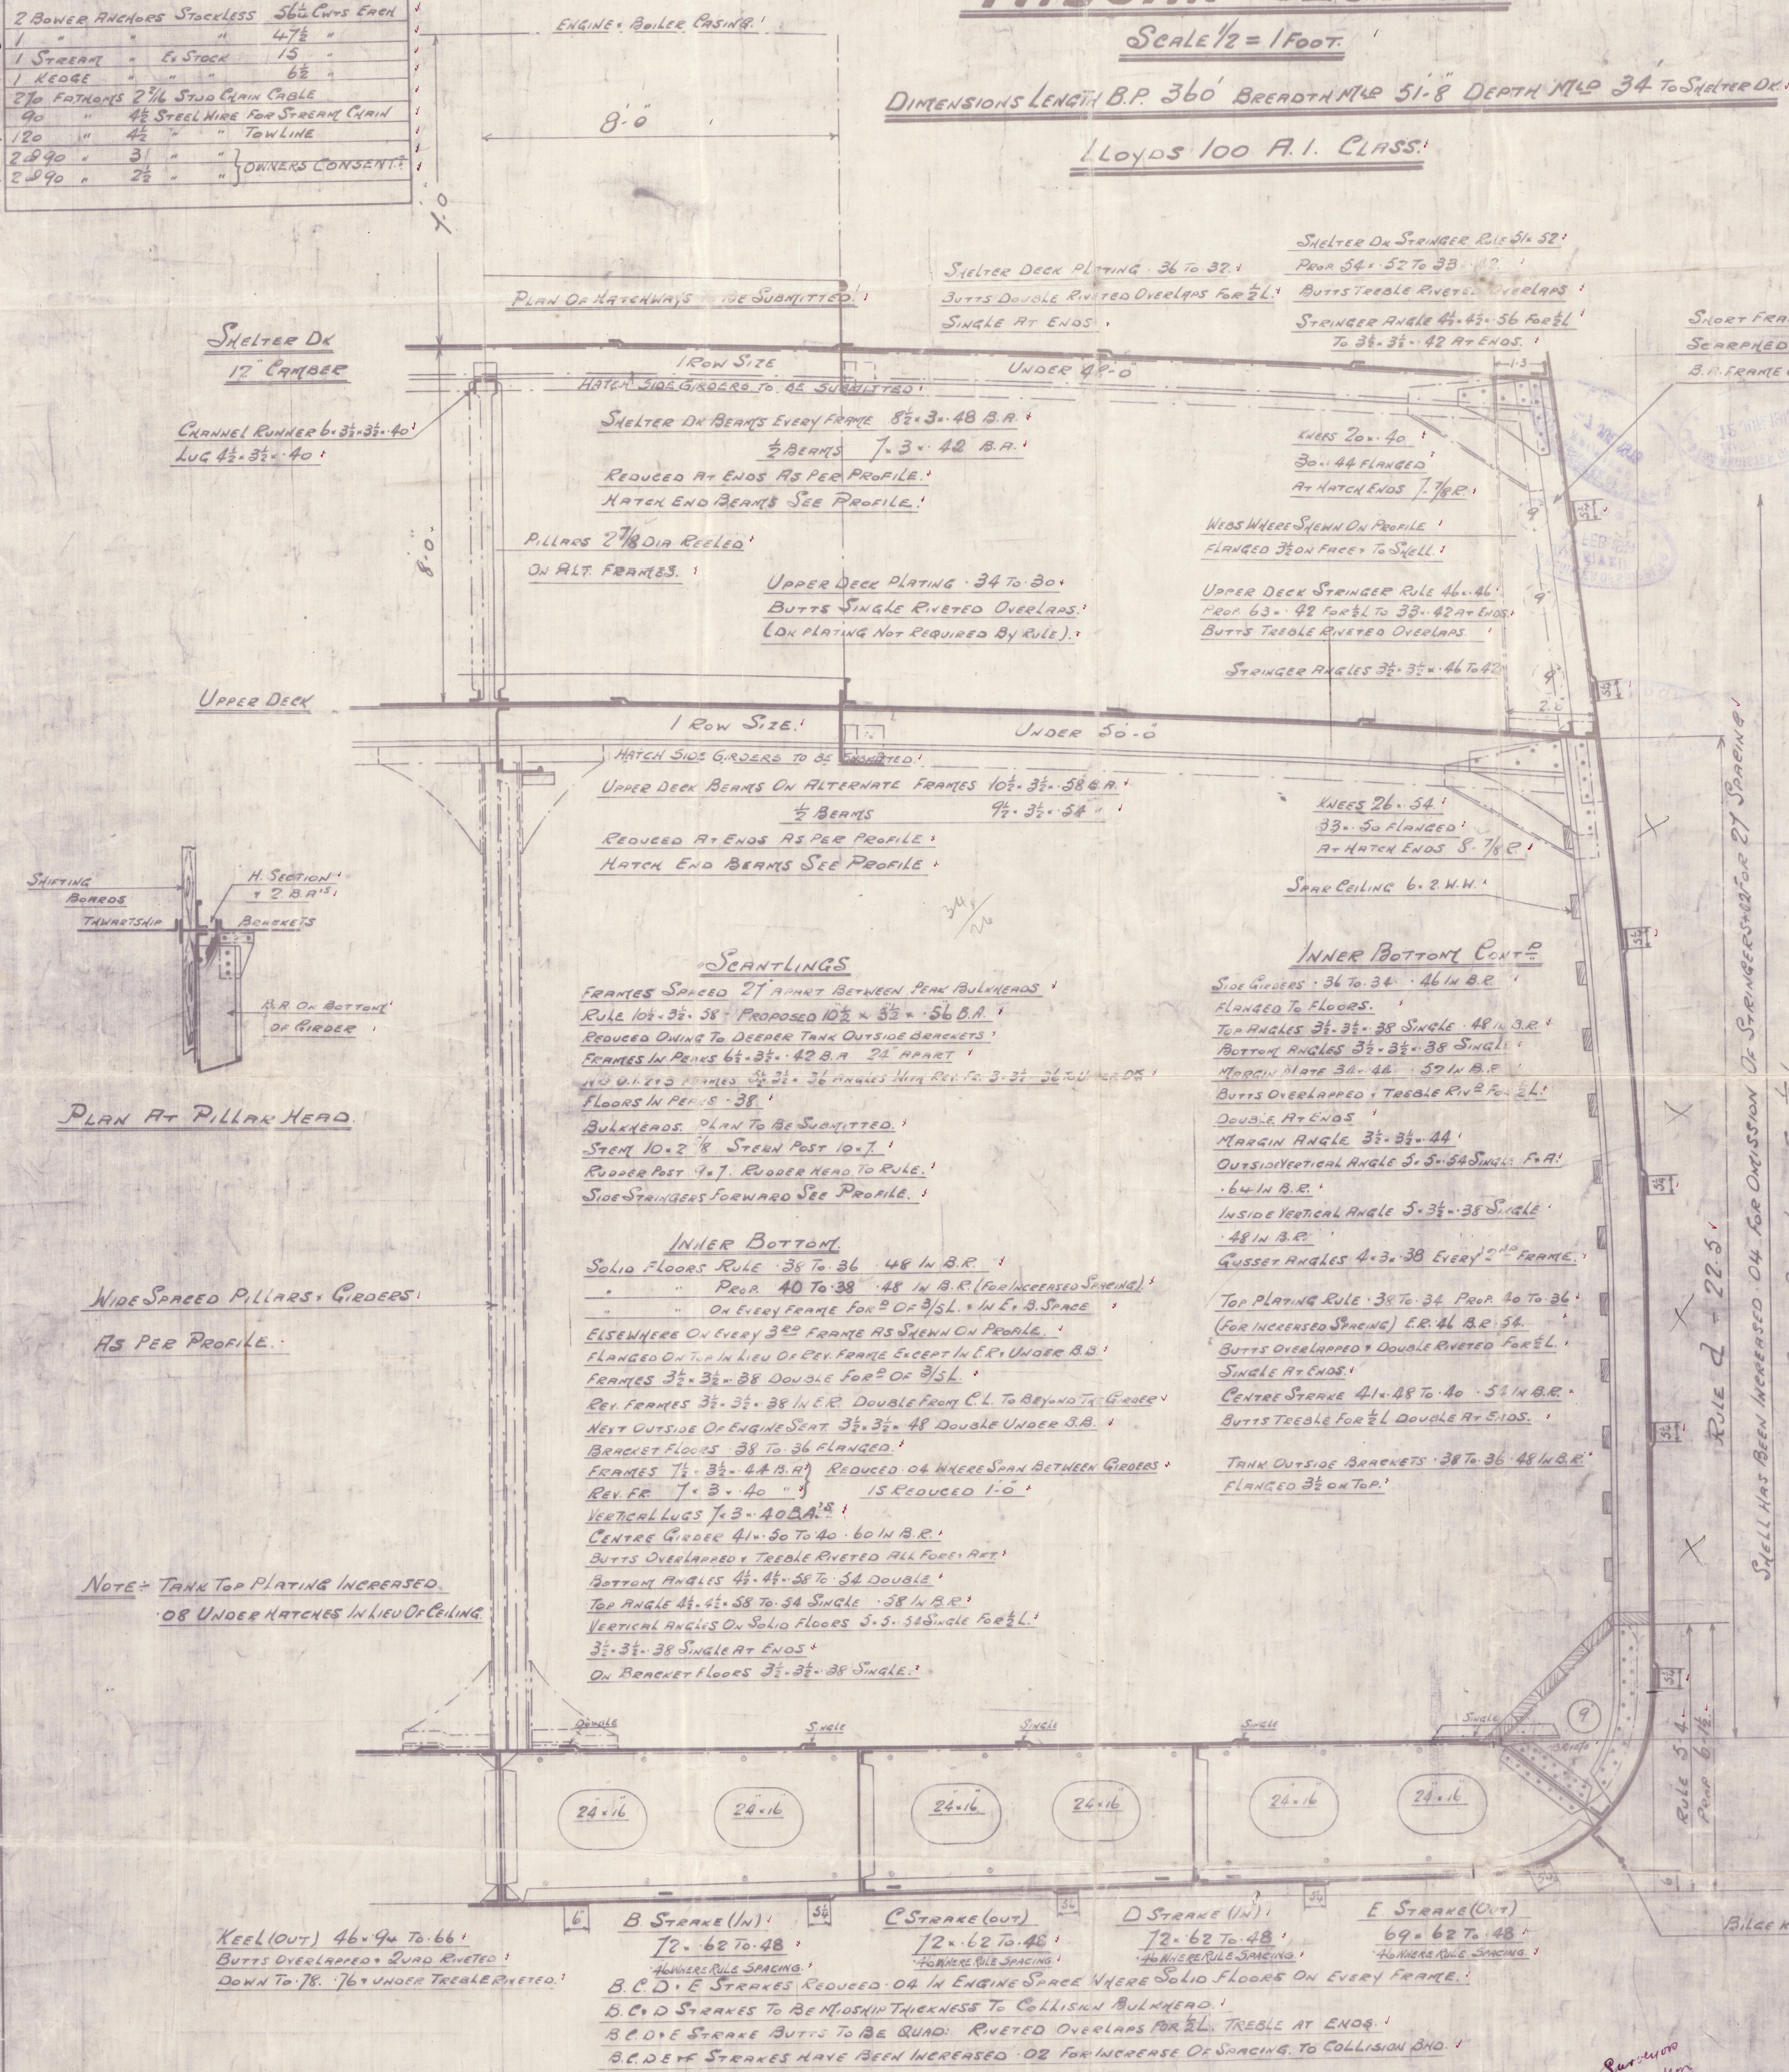

SHORT FRAMES 6" x 3 1/2" x 38 ANGLES SCARPHED 1'-6" ON TO MAIN FRAMES. B.B. FRAME CARRIED UP AT HATCH END ONLY.

M. STRAKE (IN) 46" x 64 TO 44' BUTTS QUAD RIVETED OVERLAPS FOR 3/4" TREBLE AT ENDS.

L. STRAKE (OUT) Rule 46" x 60 TO 44' PROP 54" x 62 TO 44' BUTTS TREBLE RIVETED OVERLAPS.

K. STRAKE (IN) 72" x 66 TO 50 44 IN PEAKS BUTTS TREBLE RIVETED OVERLAPS AT ENDS.

J. STRAKE (OUT) 72" x 66 TO 50 44 IN PEAKS BUTTS TREBLE RIVETED OVERLAPS AT ENDS.

H. STRAKE (IN) 72" x 66 TO 50 44 IN PEAKS BUTTS TREBLE RIVETED OVERLAPS AT ENDS.

G. STRAKE (OUT) 72" x 66 TO 50 44 IN PEAKS BUTTS TREBLE RIVETED OVERLAPS AT ENDS.

F. STRAKE (IN) 69" x 62 TO 48' BUTTS TREBLE RIVETED OVERLAPS AT ENDS.

SKEL BUTTS QUAD WHERE OVER RULE WIDTH.

KEEL (OUT) 46" x 94 TO 66' BUTTS OVERLAPPED QUAD RIVETED DOWN TO 78' 76" UNDER TREBLE RIVETED.

B STRAKE (IN) 72" x 62 TO 48' HATCHES RULE SPACING. B.C.D. E STRAKES REDUCED 04 IN ENGINE SPACE WHERE SOLID FLOORS ON EVERY FRAME. B.C.D STRAKES TO BE MIDSHIP THICKNESS TO COLLISION BULKHEAD. B.C.D E STRAKE BUTTS TO BE QUAD RIVETED OVERLAPS FOR 3/4" TREBLE AT ENDS. B.C.D E STRAKES HAVE BEEN INCREASED 02 FOR INCREASE OF SPACING TO COLLISION END.

C STRAKE (OUT) 72" x 62 TO 48' HATCHES RULE SPACING.

D STRAKE (IN) 72" x 62 TO 48' HATCHES RULE SPACING.

E STRAKE (OUT) 69" x 62 TO 48' HATCHES RULE SPACING.

BILGE KEEL 10" x 44 10 1/2" PLATE 4 1/2" x 3 1/2" x 40 ANGLE.

DATE 15-4-13
No. 267
HOWDON-ON-TYPE

Chelatos
"Chelatos"
ea

S.S. "MAGDALA"

NEWCASTLE-ON-TYNE

Report No 65937



W20-0087

© 2019

Lloyd's Register
Foundation