




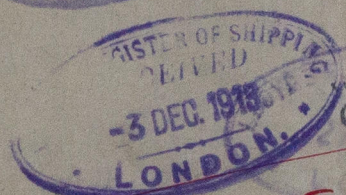

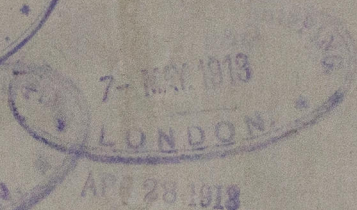


Mathewson and S.B. Co.  
No 216

Amended Profile of Deck plans

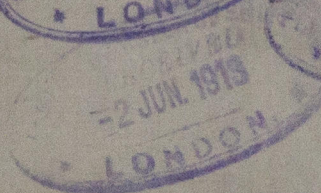

Chalatis  
ex  
SS. "MAGDALA"  
NEWCASTLE-ON-TYNE.

Report No 65937

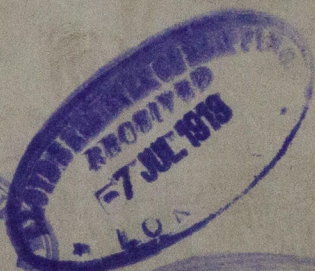

W20-0097

Def



© 2019

Lloyd's Register  
Foundation