
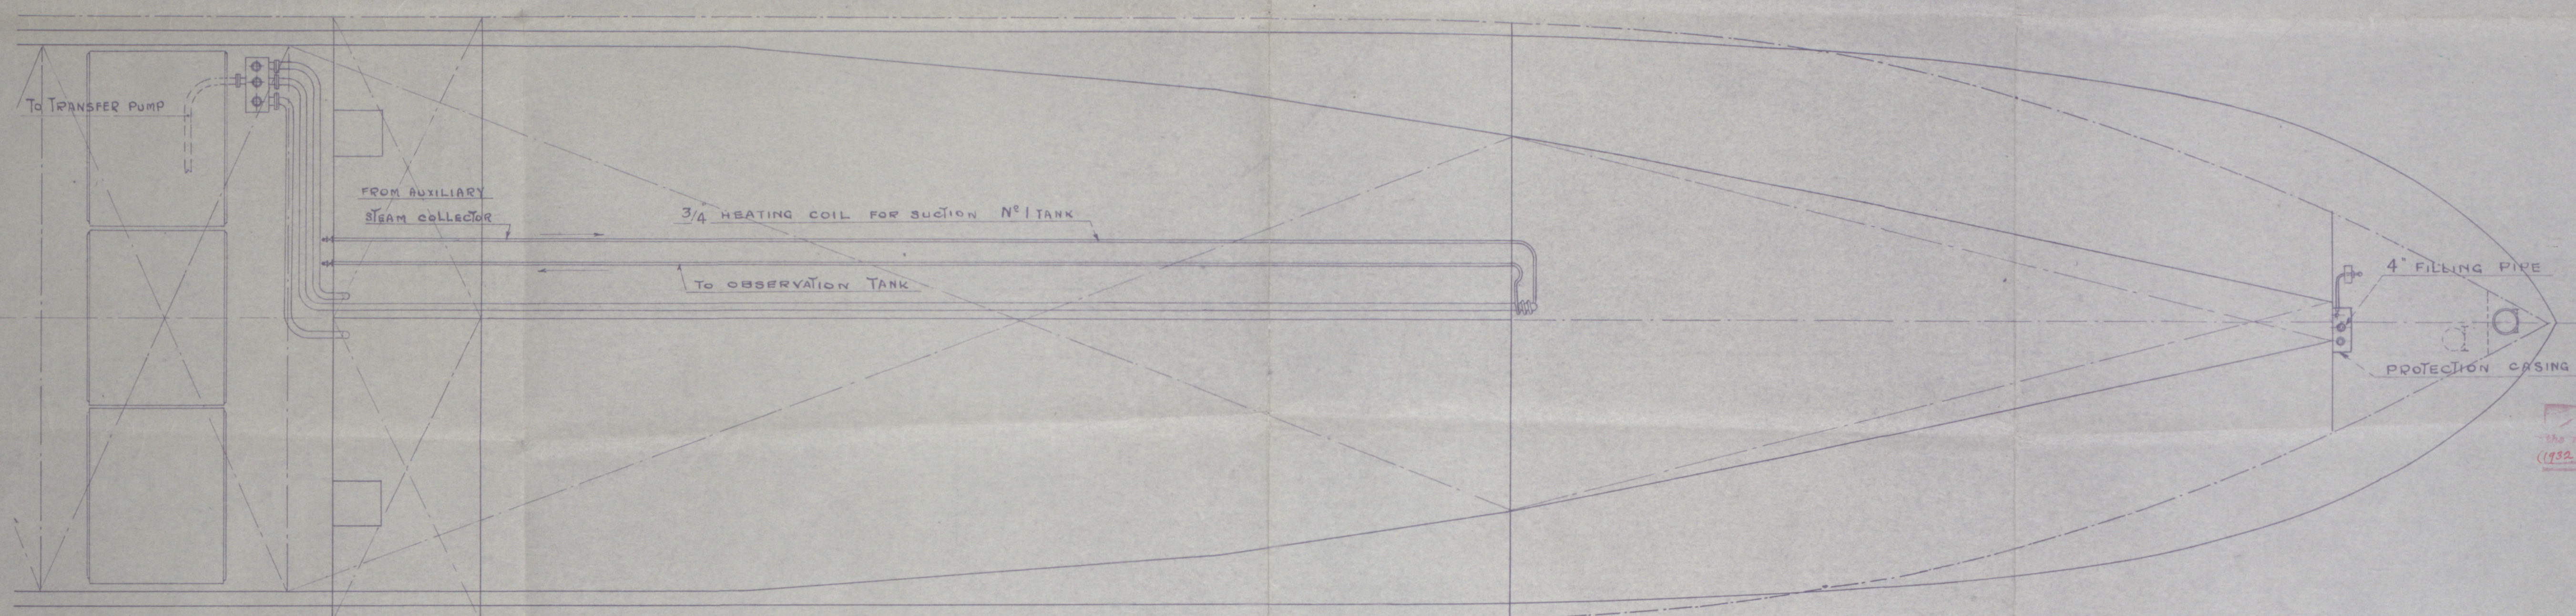


s.s. NAVEMAR..

PIPING ARRANGEMENT FOR FORE PEAK & N°1 FUEL OIL
TANKS

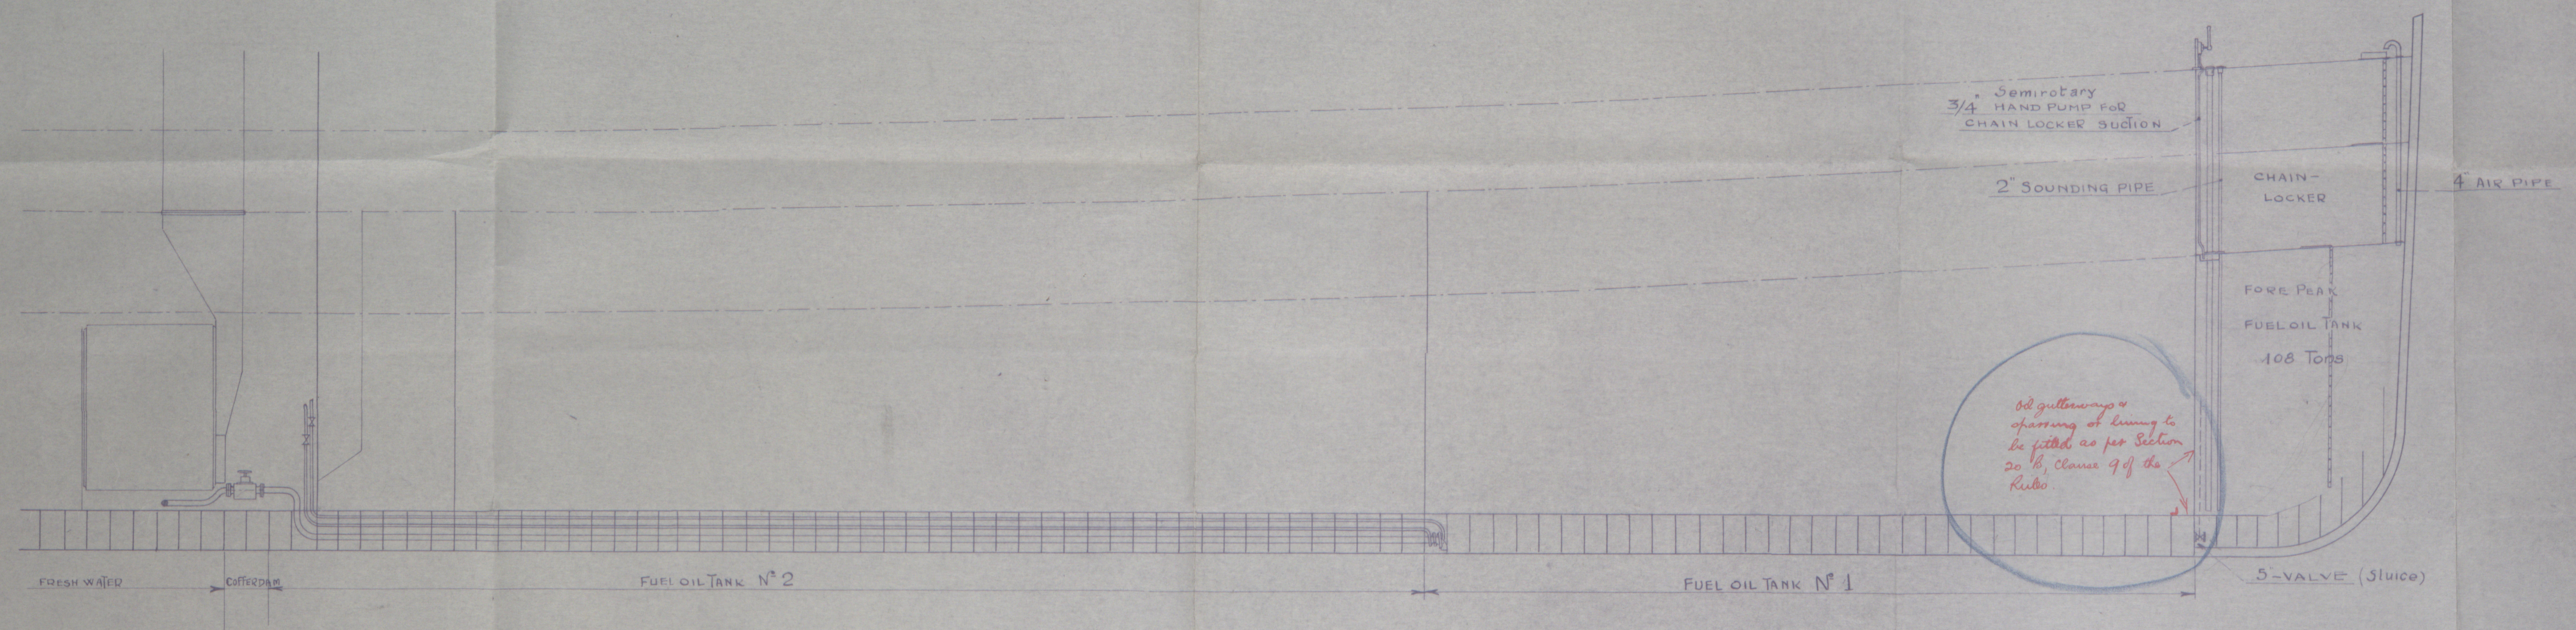

24.1.33.

The design of the oil fuel tank to be used 100°F. and the requirements of Section 50 of the Rules (1932-33) to be complied with as far as they are applicable.

cm
24/1/33
WDA

N° 5868019

SOCIÉTÉ des ATELIERS TERRIN
40, Boul. Maritime, MARSEILLE

DESSIN : SÉRIE N° 11
N° 5067
Date 23 JAN. 1933

X1200-0096



© 2019

Lloyd's Register
Foundation

Piping Arrangement.
Four Peak Tank.
St. "Haveman".



24.1.33.

Msl. report No. 8132,

HI 200 - 0096



© 2019

Lloyd's Register
Foundation