


TANK TOP PLAN.

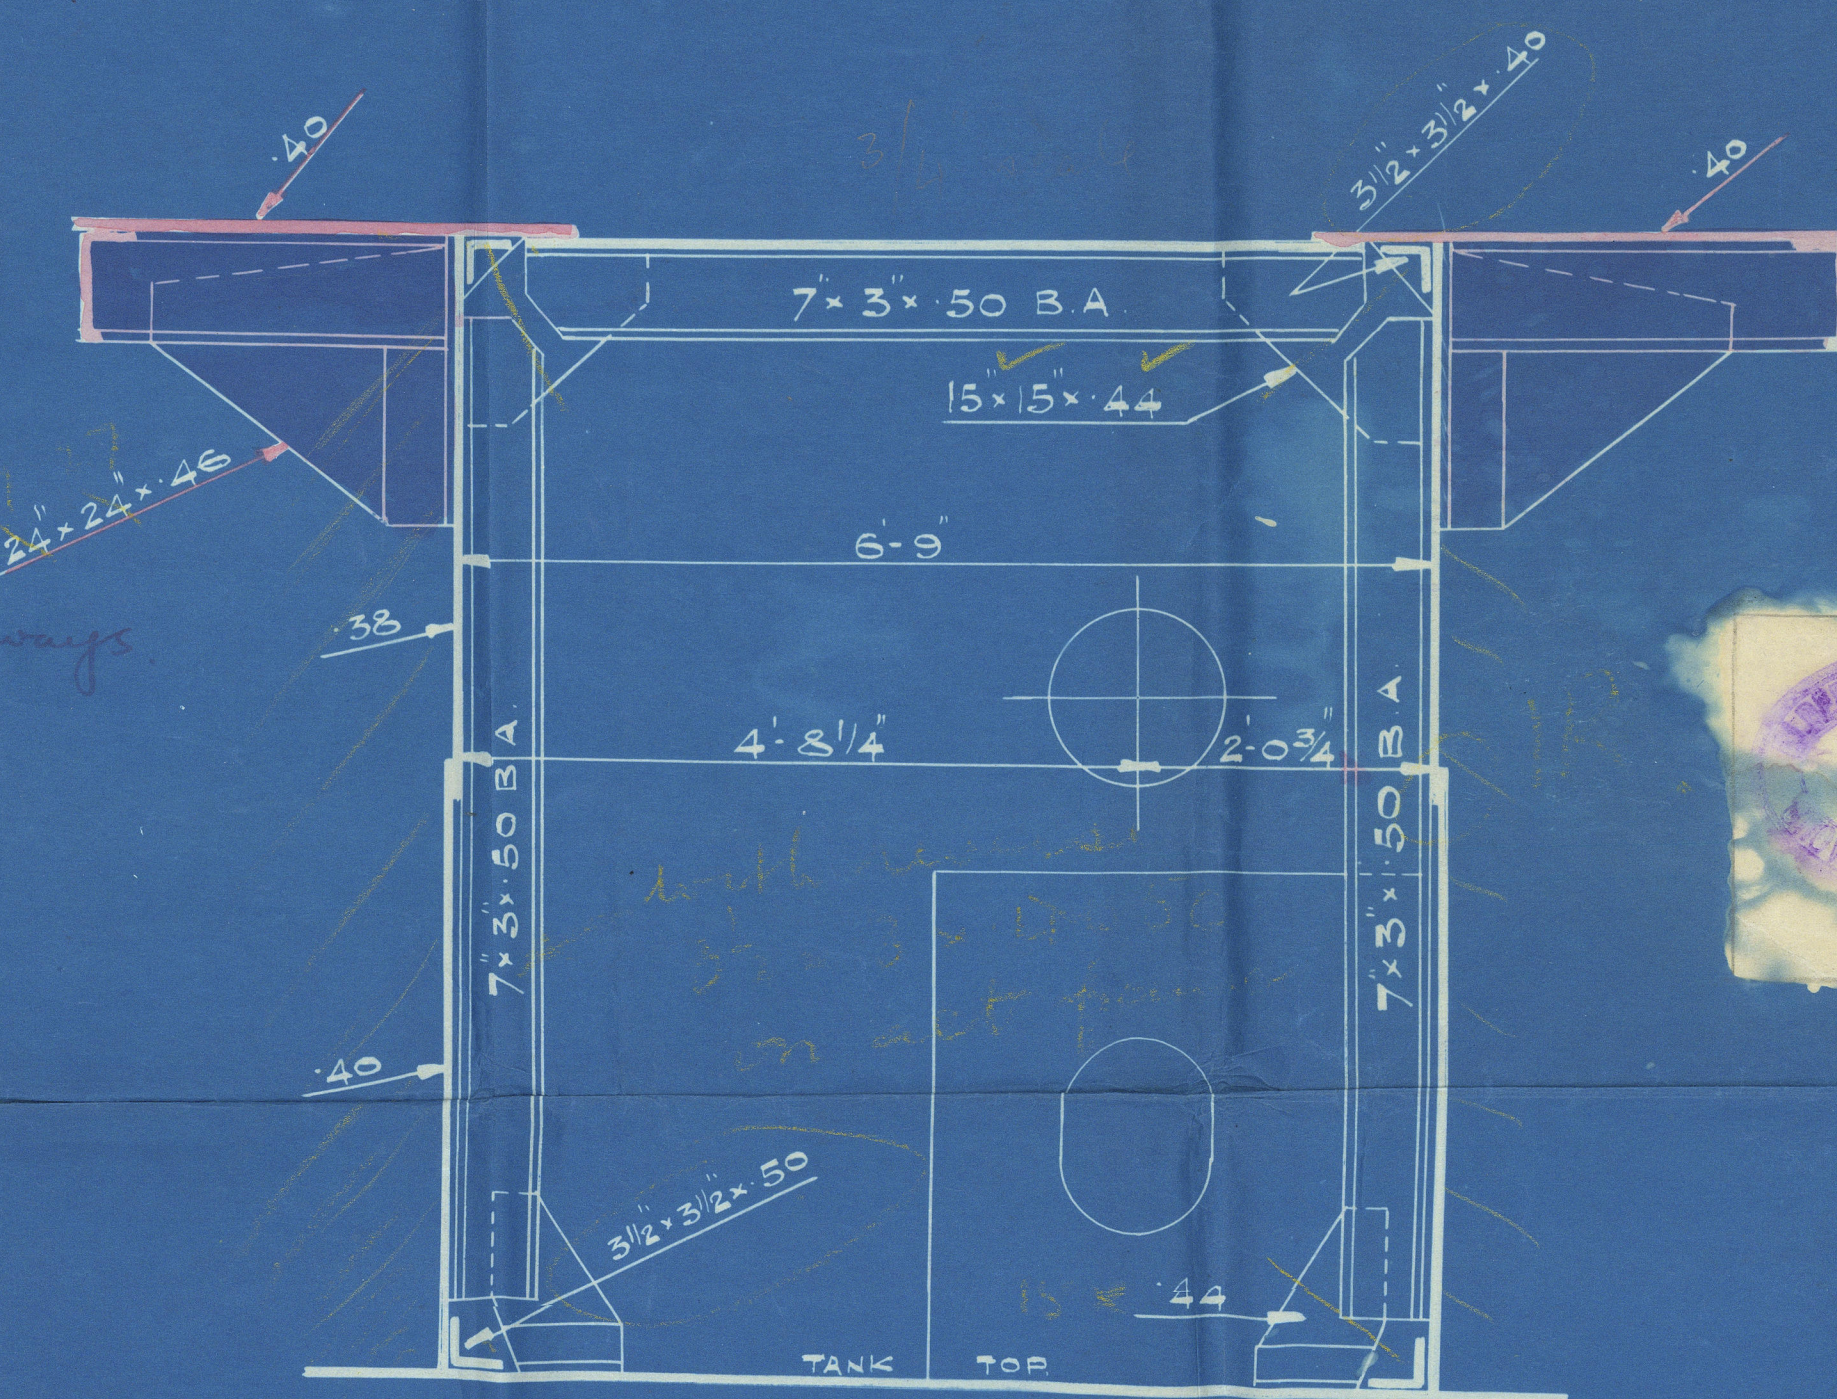

TOP OF PALM OIL TANKS


b910-001 M

Hen. Brunswick



© 2019

Lloyd's Register
Foundation

W200-0169

Shuckla House



© 2019

Lloyd's Register
Foundation

Palm oil
Tanks

Sp New Brunswick

S. S. "NEW BRUNSWICK."

NEWCASTLE ON TYNE.

Report No. 81933.

© 2019

W1200-0169
Lloyd's Register
Foundation