


S/S NIGARISTAN


SCALE 1/4" = 1 FOOT

ORIGINAL W.T. BULK HEAD FRAME 99

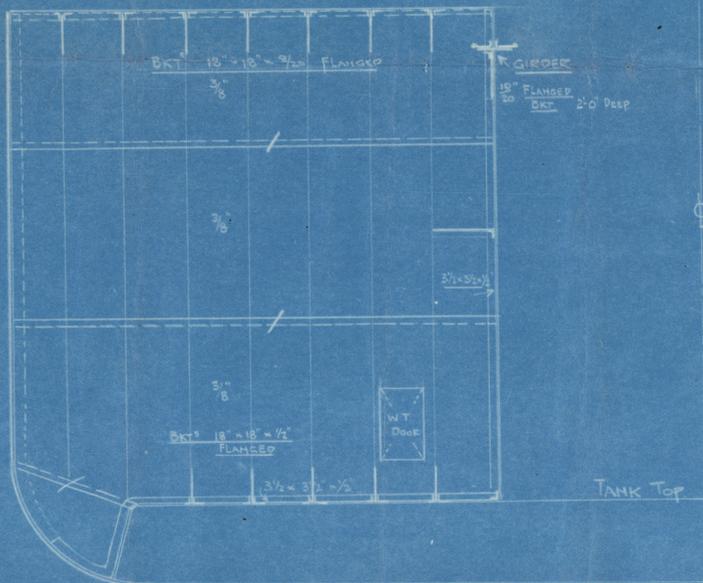

ELEVATION OF W.T. BHD (LOOKING AFT)
AT FRAME 99


PROPOSED NEW POSITION OF W.T. BHD AT FRAME 102

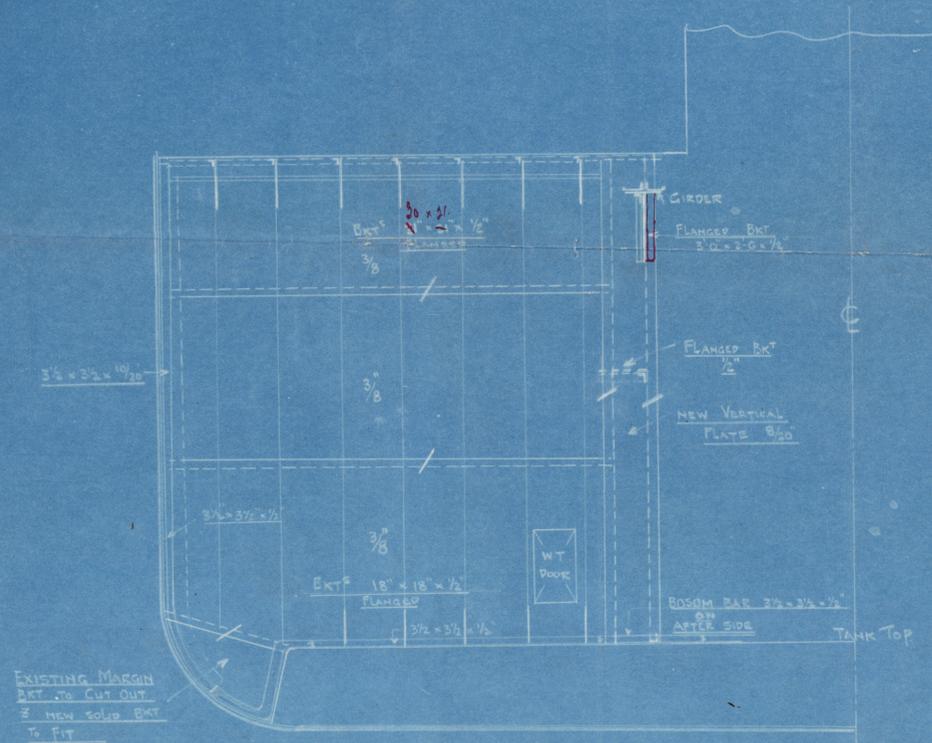


ELEVATION FRAME 102
LOOKING AFT

APPROVED
LLOYD'S REGISTER OF SHIPPING

Management per [Signature]
DATE 7. 6. 1913

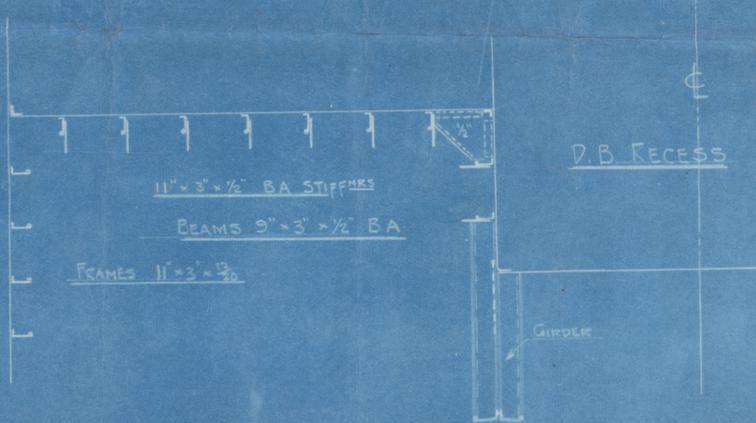

PLAN OF W.T. BHD
FRAME 99

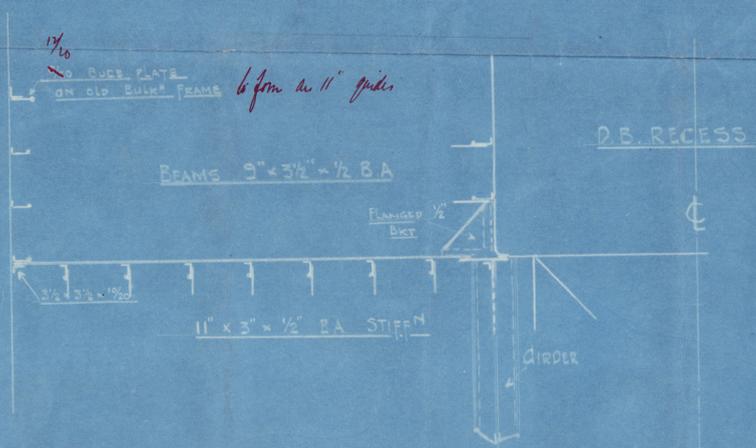

PLAN OF W.T. BHD
FRAME 102

If bulk head is moved between main & upper decks the main deck formerly the W.T. flat in way of same to be made equivalent to W.T. BHD. to arrange ratio portion

The portion of deck referred to forms part of the lower deck ballast tanks.

8/13

S.S. "Nigaritan"

Slipping W.T. bulkhead

GLASGOW REPORT No.

42840.



© 2020

Lloyd's Register
Foundation

W202-0071