




ELEVATION THRO A-B

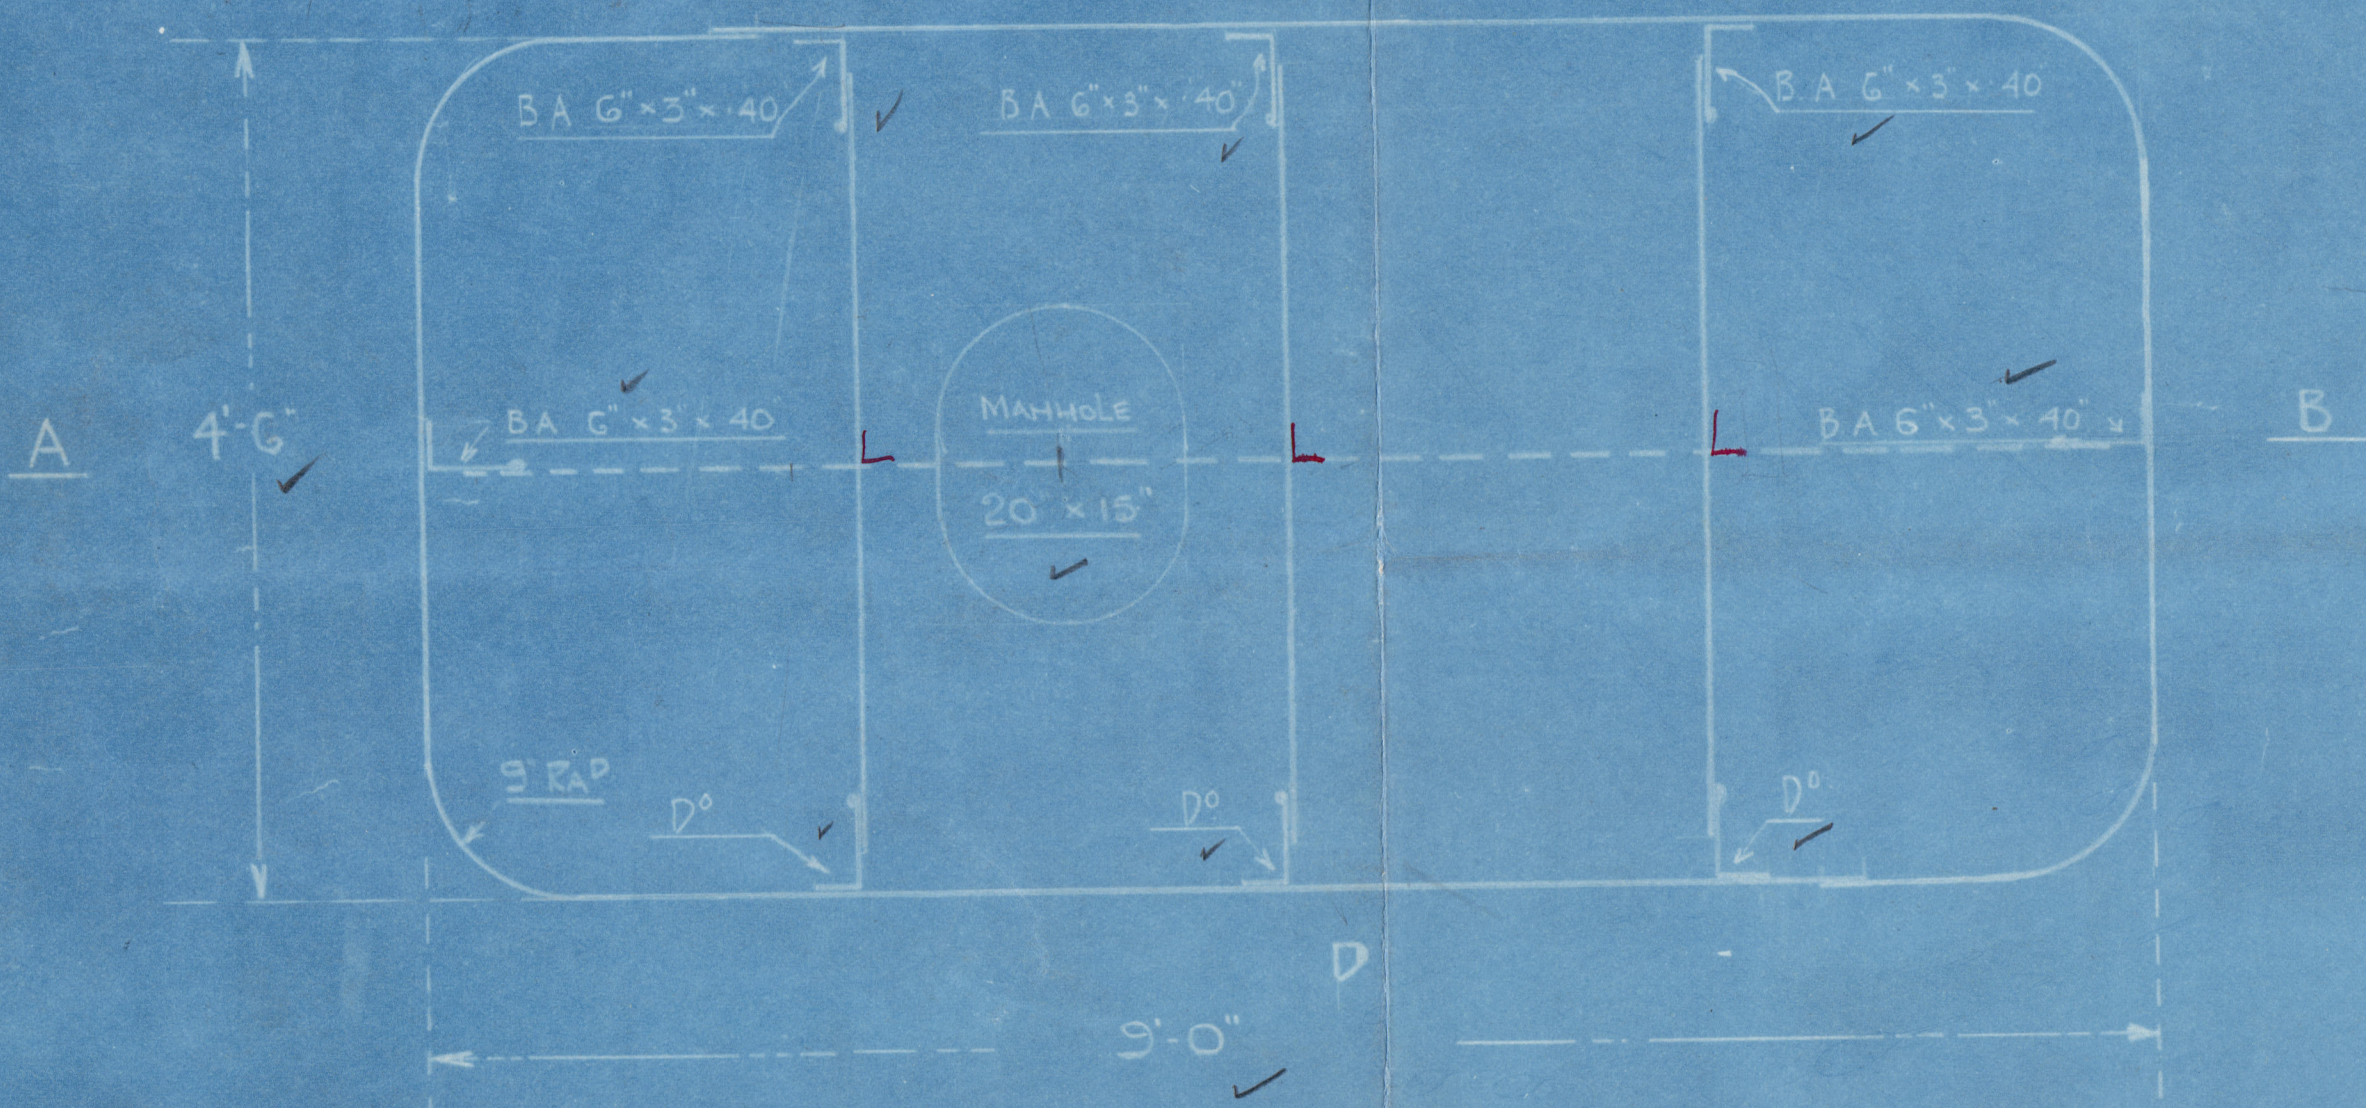

PLAN

Section 49 of the Rules for the  
building & carrying of oil fuel  
to be complied with.

APPROVED  
LLOYD'S REGISTER SHIPPING  
MANAGEMENTS per *[Signature]*  
11.6.20



SECTION THRO C-D

$\frac{5}{8}$  NIGARISTAN

PLAN OF SETTLING TANK

SCALE 1" = 1 FOOT

RIVETS IN SEAMS & IN CORNER ANGLES

TO BE  $\frac{5}{8}$ " SPACED 3 DIA'S C<sup>R</sup> TO C<sup>R</sup>

RIVETS IN STIFFS THROUGH TANK SHELL TO BE

$\frac{5}{8}$ " SPACED 4 1/2 DIA'S C<sup>R</sup> TO C<sup>R</sup>

RIVETS IN LAPS TO BE  $\frac{5}{8}$ " SPACED 3 1/2 DIA'S C<sup>R</sup> TO C<sup>R</sup>  
DOUBLE RIVETED

9/6/23



© 2020

Lloyd's Register  
Foundation

W 202-0073



S.S. "Kigarian".

Settling Tank

GLASGOW REPORT No.

42840

W/202-0073



© 2020

Lloyd's Register  
Foundation