


18. 9.13
24. 10.13
18. 11.13.
5.12.13
14. 1.14

Amended

LONGITUDINAL SECTION N°176, S.S.

DIMENSIONS 255 x 38-3E_x x 19-6DM.

SCALE 1/8"=1 FOOT.

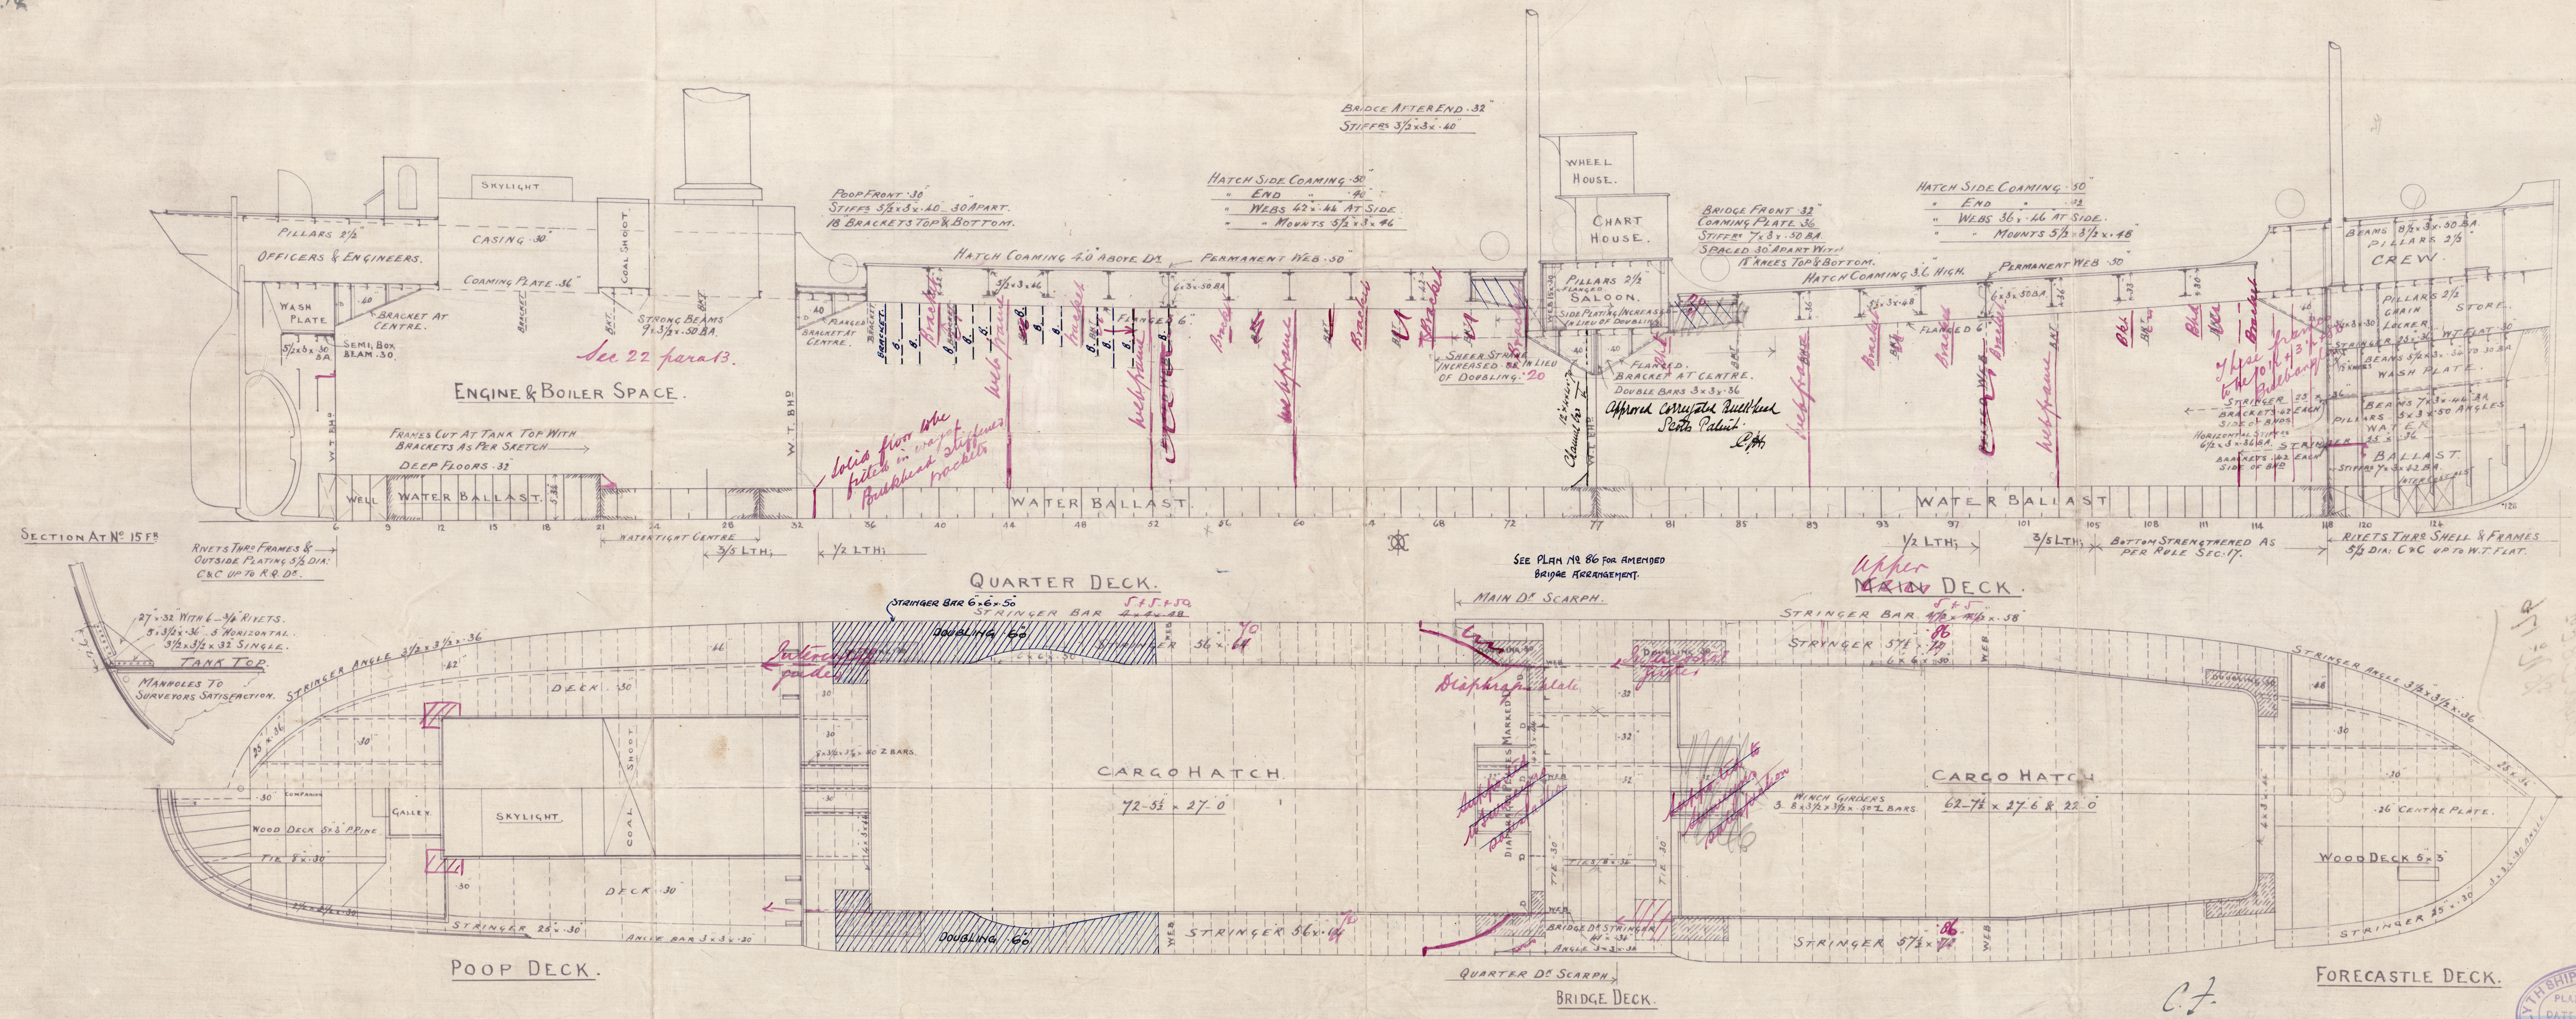



C.F.
18.9.13



Amended Profile

Blyth L.B. Co.


S/N^o 176

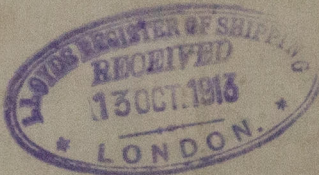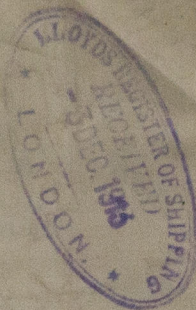

LENAX

EX

CASTILLO MONCADA

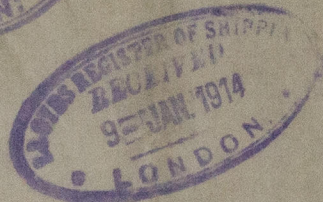

SS. AYDON

NEWCASTLE-ON-TYNE.

Report No 65962

W202-0159

W202-0159

1443
105
15487
56195
20653
562

8612
1198
16879
1571
5697
1571

3786
501
3688

1575
22



© 2020

Lloyd's Register
Foundation