

WRITTEN DIMENSIONS ONLY TO BE TAKEN

DRAWN BY J.A.S
 CHECKED BY -
 TRACED BY J.A.S
 CHECKED BY
 TRACING No 3248
 25.1.1910


CONTRACT 2147.2 OFF.
CONTRACT ~~1956.2 OFF.~~
CONTRACT ~~1967.2 OFF.~~
2032.2 OFF.
CONTRACT 2113.2 OFF.
2126.2 OFF.
CONTRACT ~~2146.2 OFF.~~

N.E.M.E.C^o L^d
C. No 2143.

MAIN BOILERS,

2 OFF

No 3190.
LLOYD'S TEST
360 LBS.
16-2-14 W.B.,

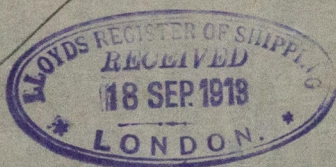

BLYTH SBC^o No 1 J6 ⁵/₃.

DUP C. N. 2146.

S. S. Aydon

Slip No 26062

N.N. Castillo Moncada

W/202-0160