


26.8.08

# PROFILE & DECK PLAN STEEL SCREW STEAMER N° 444

DIM<sup>s</sup> 115'-0" x 22'-0" x 9'-0 1/2" MOULDED

SCALE 1/4" = 1 FT.

PILLARS THROUGHOUT TO SURVEYOR'S SATISFACTION

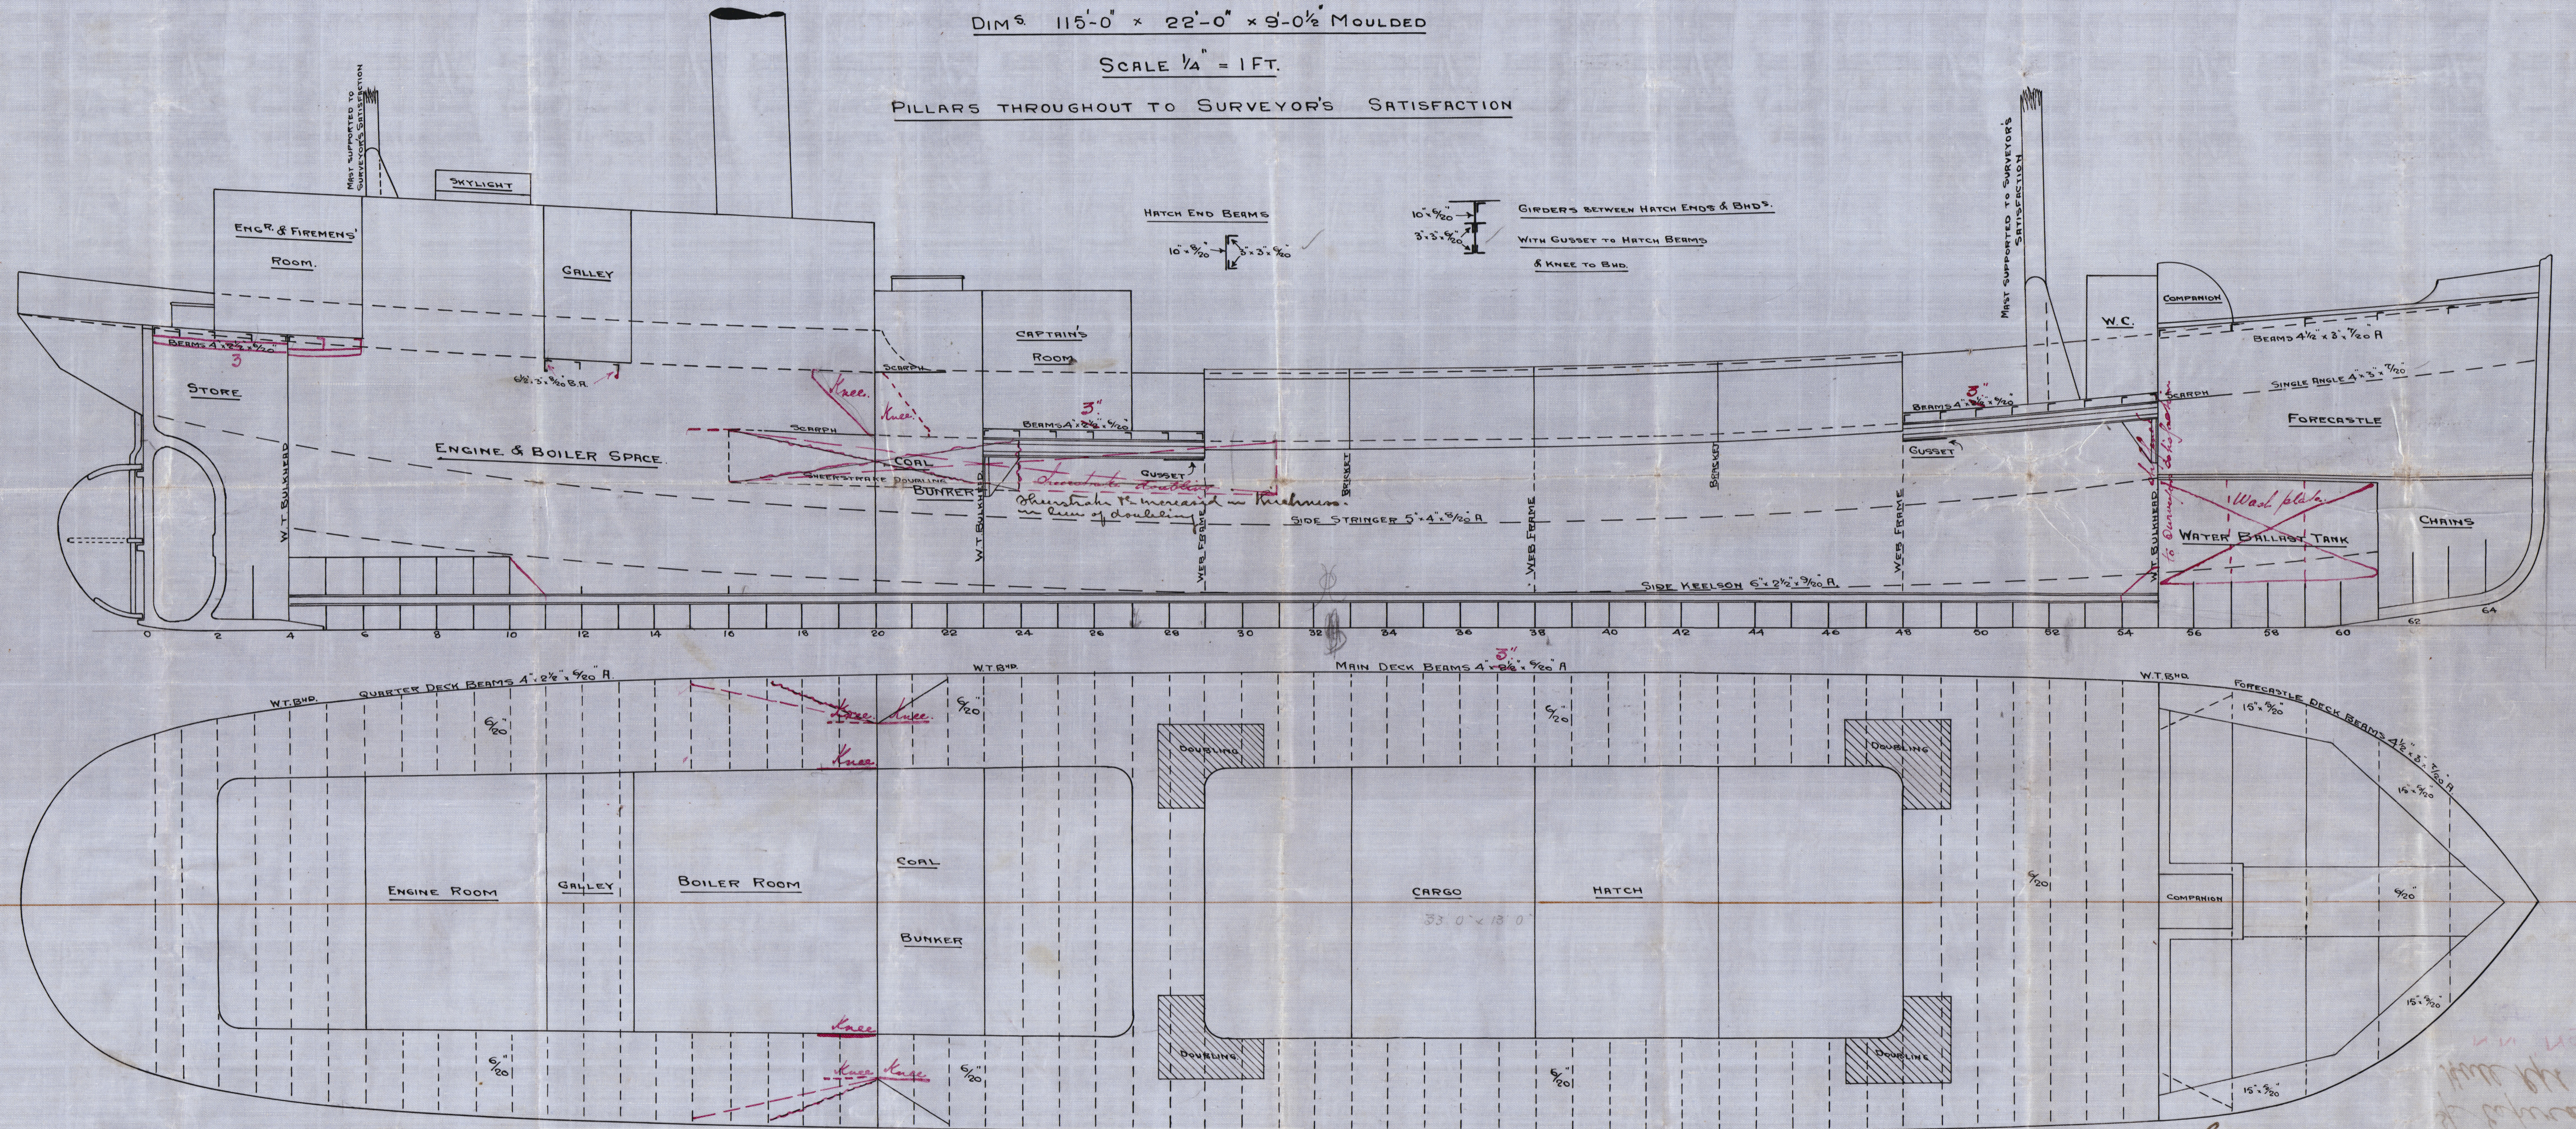

C.B.  
26.8.08.

water & gear 6000

W 203-0045

Schroeder & Co

Nº 444

Profile & Deck Plan.

Sp Esperanto

Hull Rpt No. 20695

N.N. NORWICH

TRADER

W203-0045



© 2020

Lloyd's Register  
Foundation