


76.8.08

N^o 444 MIDSHIP SECTION

STEEL SCREW STEAMER.

DIMENSIONS. 115'-0" x 22'-0" x 9'-0 1/2" M.L.D.

CLASS 100 A.1 AT LLOYDS


SCALE 1/2" = 1 FOOT.

NUMERALS		
1/2 GIRTH	18.50	
1/2 BREADTH	11.00	
DEPTH	9.54	
39.04 1 st NUMERAL		
LENGTH AS PER RULE 113.87		
44454848.2 nd NUMERAL		
9" x 34.0 x 30.2	204.0000	
10" x 18.0 x 30.2	108.0000	
47574848.	equival NO	

PROPORTIONS		
BREADTH TO LENGTH	5.1	
DEPTH	11.93	

EQUIPMENT.		
2 BOWER ANCHORS	5 CWTs EX STOCK OR 6 1/2 CWTs SPECKLESS	
1 STREAM ANCHOR	1 1/4 " " "	
1 KEDGE	3/4 " " "	
135 FATHOMS	1/8" STWD LINK CABLE.	
15	2 1/4" STEELWIRE OR 6" HEATP.	
45	2" STEELWIRE OR 1 1/2" STWD LINK CHAIN	
90	4" HEATP.	

RIVETING FORWARD OF 1/3 L TO BE AS PER SEC 12A. PARA 1.
 AND BOTTOM STRENGTHENED AS PER SEC 12A.

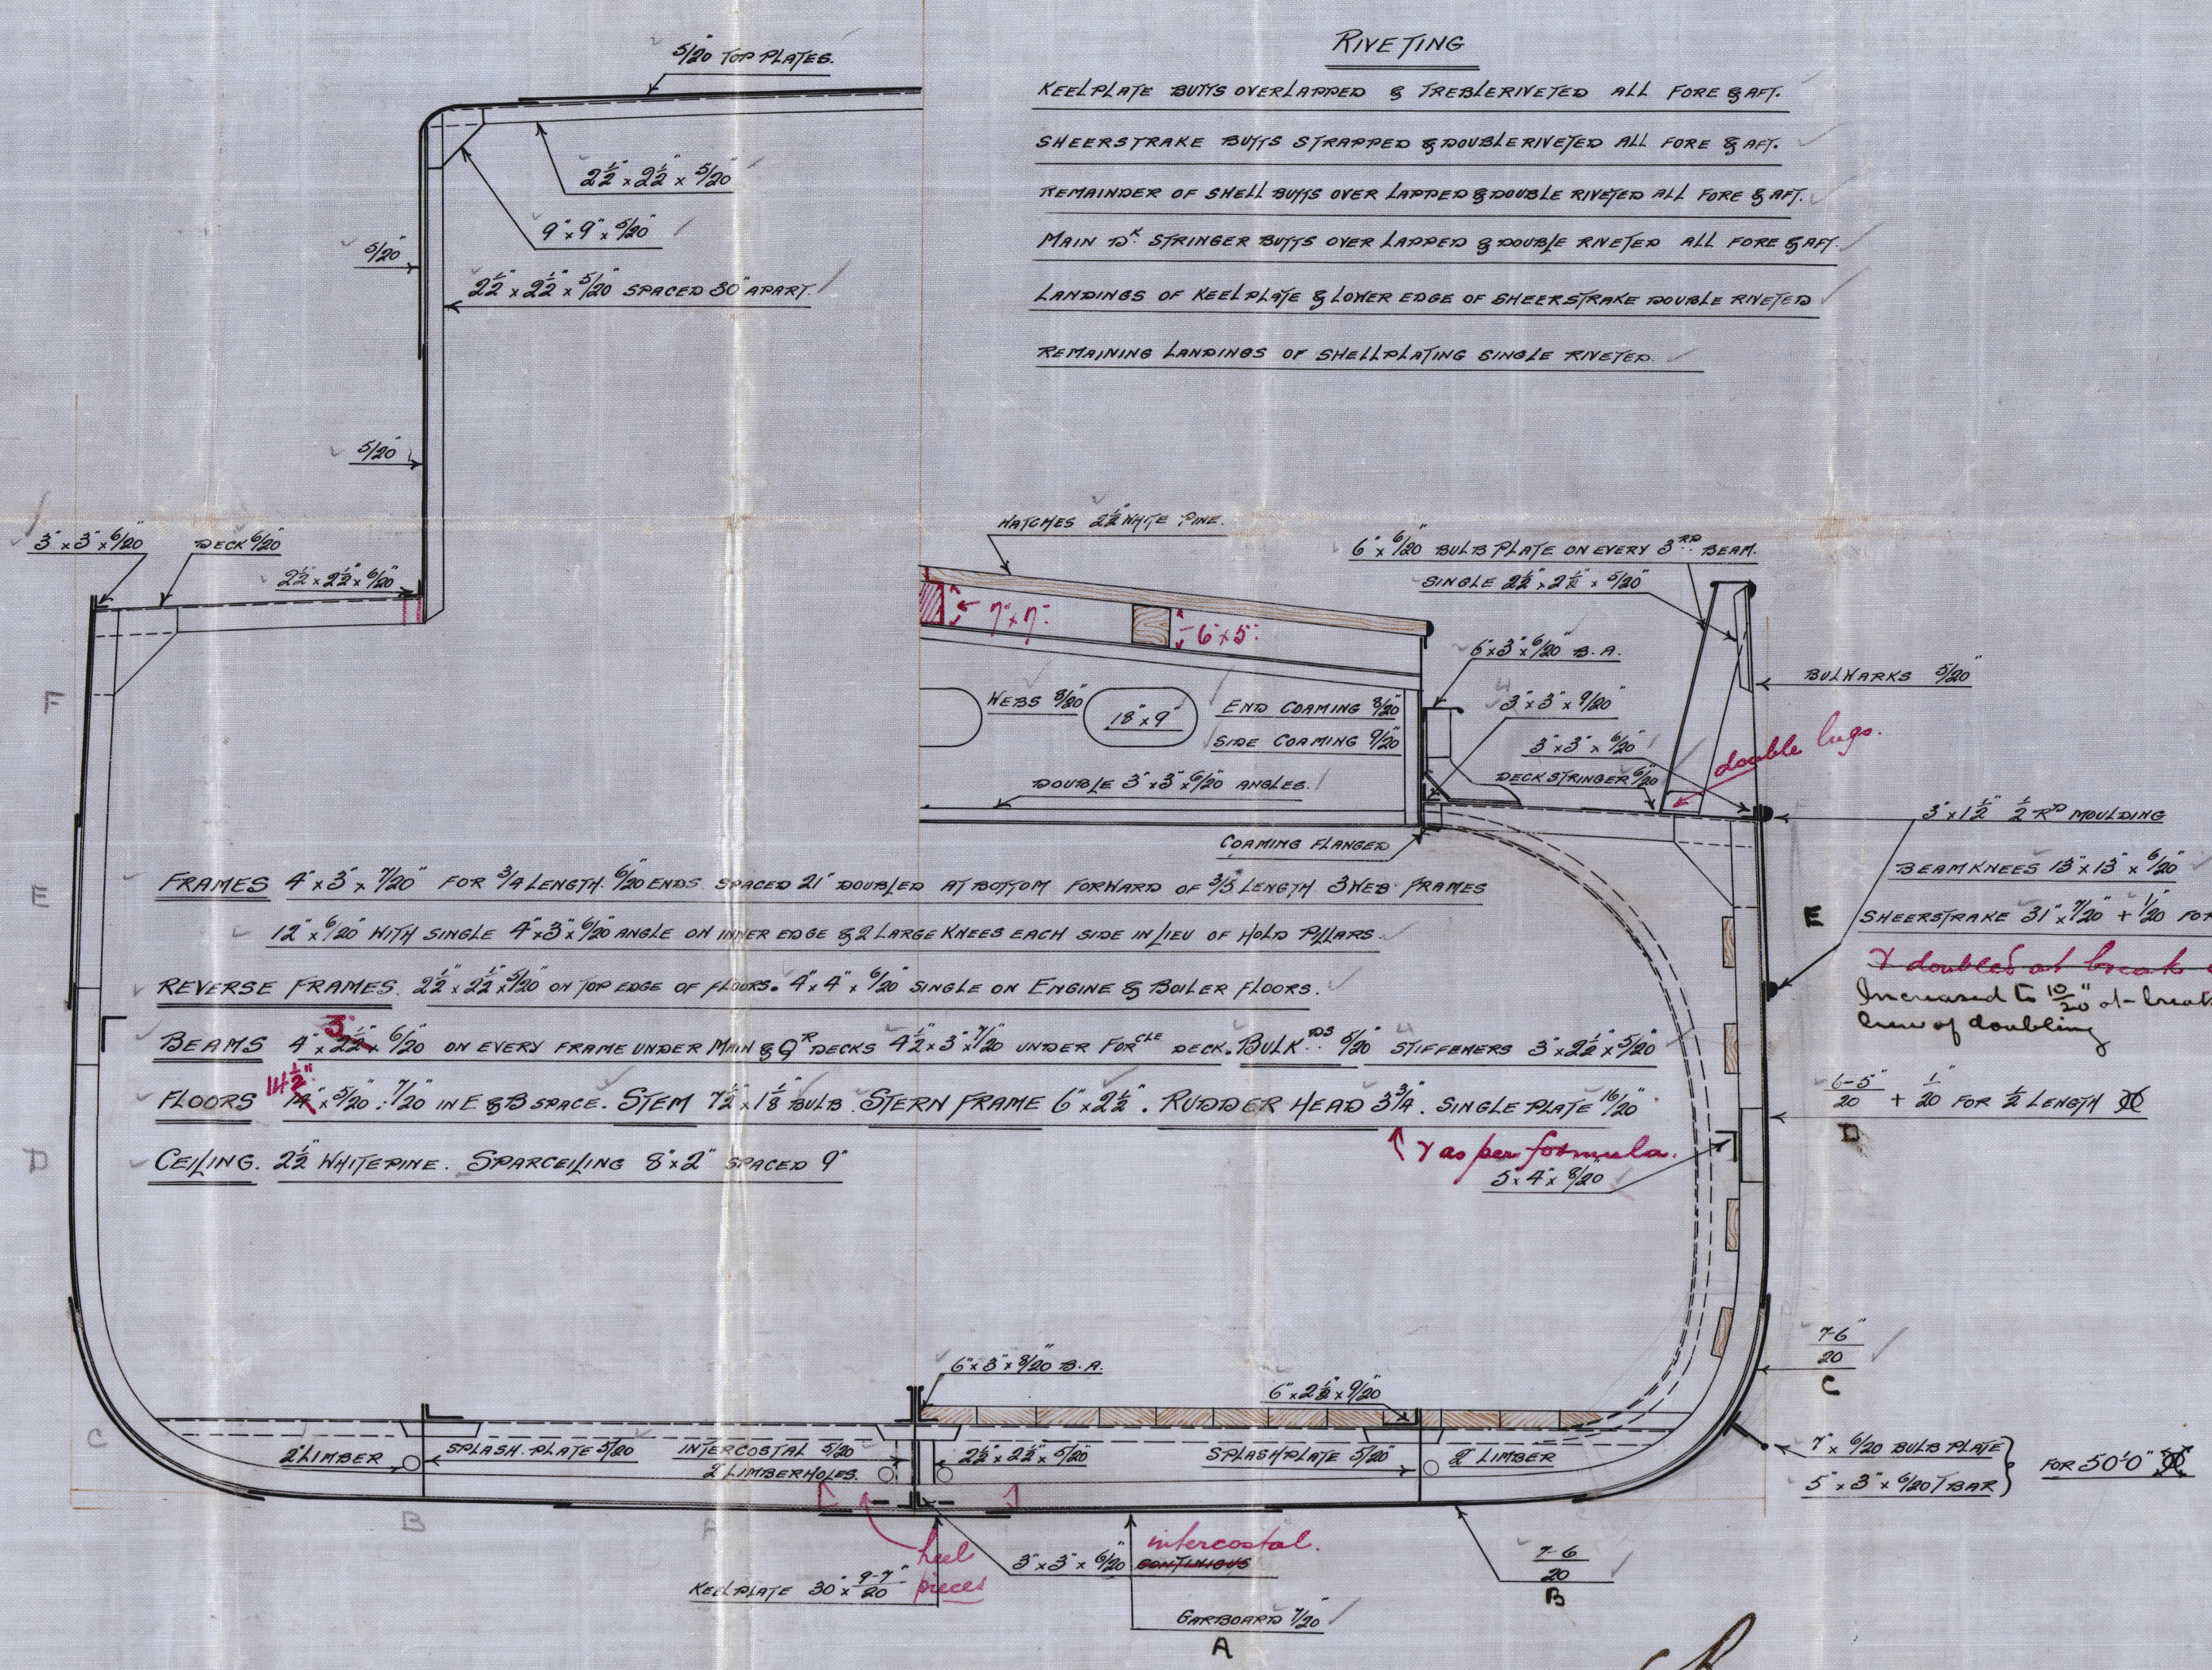

RIVETING
 KEEL PLATE BUTTS OVERLAPPED & TREBLERIVETED ALL FORE & AFT.
 SHEERSTRAKE BUTTS STRAPPED & DOUBLERIVETED ALL FORE & AFT.
 REMAINDER OF SHELL BUTTS OVER LAPPED & DOUBLERIVETED ALL FORE & AFT.
 MAIN 10\"/>

C.B.
 26.8.08

Cochrane & Sons.

Nº- 444.

Midship Section.

Esperanto

Hull Report No. 20695

N.N. "Norwich Trader"



© 2020 0046

Lloyd's Register
Foundation