






Vickers Armstrongs 712

Revised Midship Section

T S S ORCADES  
BARROW REPORT 2662

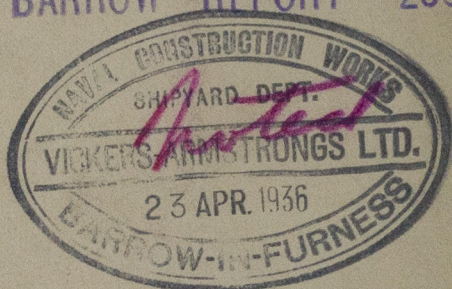

© 2020

Lloyd's Register  
Foundation

W204-0227