




Horizontal # 3 (3rd side)  
for fore end of pump room trunk  
Scale 1/4" = 1'-0"

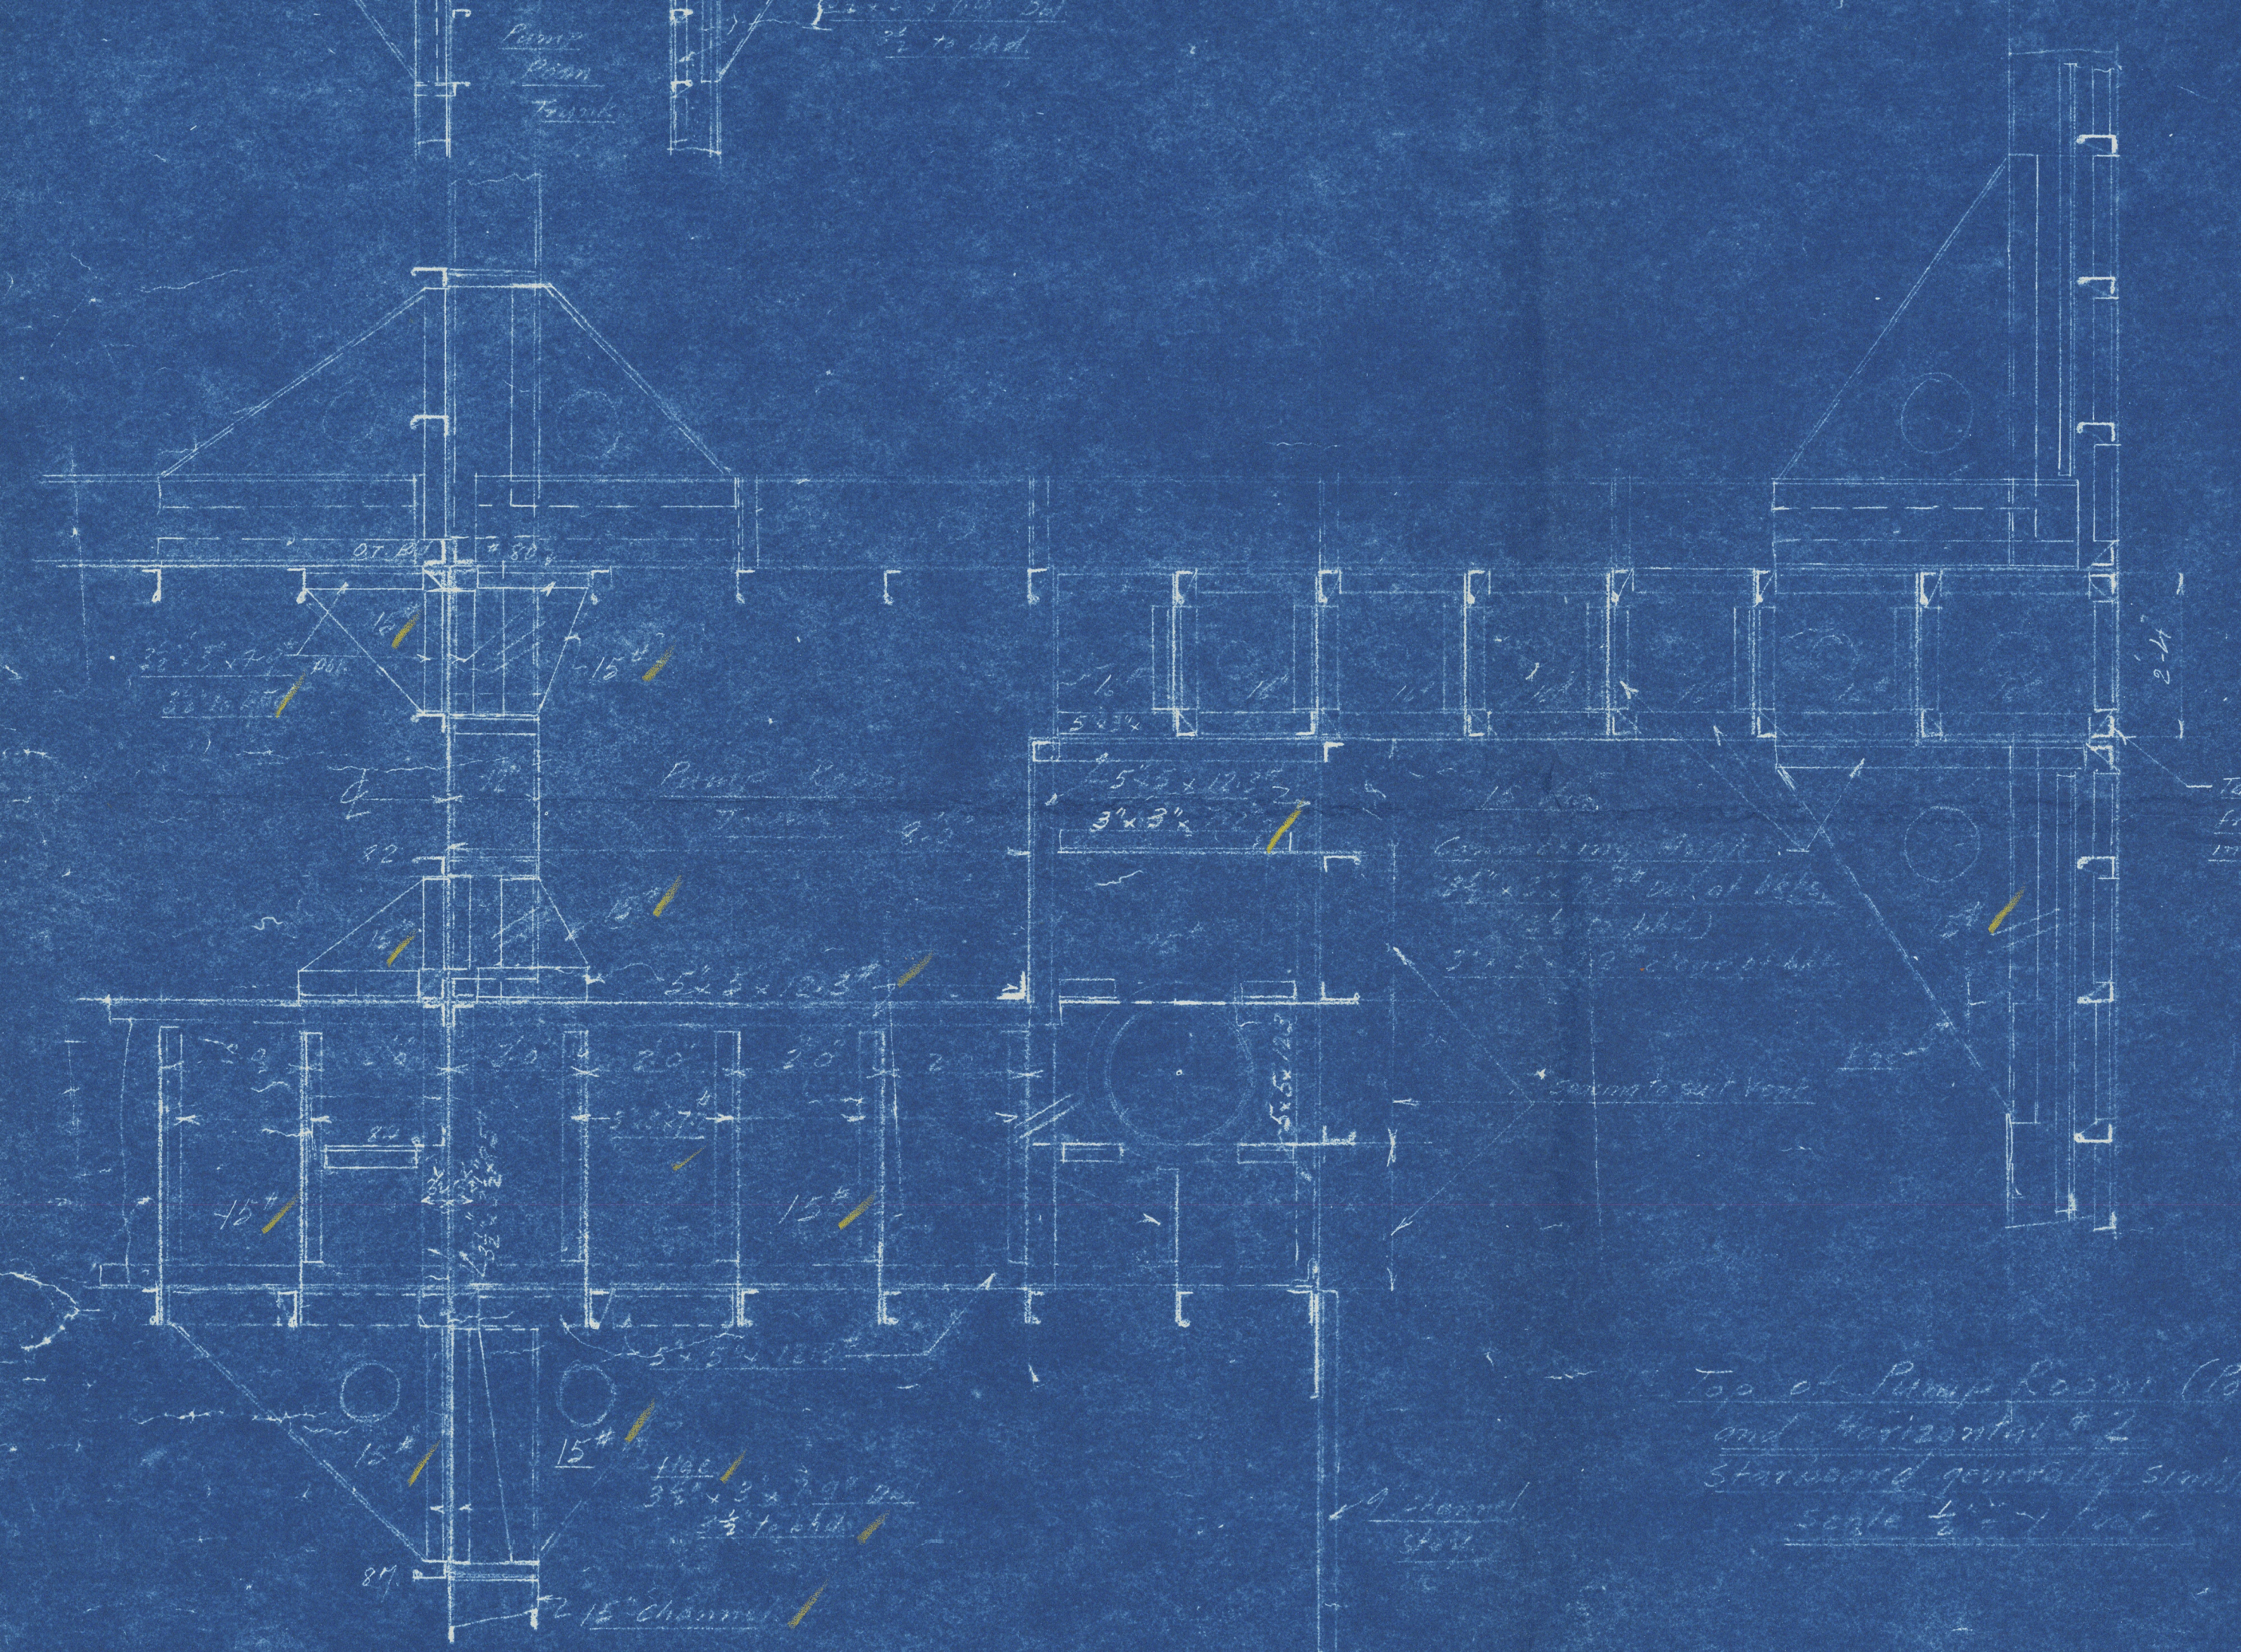


Scale 1/4" = 1'-0"

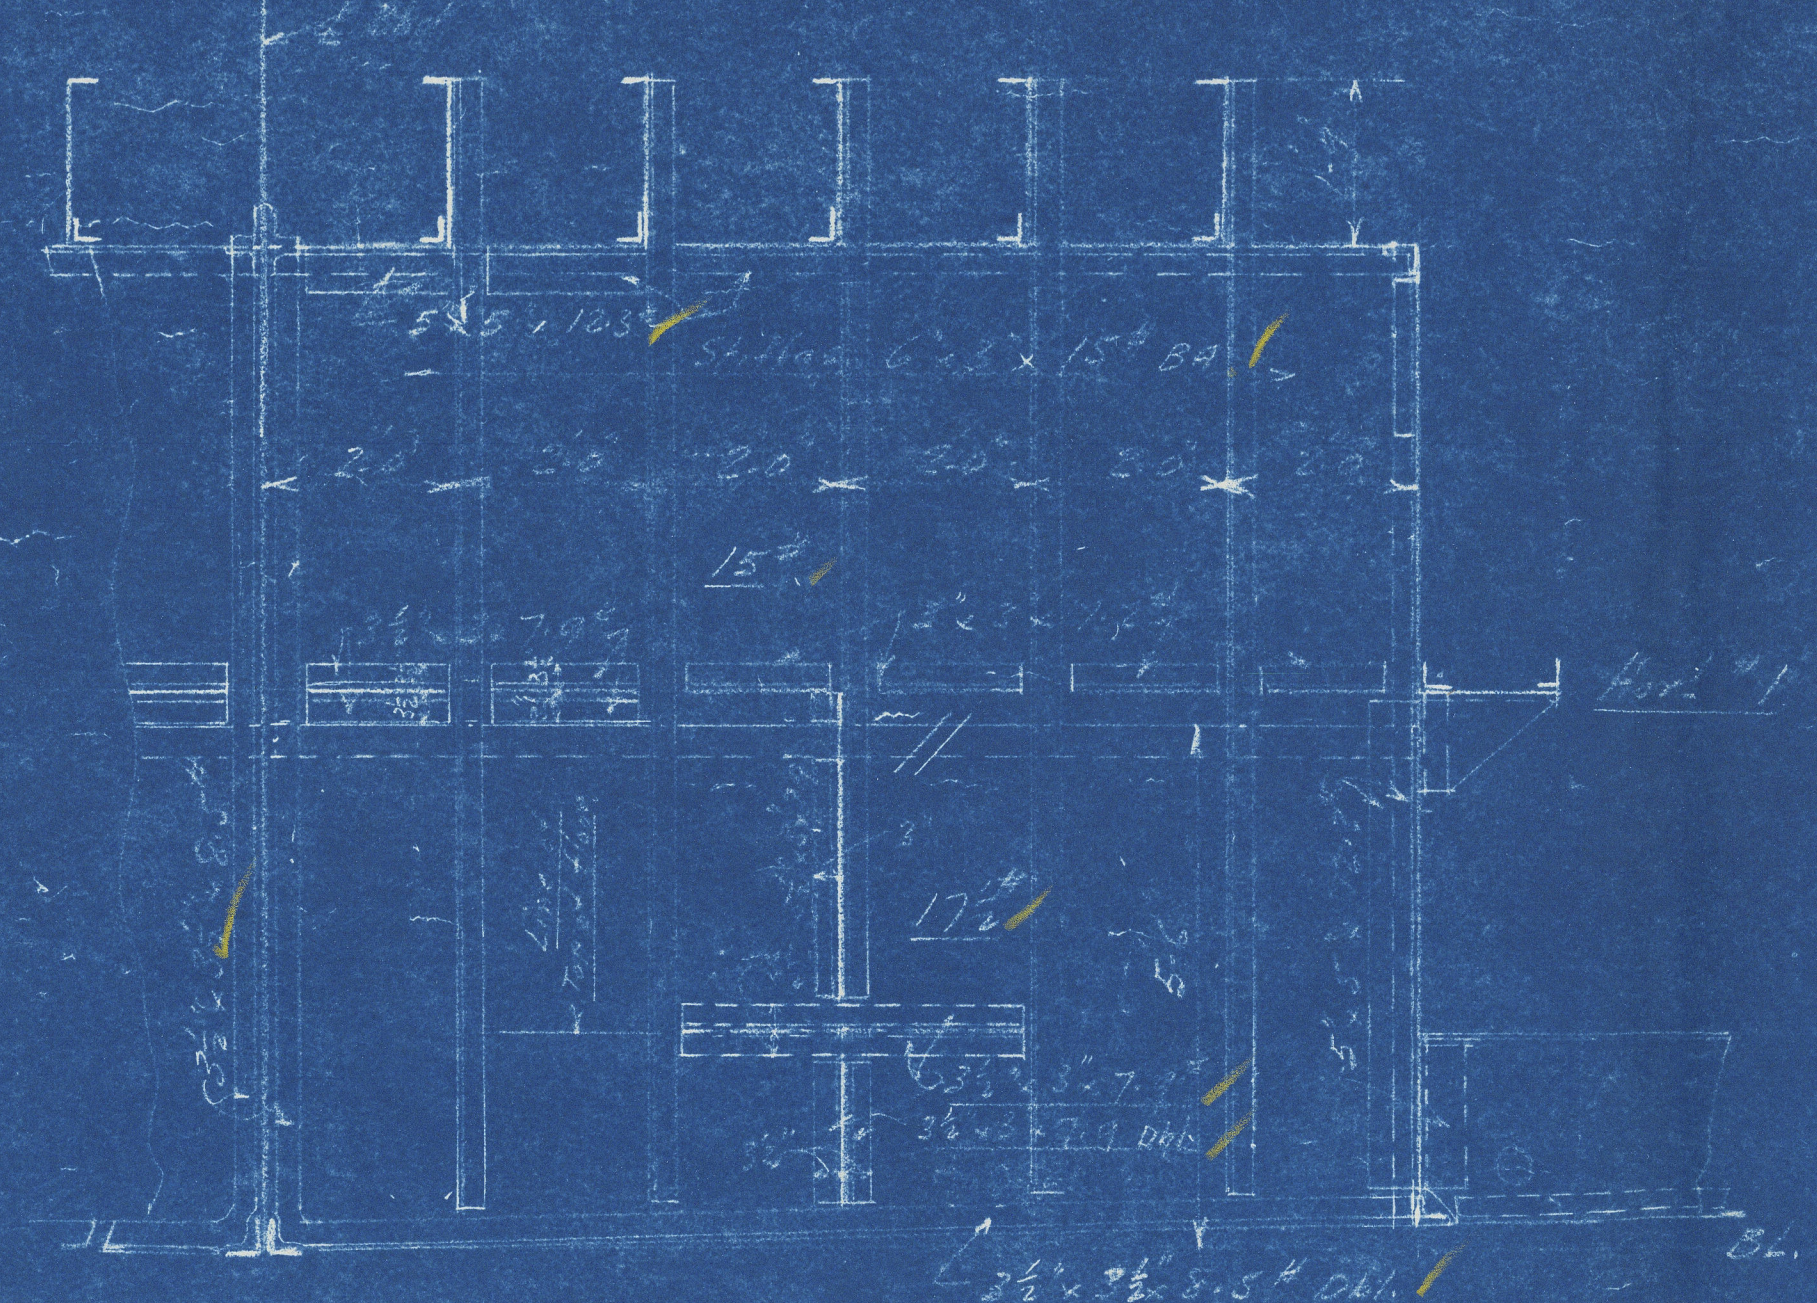


Fore End of Pump Room  
Back side shown (Standard similar)  
Scale 1/4" = 1'-0"

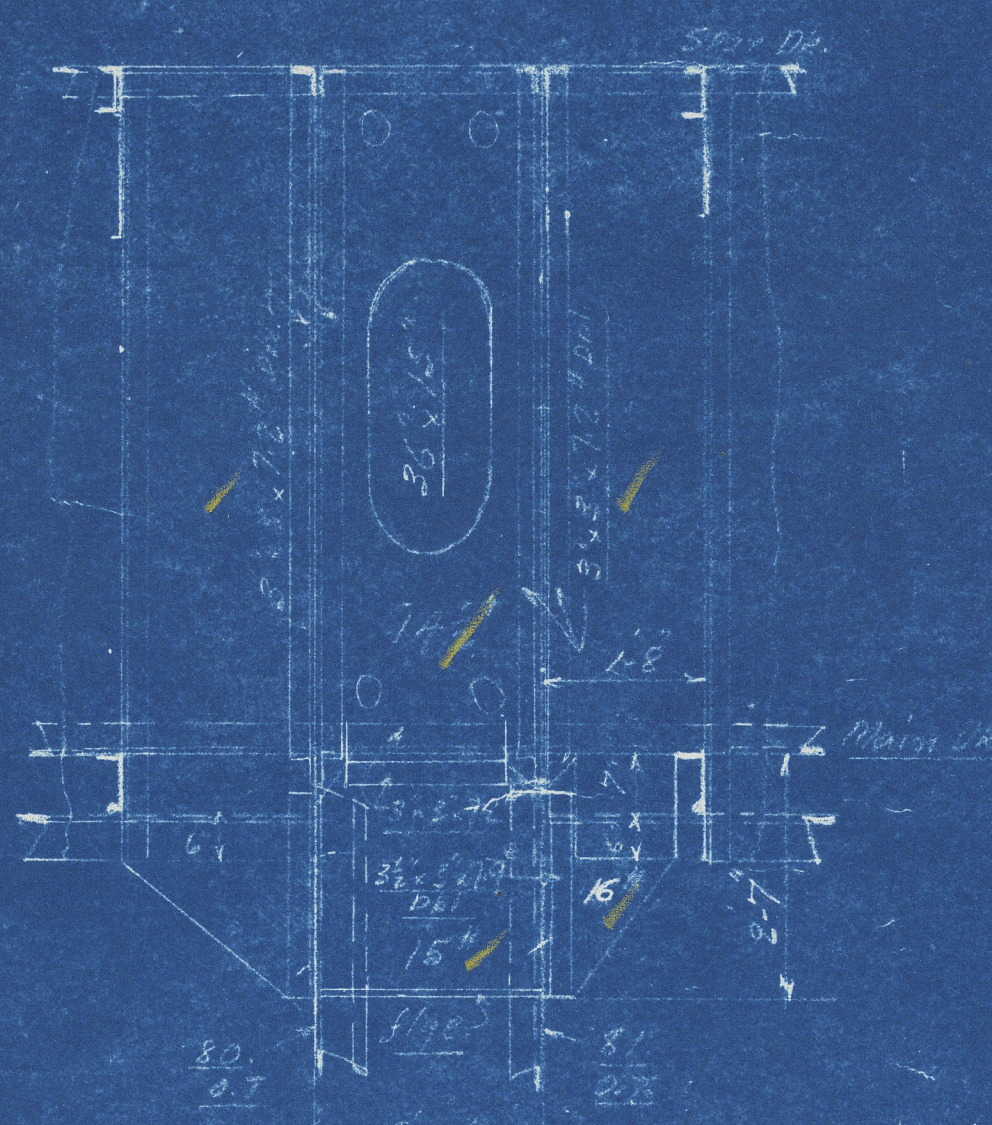


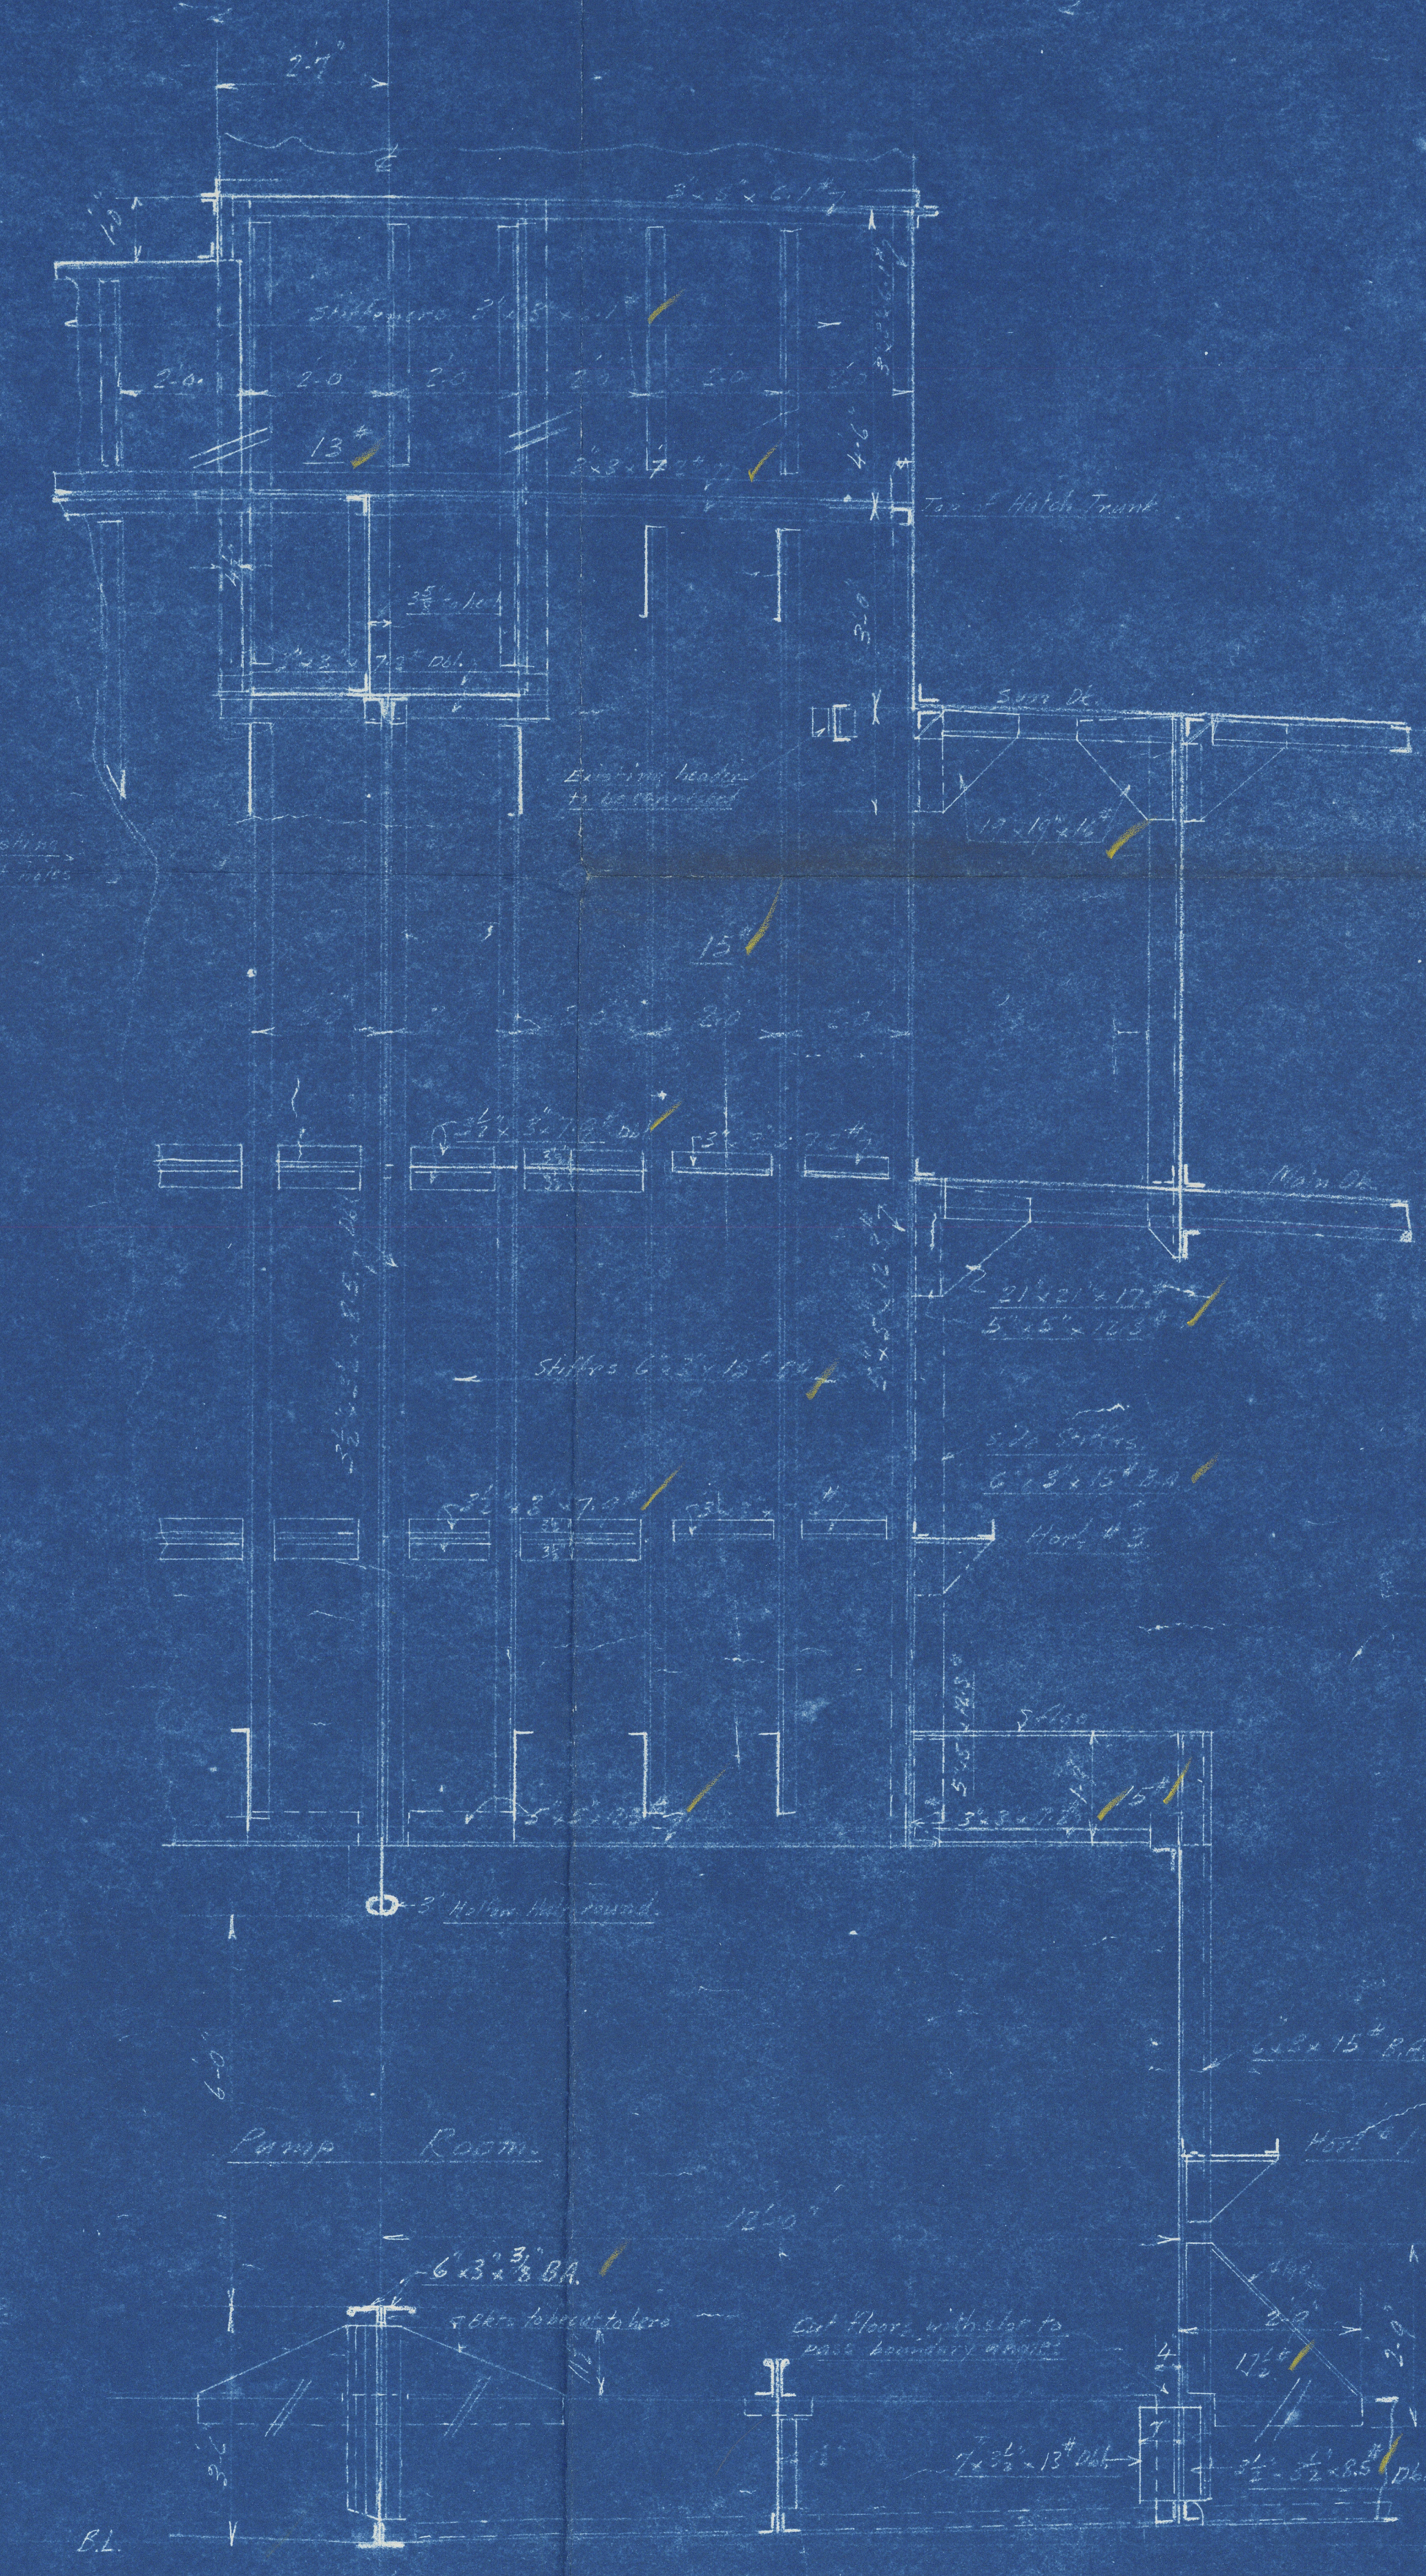


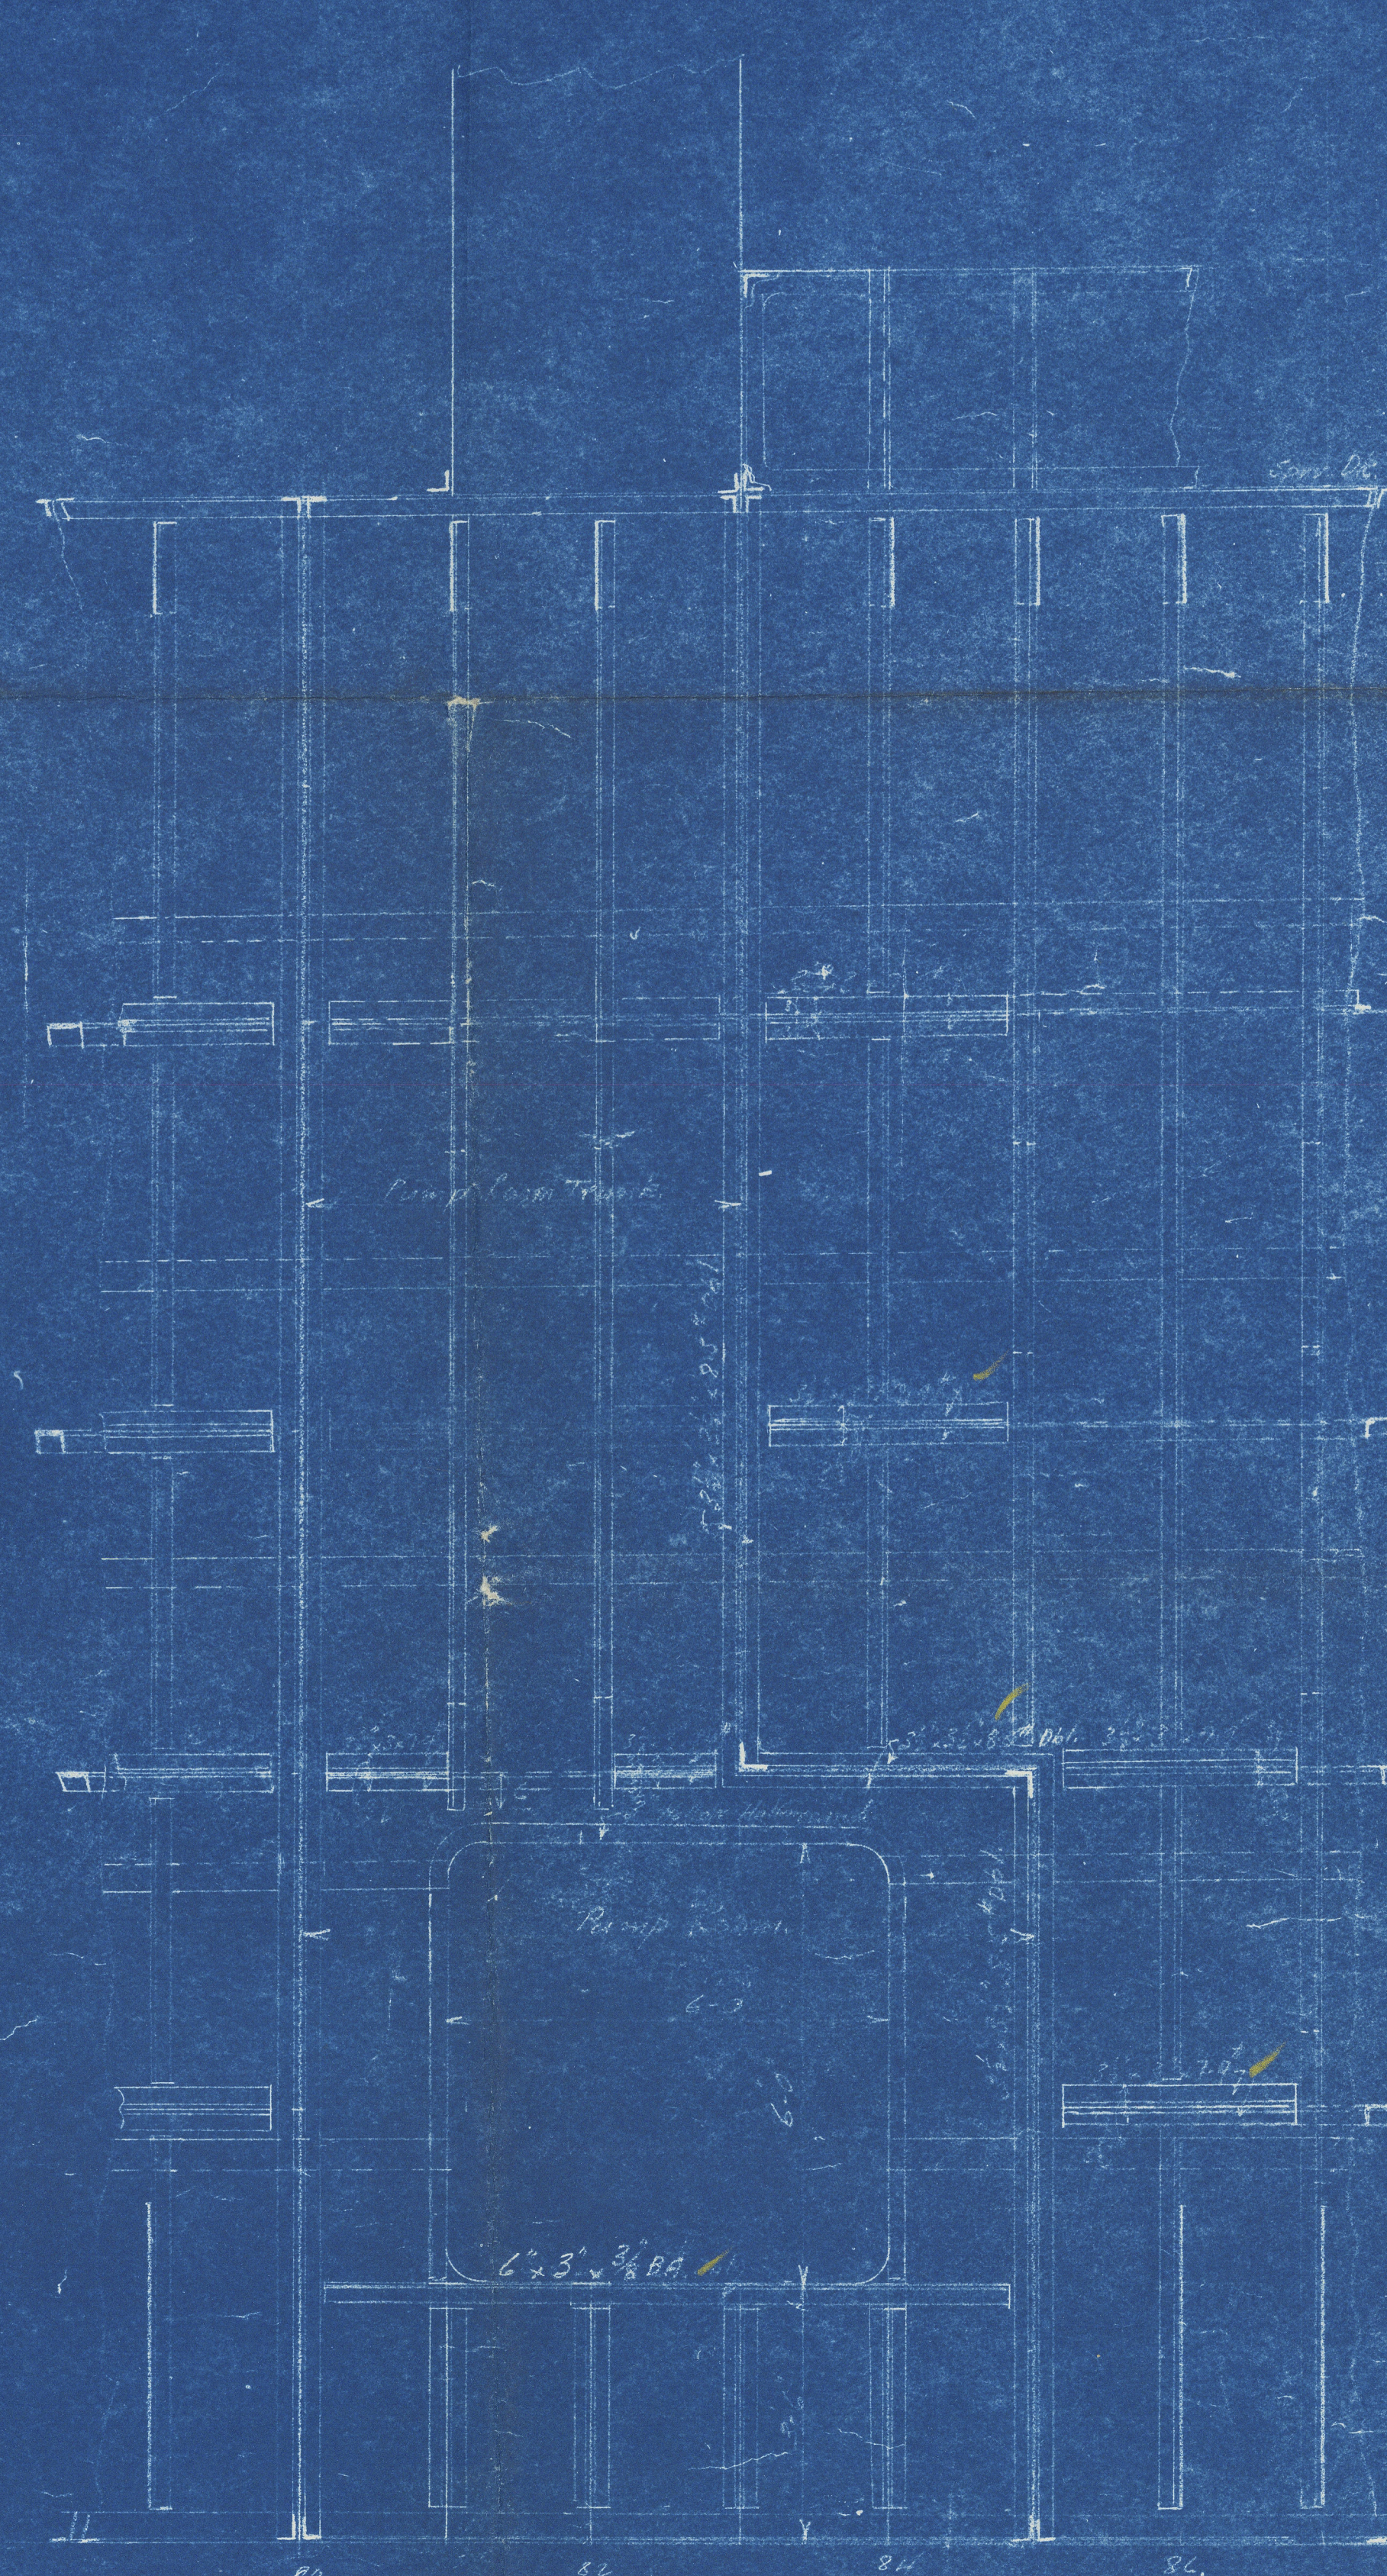

Fore End of Pump Room  
Back side shown (Standard similar)  
Scale 1/4" = 1'-0"


General Note:  
Existing stiffeners shall  
be removed to permit  
erection of new  
stiffeners at his discretion.


STANDARD TRANSPORTATION COMPANY CONSTRUCTION DIVISION 26 BROADWAY, NEW YORK, U.S.A.	
NEW COFFERDAM & PUMP ROOM AT AFT END OF #4 TANK - SHEET NO. 2	
APPROVED	DATE 4-10-33
CHECKED	DATE 4-10-33
FILE NO. 333-582B	

W206-0210