


ALTERATIONS
OCT. 14-12 WEB FRAMES ADDED

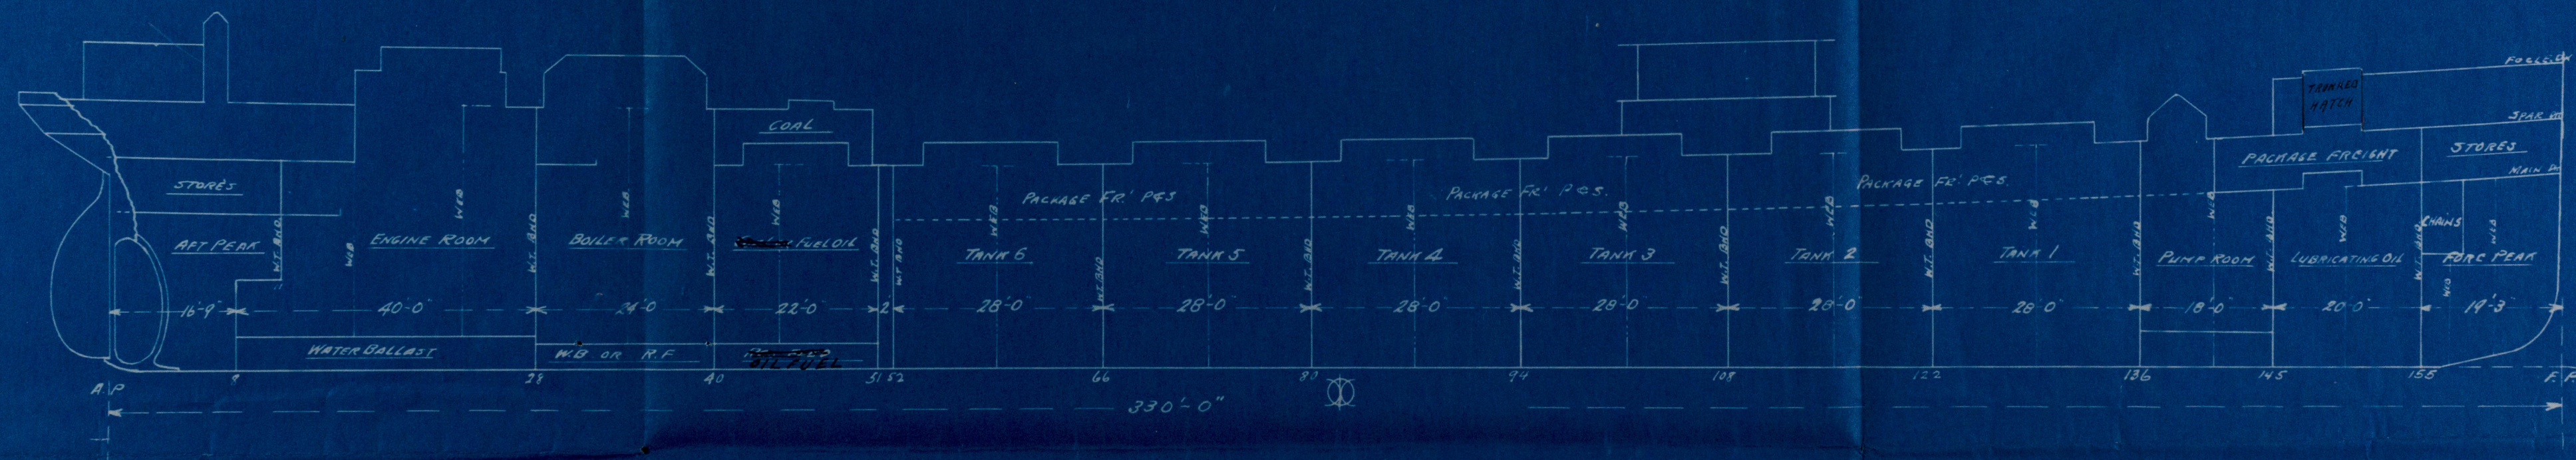

- 12 11/10/13
- 13 11/10/13
INBOARD PROFILE

SCALE 1/8" = 1 FT. MADE BY E.P. 29 SEPT. 1911

NEW YORK SHIPBUILDING CO.
CAMDEN, NEW JERSEY

DR. NO. 123-202-A

2. H. BIGG, MAR. ARCHT.


W206-0236

NEW YORK SHIPBUILDING CO.,
CAMDEN, N. J., U. S. A.
BLUE PRINT ROOM

Print No. 13

Made APR 2 1913

For Dep't Lloyds

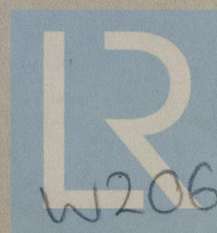

© 2019

Lloyd's Register
Foundation

W206-0236