

Pegasus

Phl. 2009


W206-0237



© 2019

Lloyd's Register
Foundation

FOR
MADE NOV 15 1911
PRINT No. 20
N. Y. SHIPBUILDING CO.
CAMDEN, N. J.

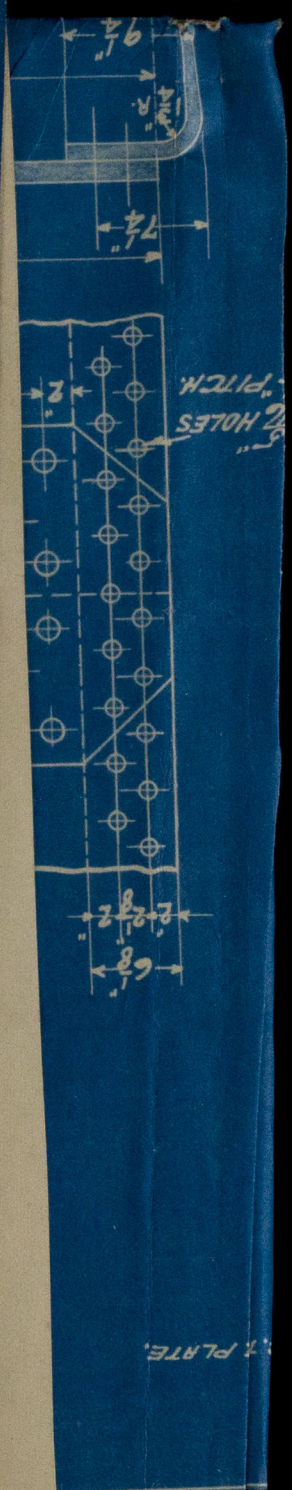

© 2019

Lloyd's Register
Foundation

PHILADELPHIA

New York S 13 &

Contracts #123-124

4 Main Boilers

W. P. 200 #

N32
LLOYD'S Test
300 #
4-29-12 R. H.

ss. Payo



No 41
LLOYD'S Test
300 #
12-14-12 R. H.

ss. Vesta

PHILADELPHIA

SS VESTA

Report No. 2009

W206-0237

Lloyd's Register
Foundation