

S. S. OTAKI.

REPAIRS TO AFT SINGLE ENDED BOILER.


SCALE: 1"=1FOOT.

WORK RENEWED


CAULKING

WELDING

PAD FITTED FOR AUX. STOP VALVE REFRIG. ENGINE

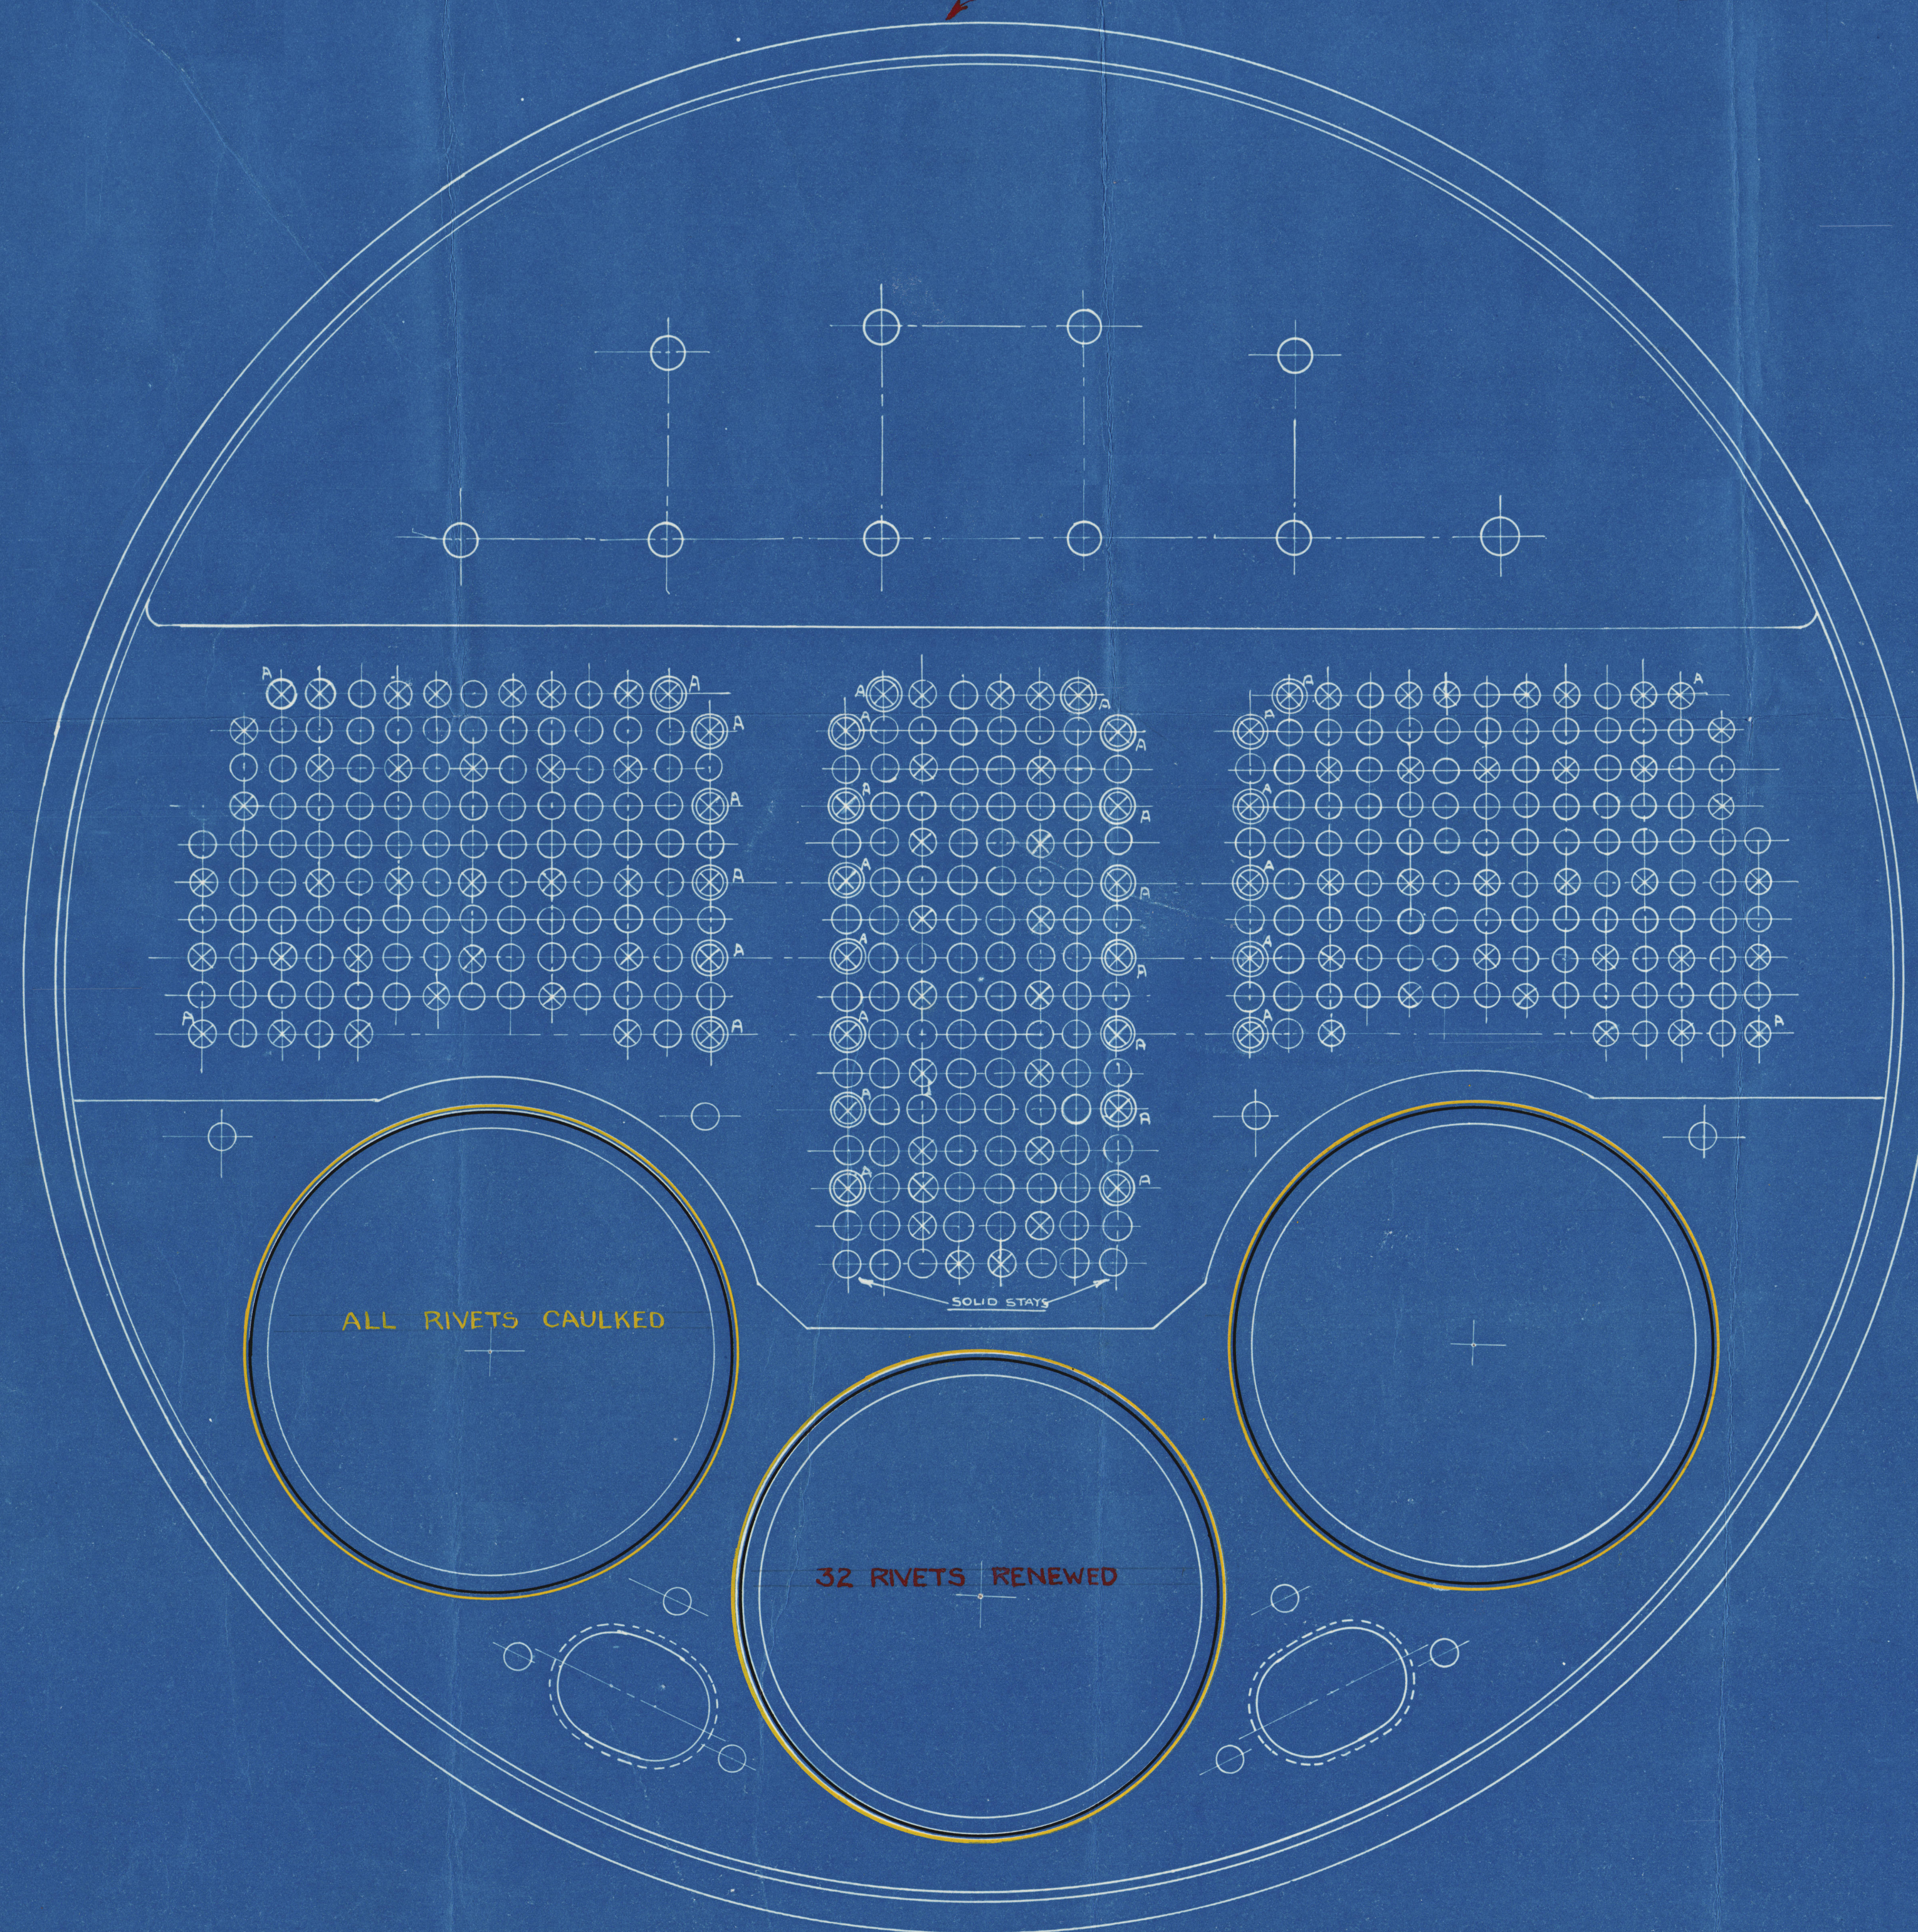


FRONT END

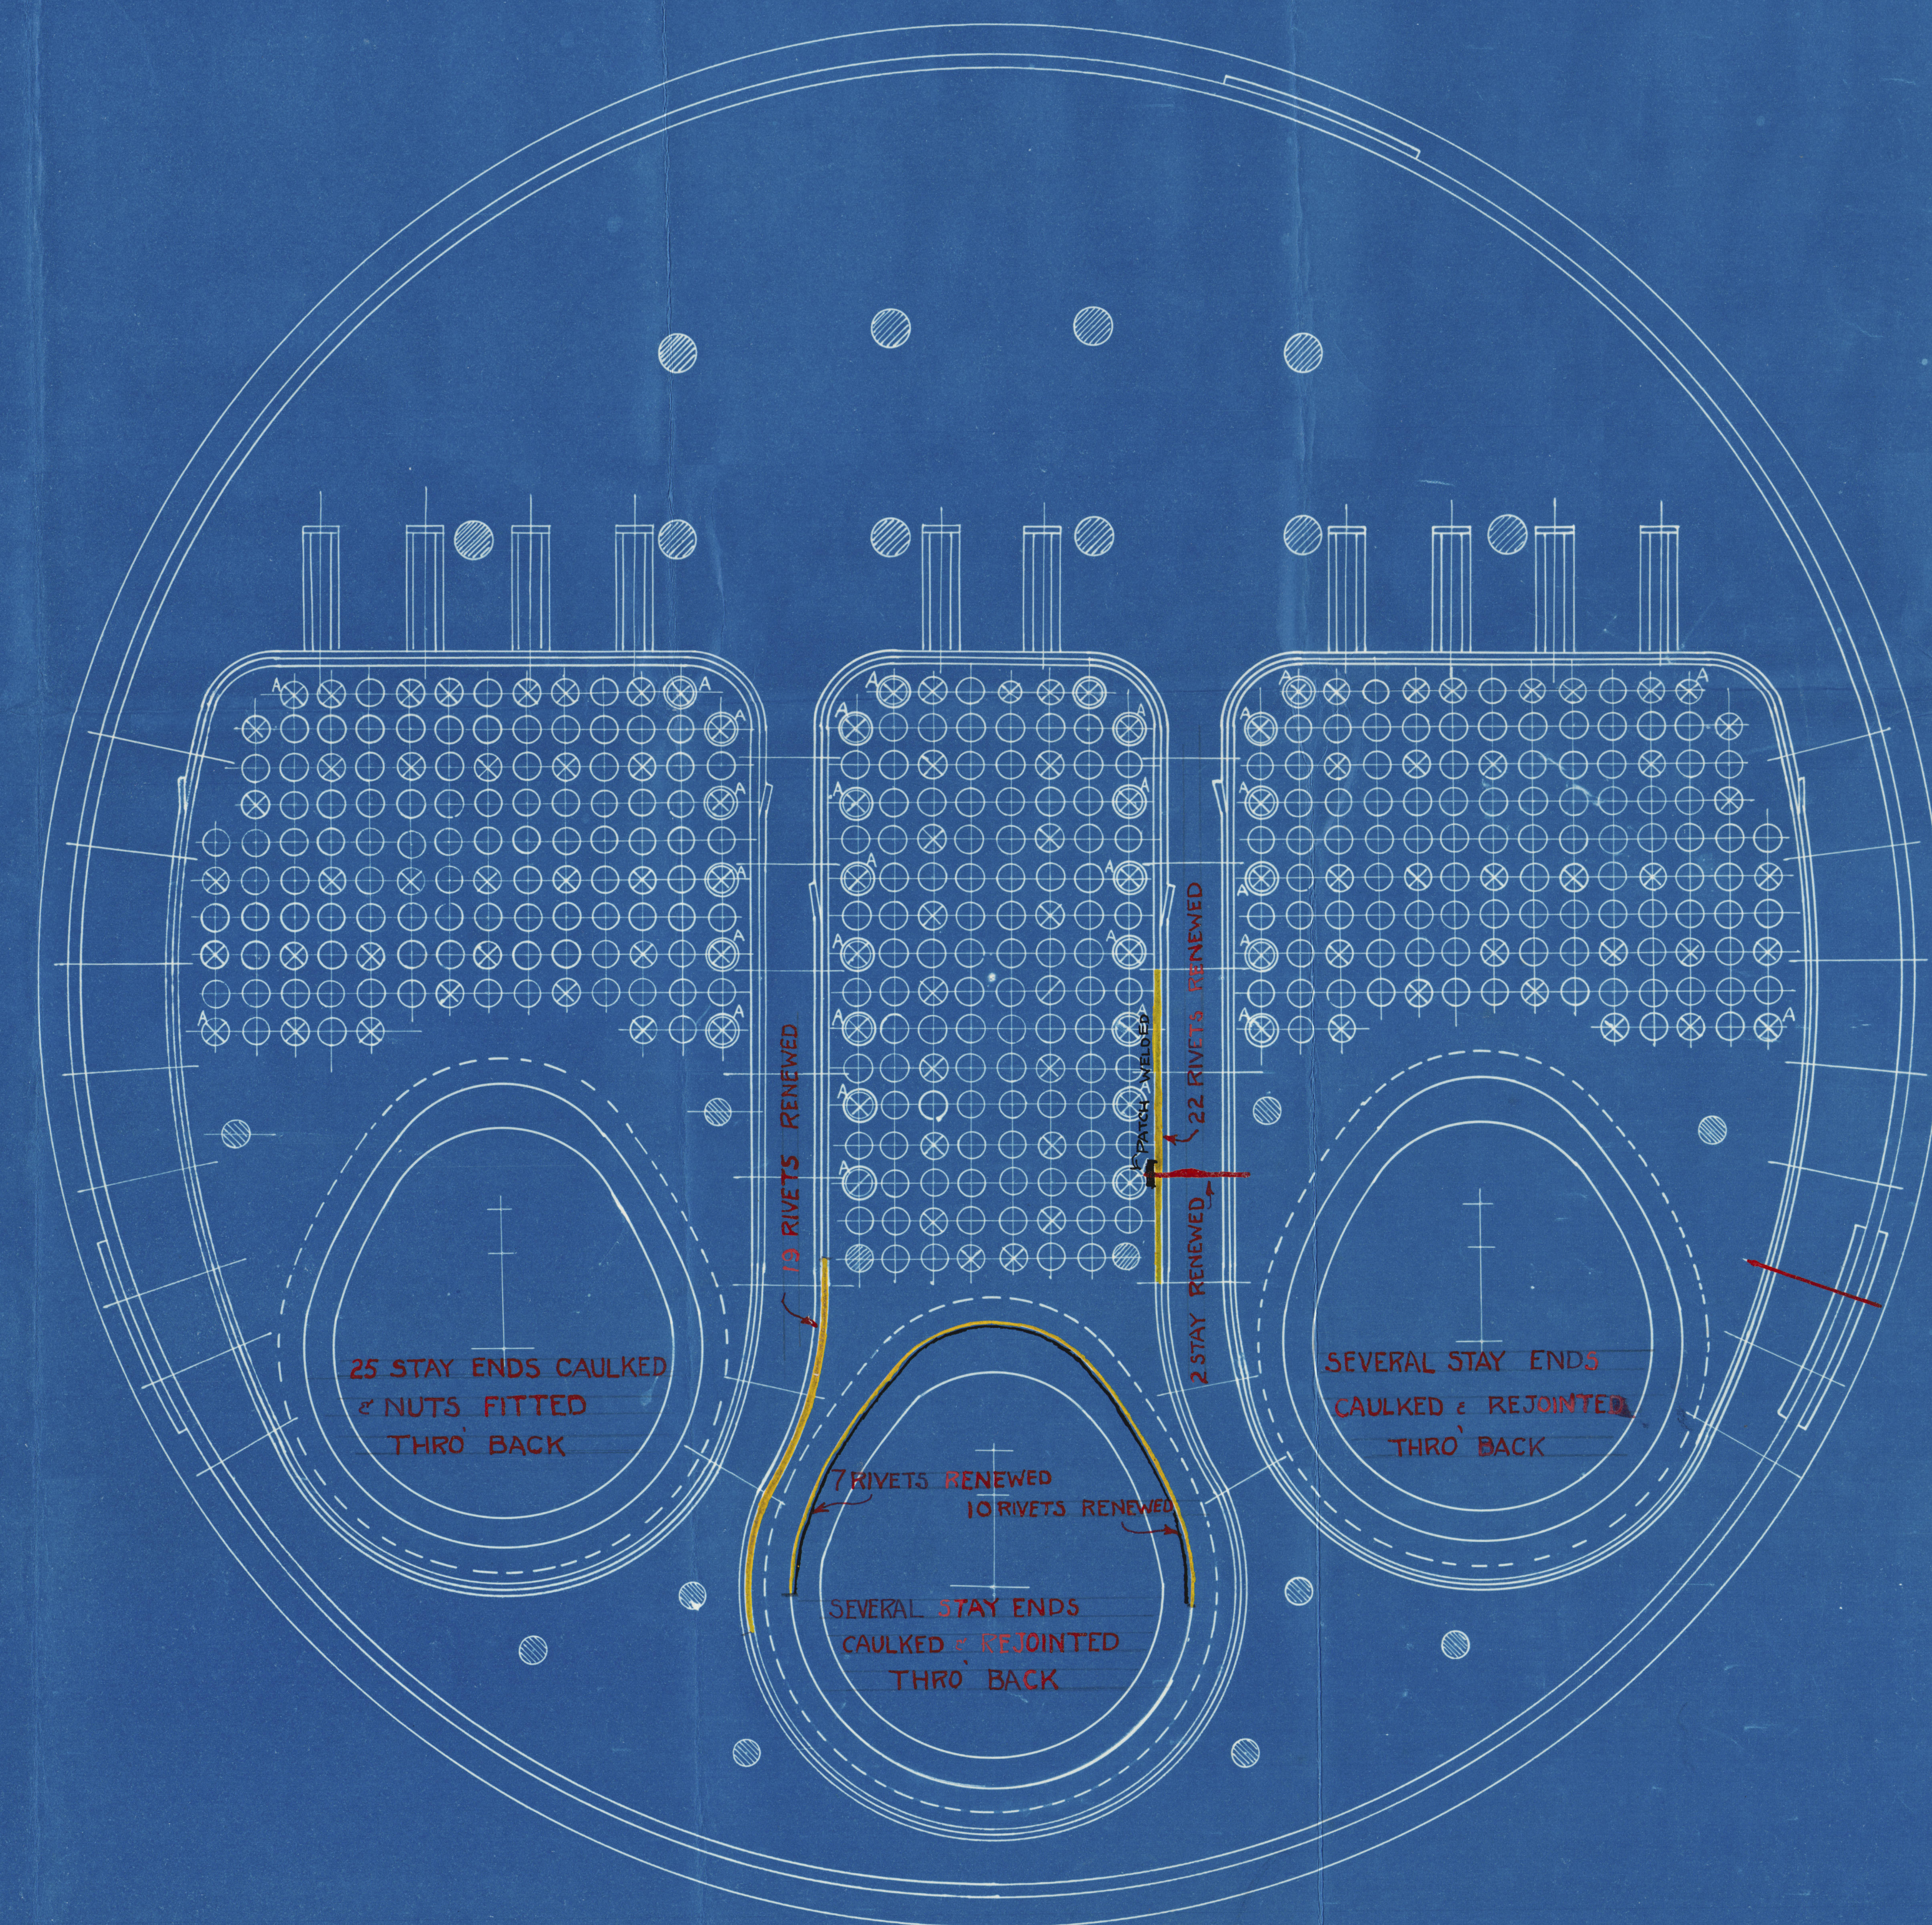

SECTION THRO COMBUSTION CHAMBER LOOKING TO FRONT END.

MARK	DESCRIPTION
○	PLAIN TUBES 2 1/2" EXT. DIA. 9 W.G. THICK
⊗	STAY TUBES 2 1/2" EXT. DIA. 9 W.G. THICK
⊗ ^A	STAY TUBES 2 1/2" EXT. DIA. 9 W.G. THICK
⊗ ^A	STAY TUBES FITTED WITH NUTS

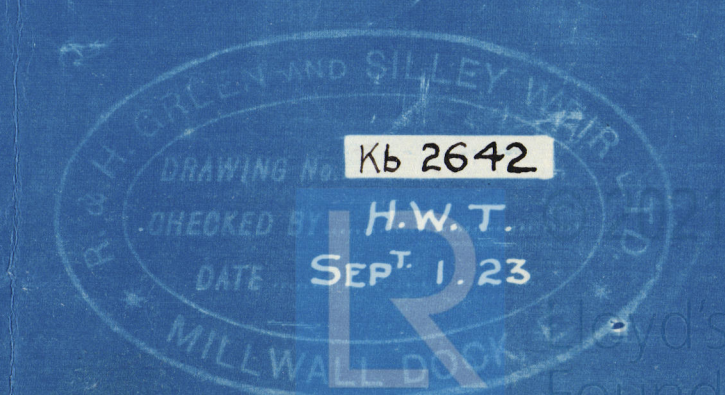

87896

8500-802M

St. Olaf
London Npt-87926

8500-802M

