



SS OTAKI.


REPAIRS TO **FOR^d** END OF **PORT** DOUBLE ENDED BOILER.

SCALE - 1=1 FOOT


 = WORK RENEWED

 = CHULKING

 = WELDING

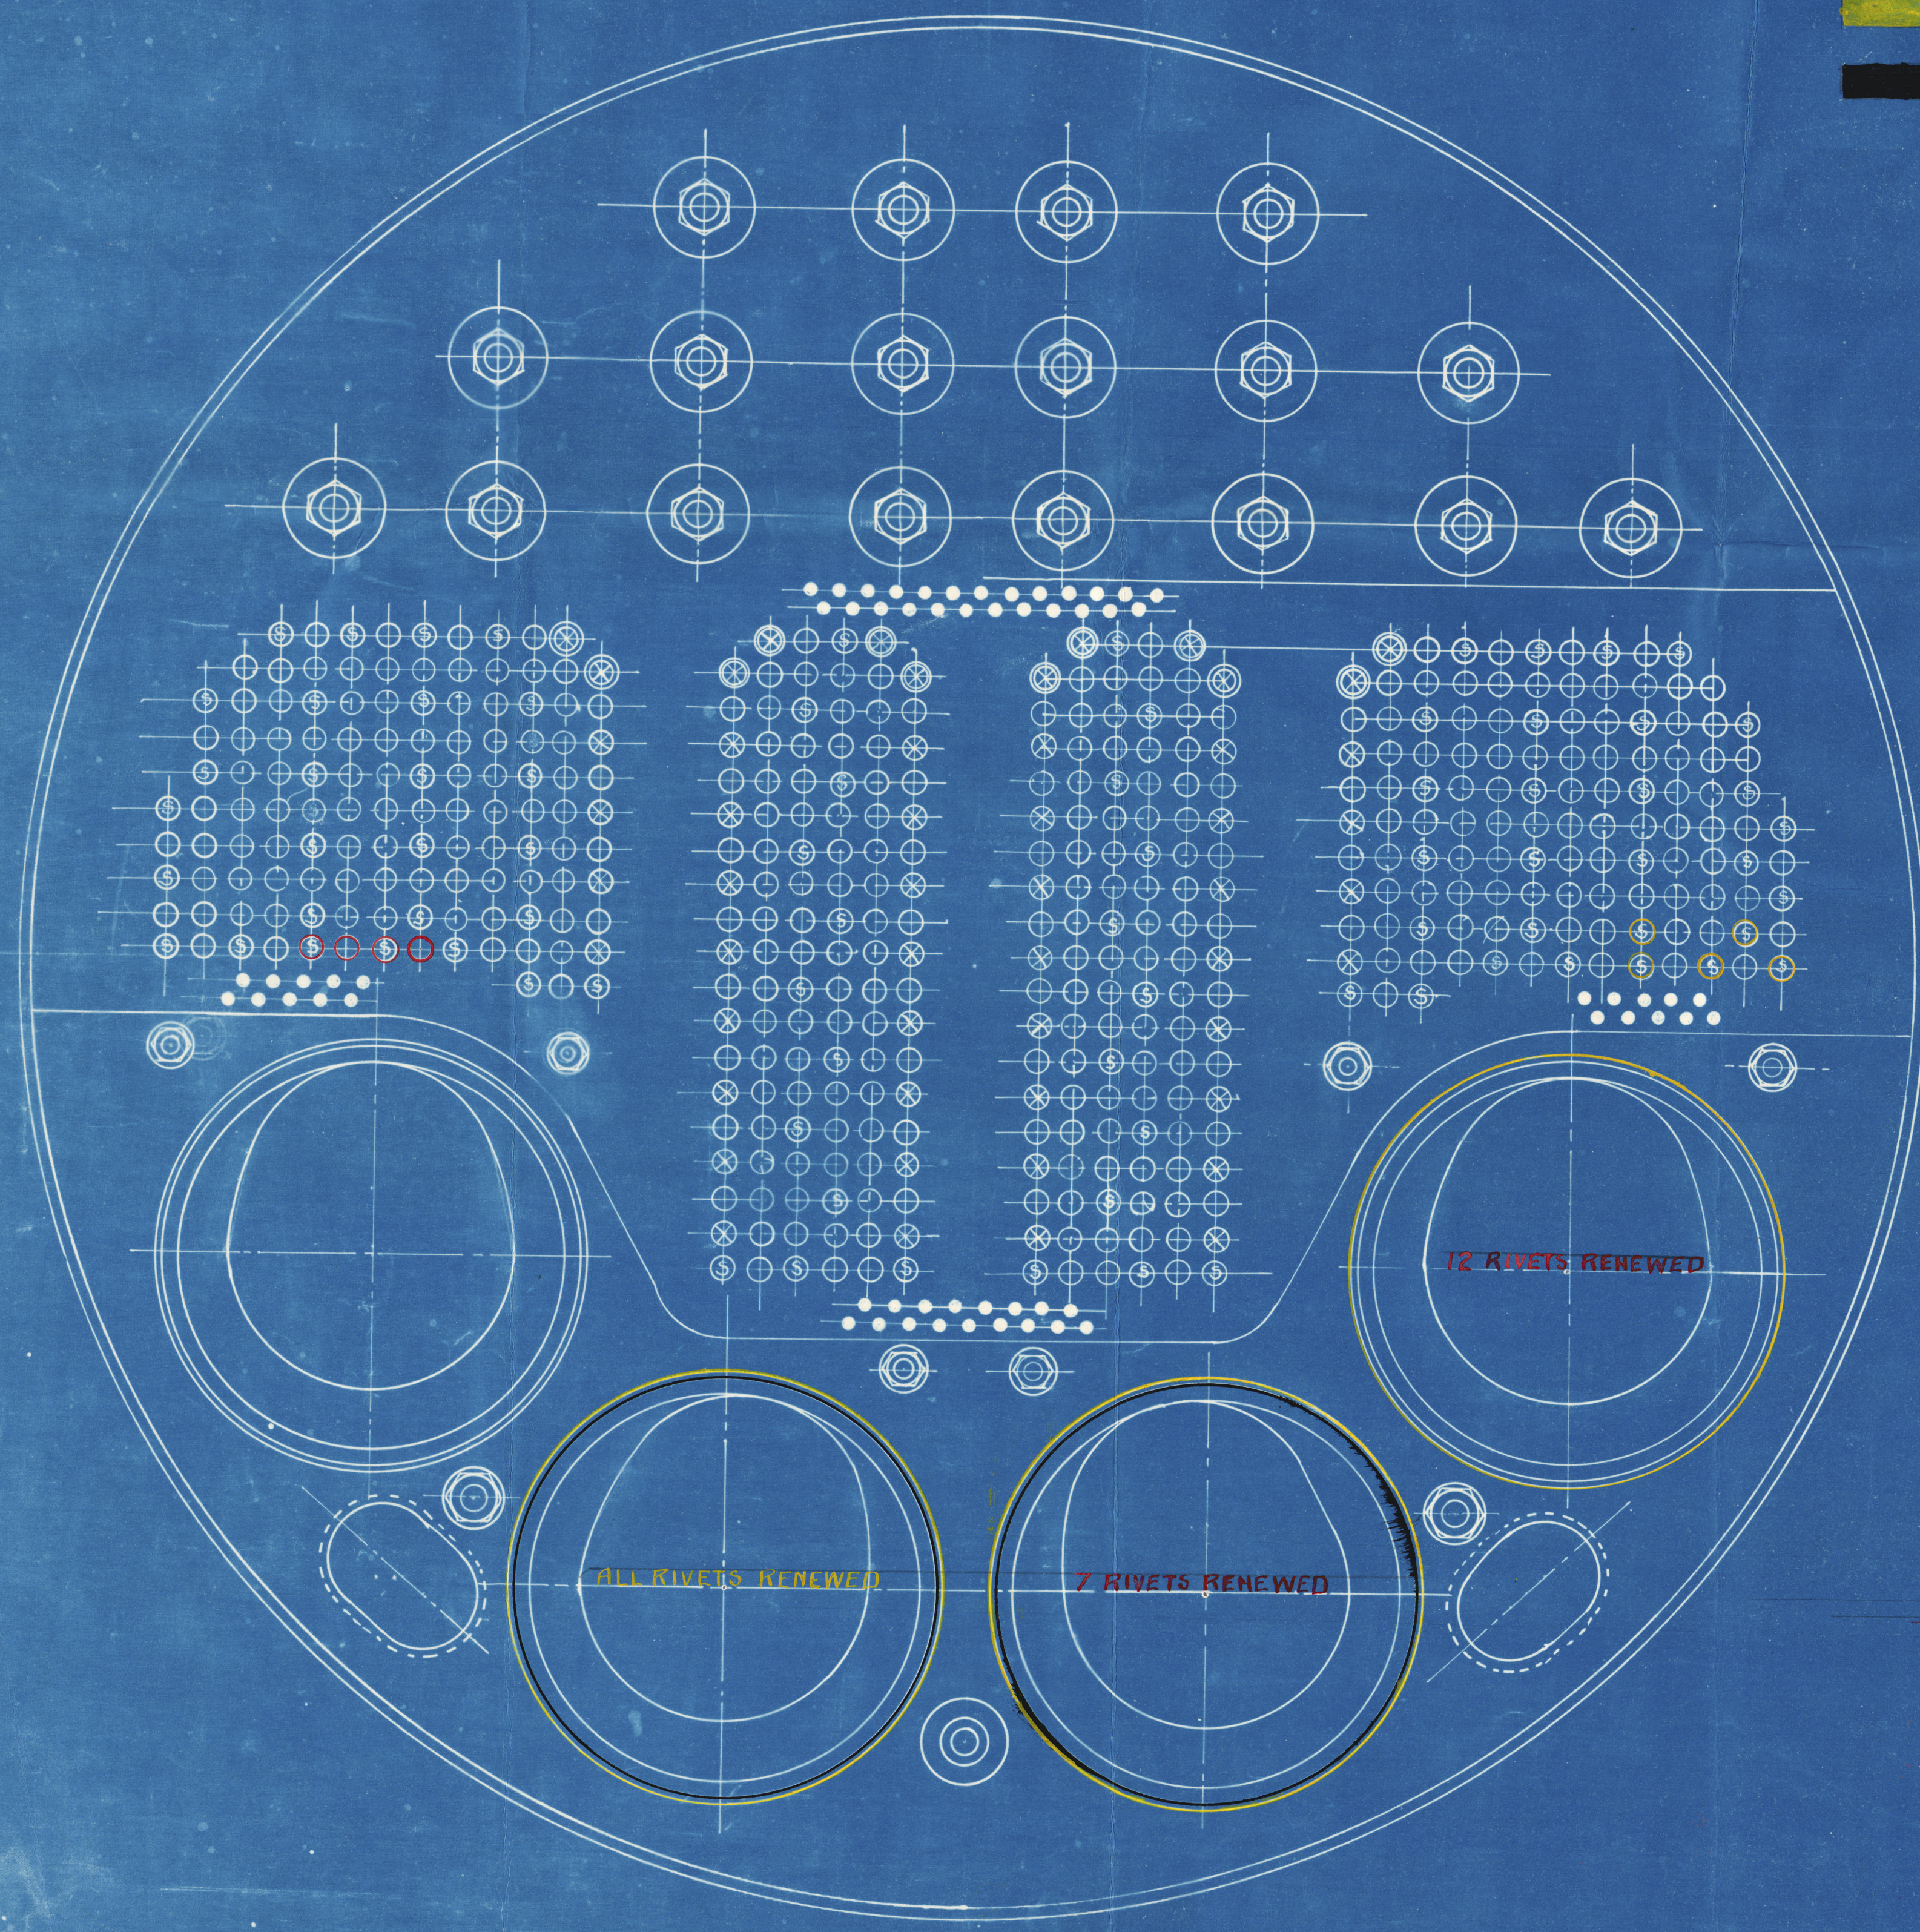

FRONT END **FOR^d** OF BOILER

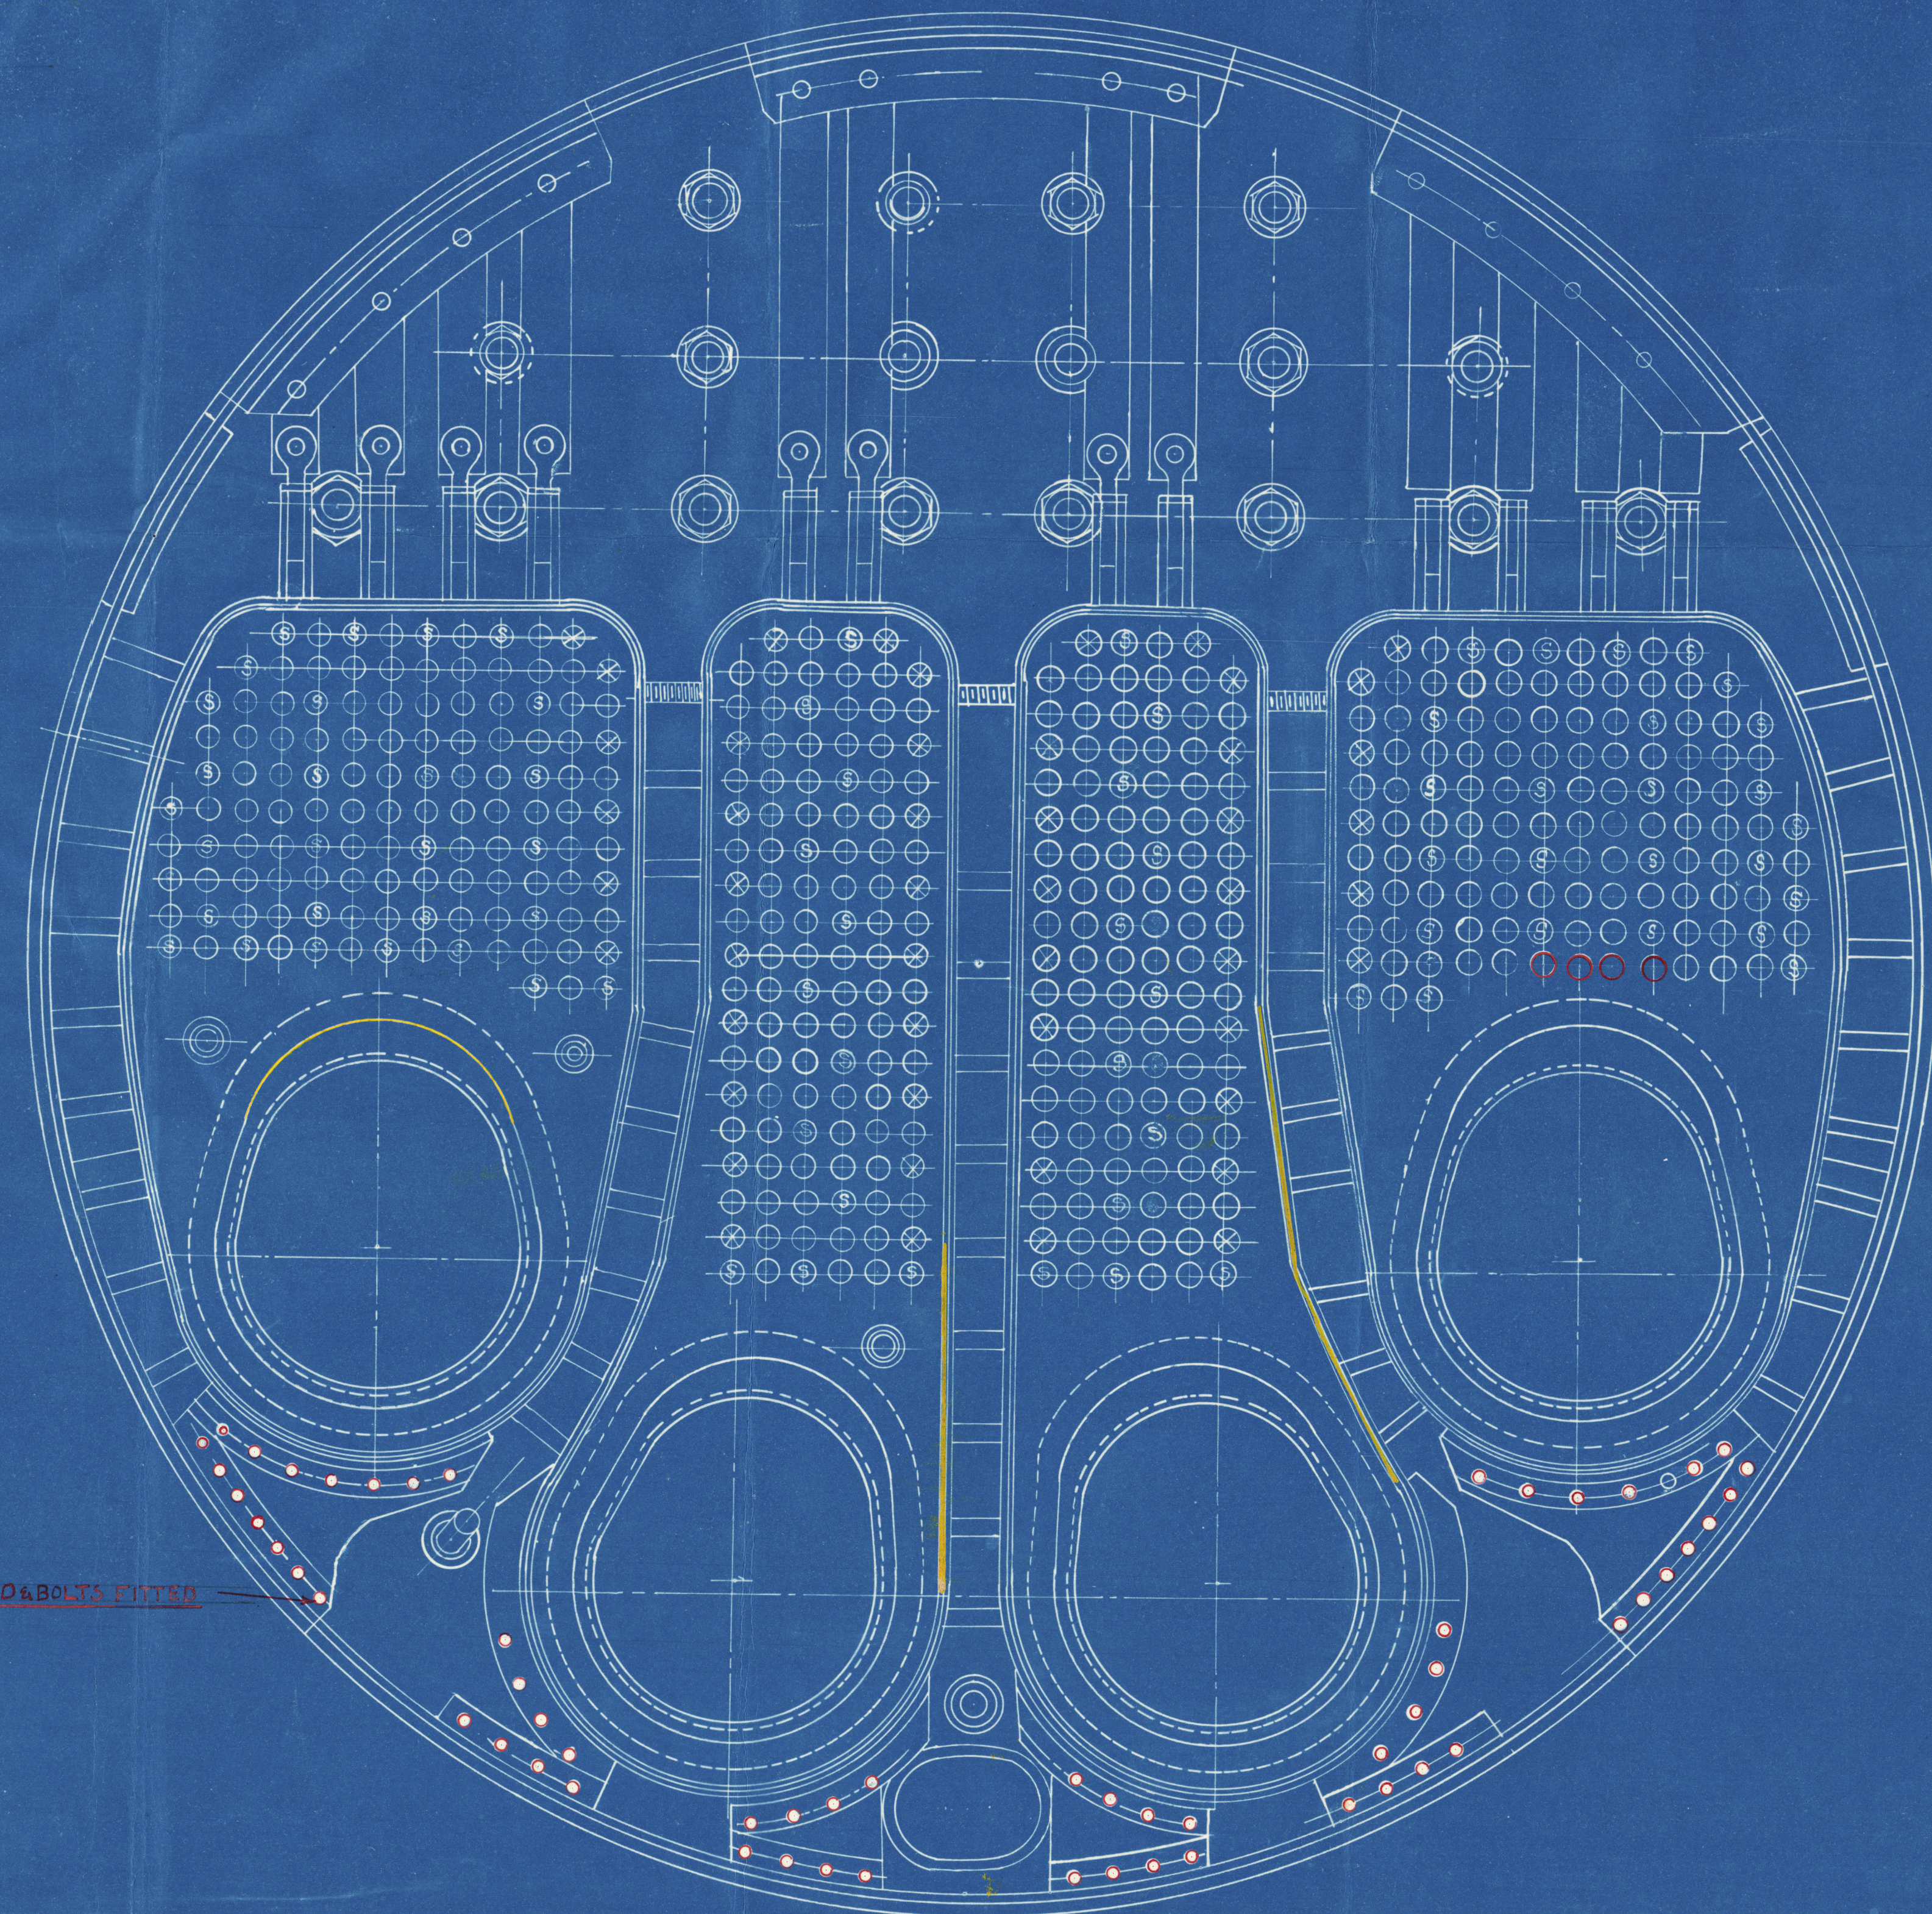

SECTION THROUGH COMBUSTION CHAMBER LOOKING **FOR^d**

MARK	
○	PLAIN TUBES
⊗	STAY " NO NUTS
⊗	" " "
⊗	" " WITH

$\frac{5}{5}$ Staki
London RMC 87326.

W208-0059



Lloyd's Register
Foundation