




PORT

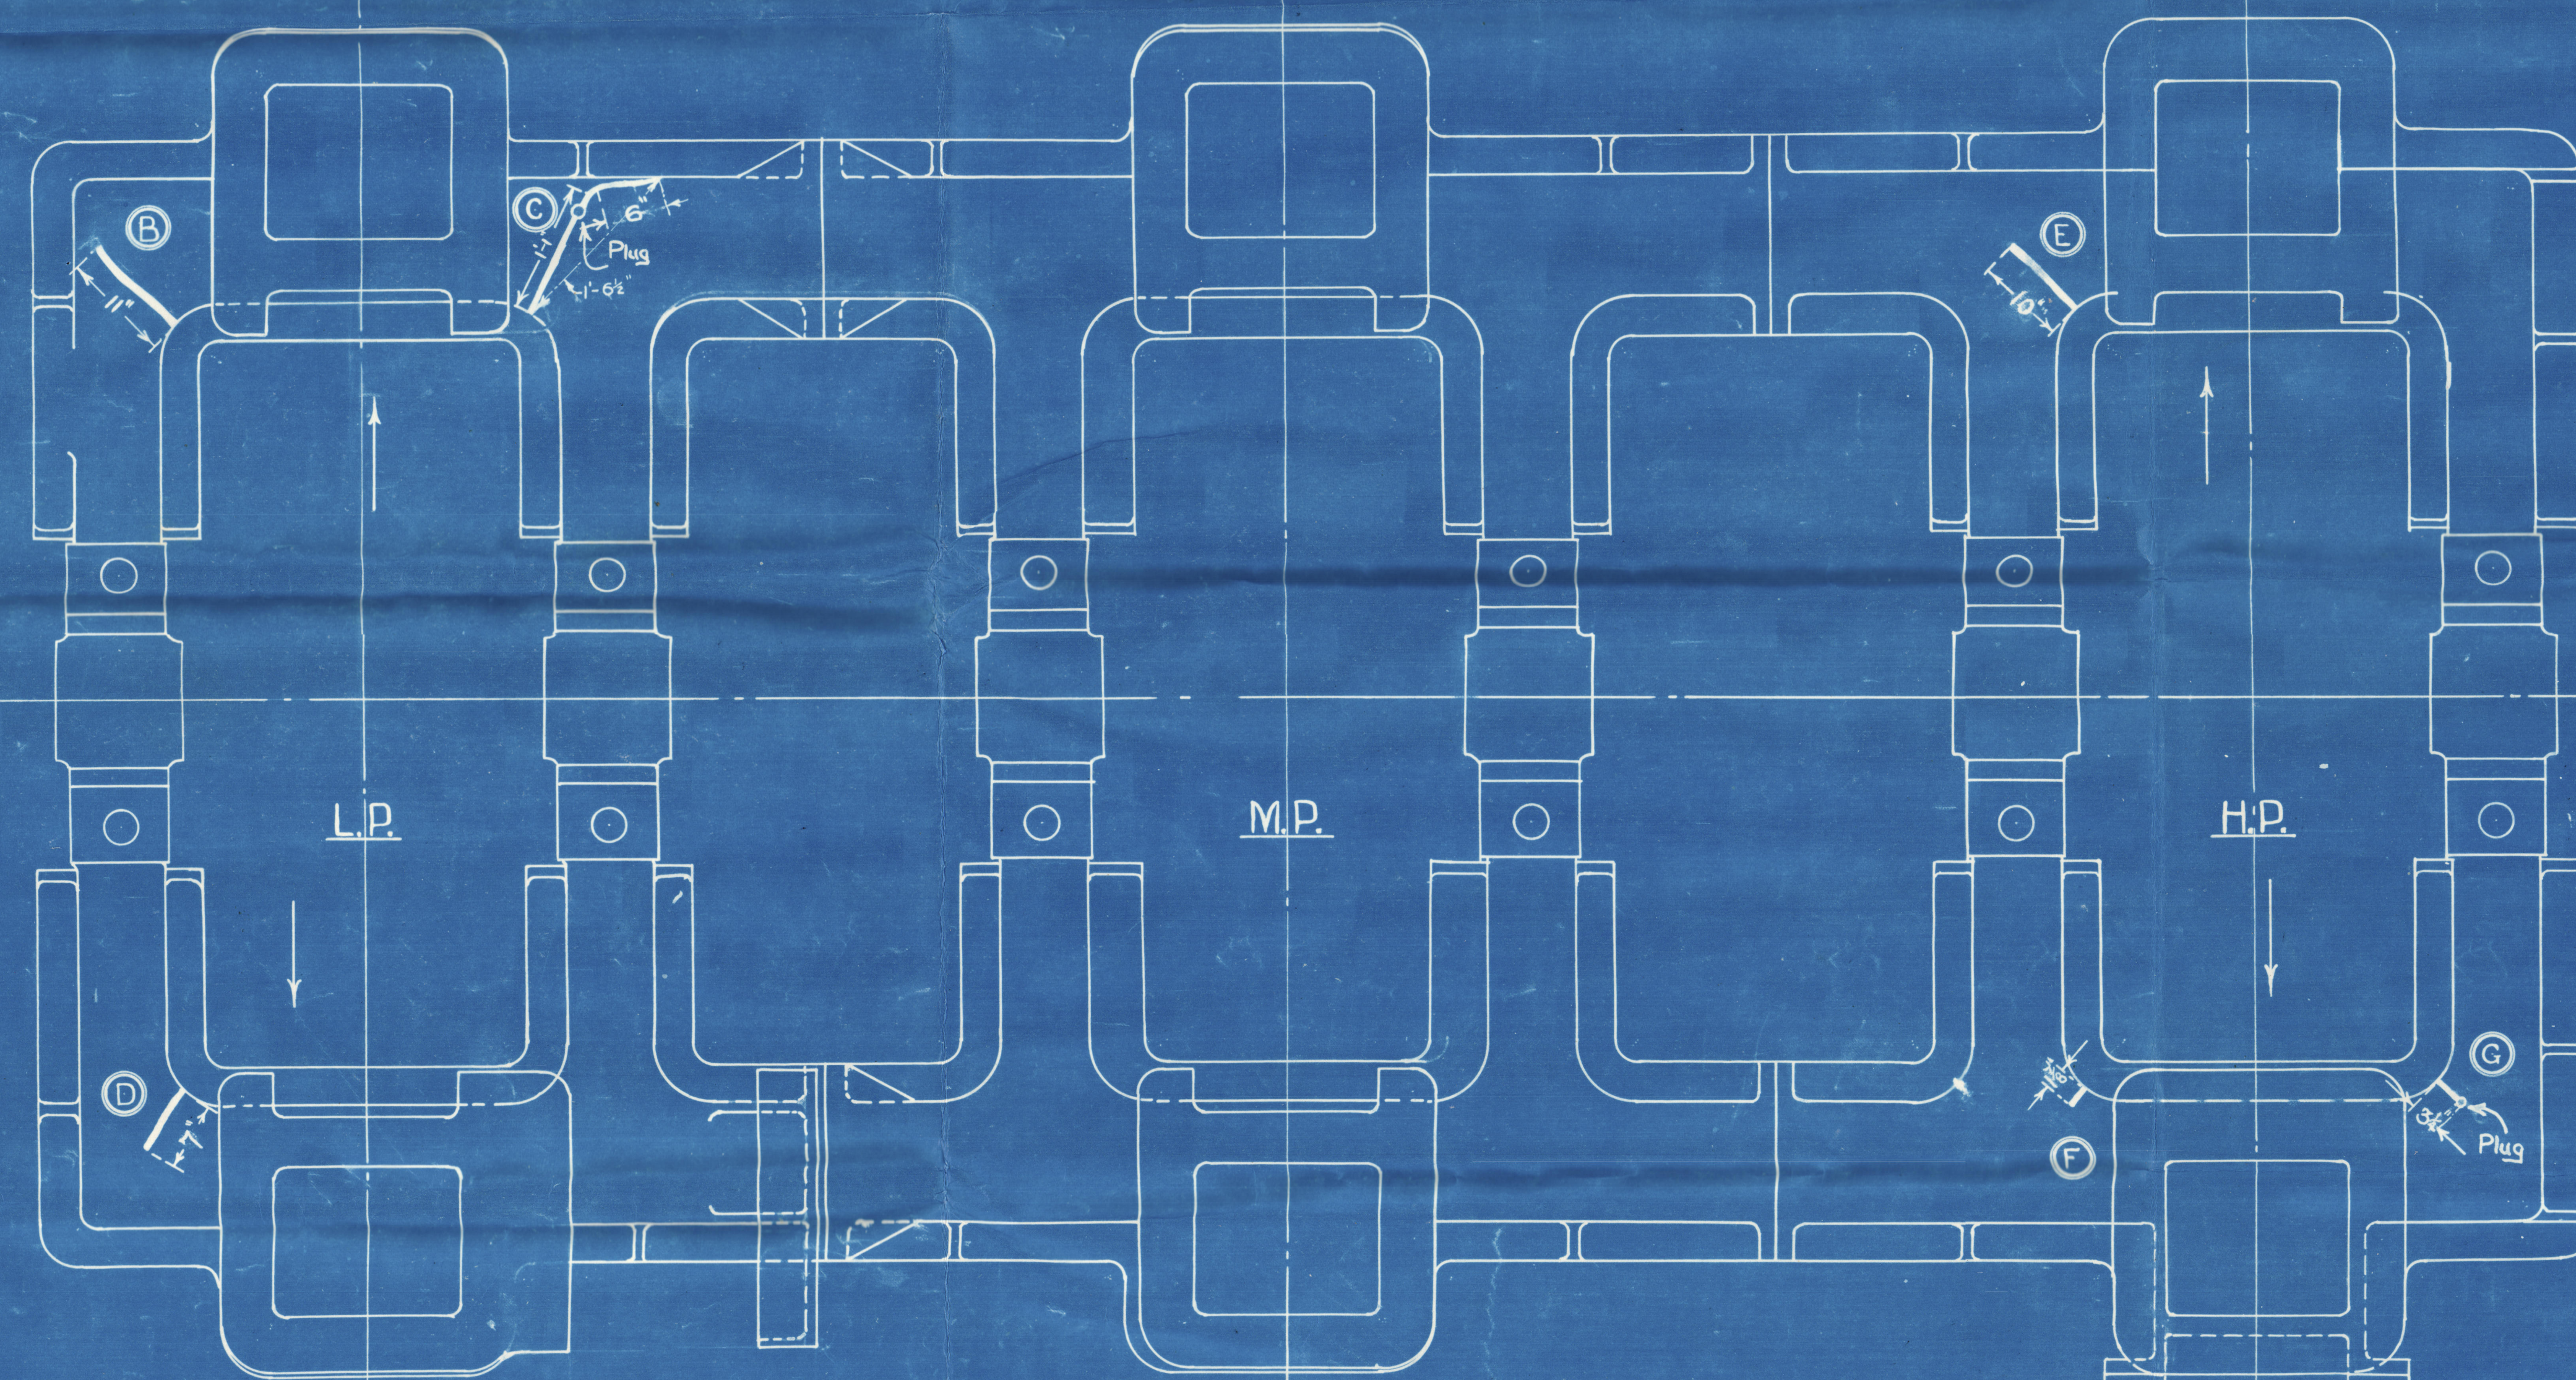


STARRD

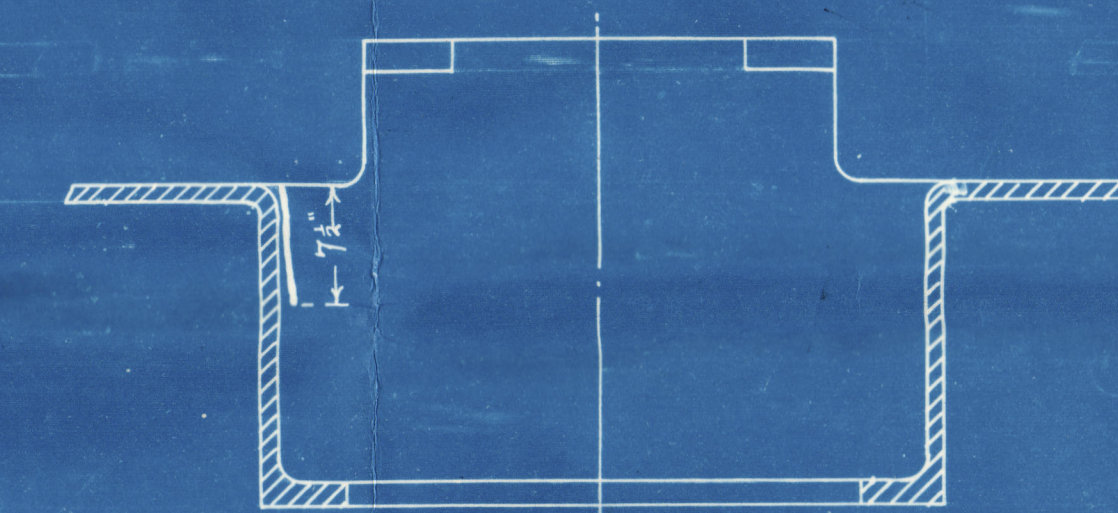


(A) LOOKING IN DIRECTION OF ARROW.

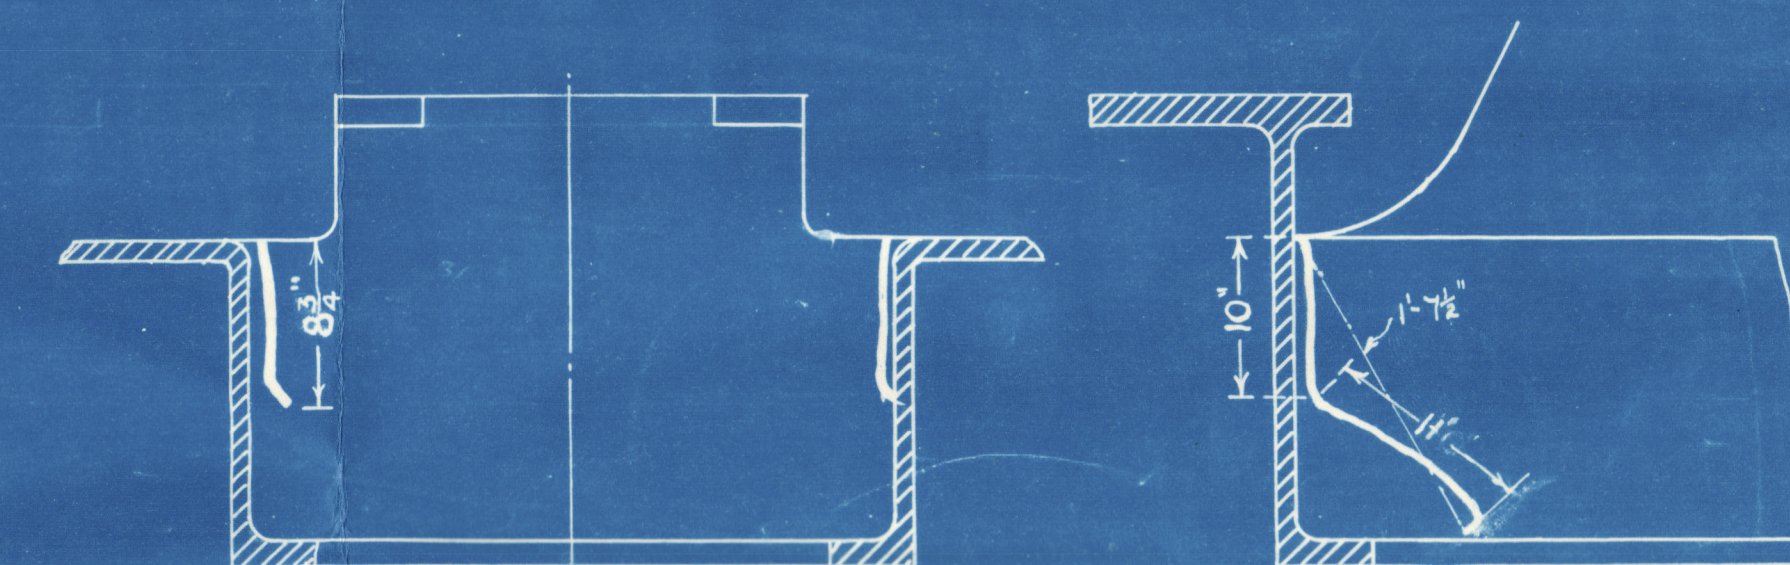


(B) & (C) LOOKING IN DIRECTION OF ARROW.

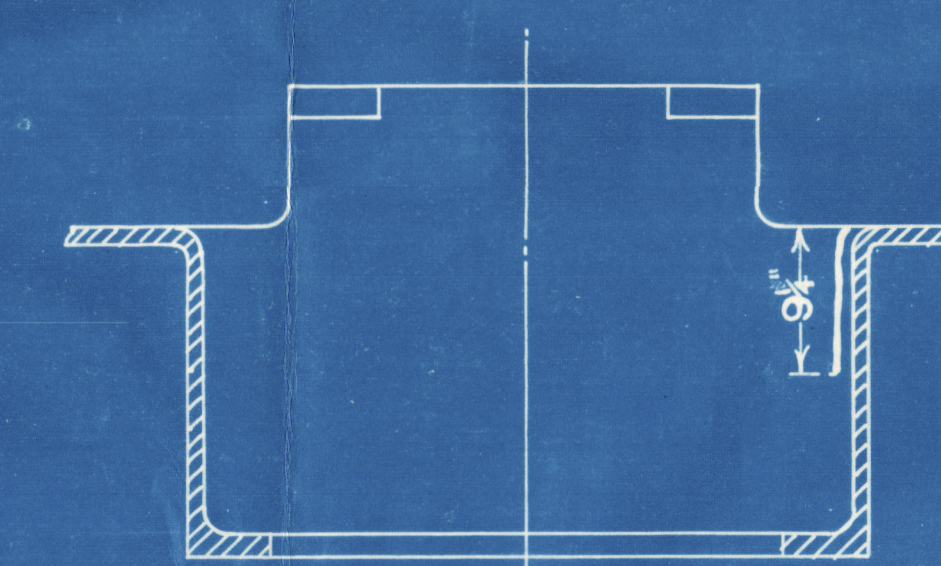

(D) LOOKING IN DIRECTION OF ARROW.

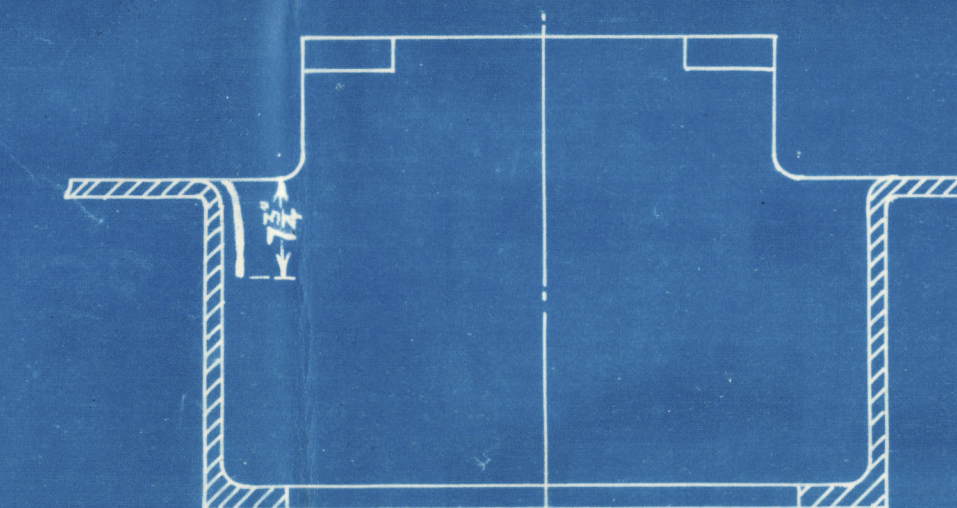

(E) LOOKING IN DIRECTION OF ARROW.

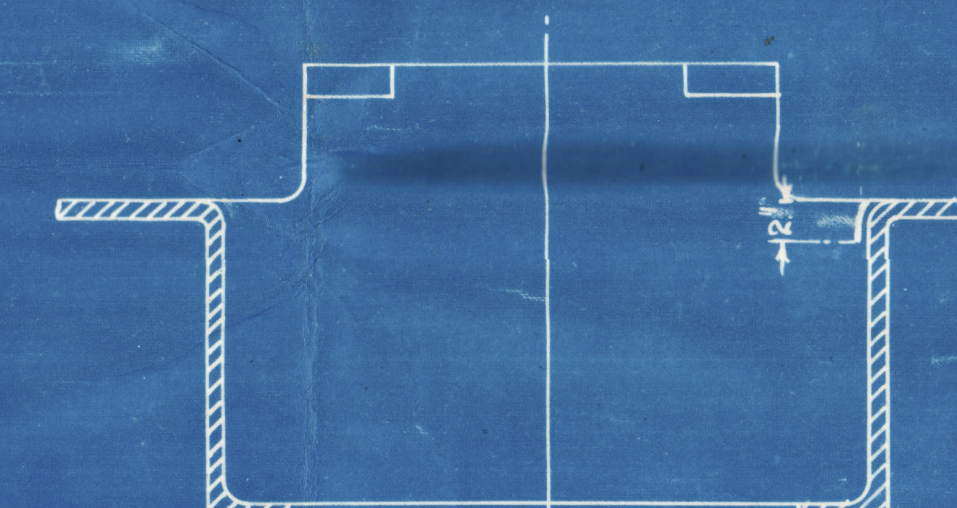

(F) LOOKING IN DIRECTION OF ARROW.

NOTE:- THE END OF EACH CRACK WAS MARKED BY A HEAVY CENTRE-POP
& THE DIMENSIONS CHECKED BY THE 2ND ENGINEER ON THE 11-12-23.

S/S "OTAKI"

CRACKS IN SOLE PLATES, MAIN ENGINES.

Scale 1" to 1'-0"



S^y "TWIN'S OTAKI"

PLAN OF SOLE PLATES
SHEWING
CRACKS IN CASTINGS.



© 2021

Lloyd's Register

W208-0060

Foundation