


SS OTAKI.

REPAIRS TO AFT END OF STB DOUBLE ENDED BOILER.


SCALE:- 1=1 FOOT

 - WORK RENEWED


 - CAULKING

 - WELDING

PAD FITTED FOR AUX STOP VALVE REFRIG ENGINE

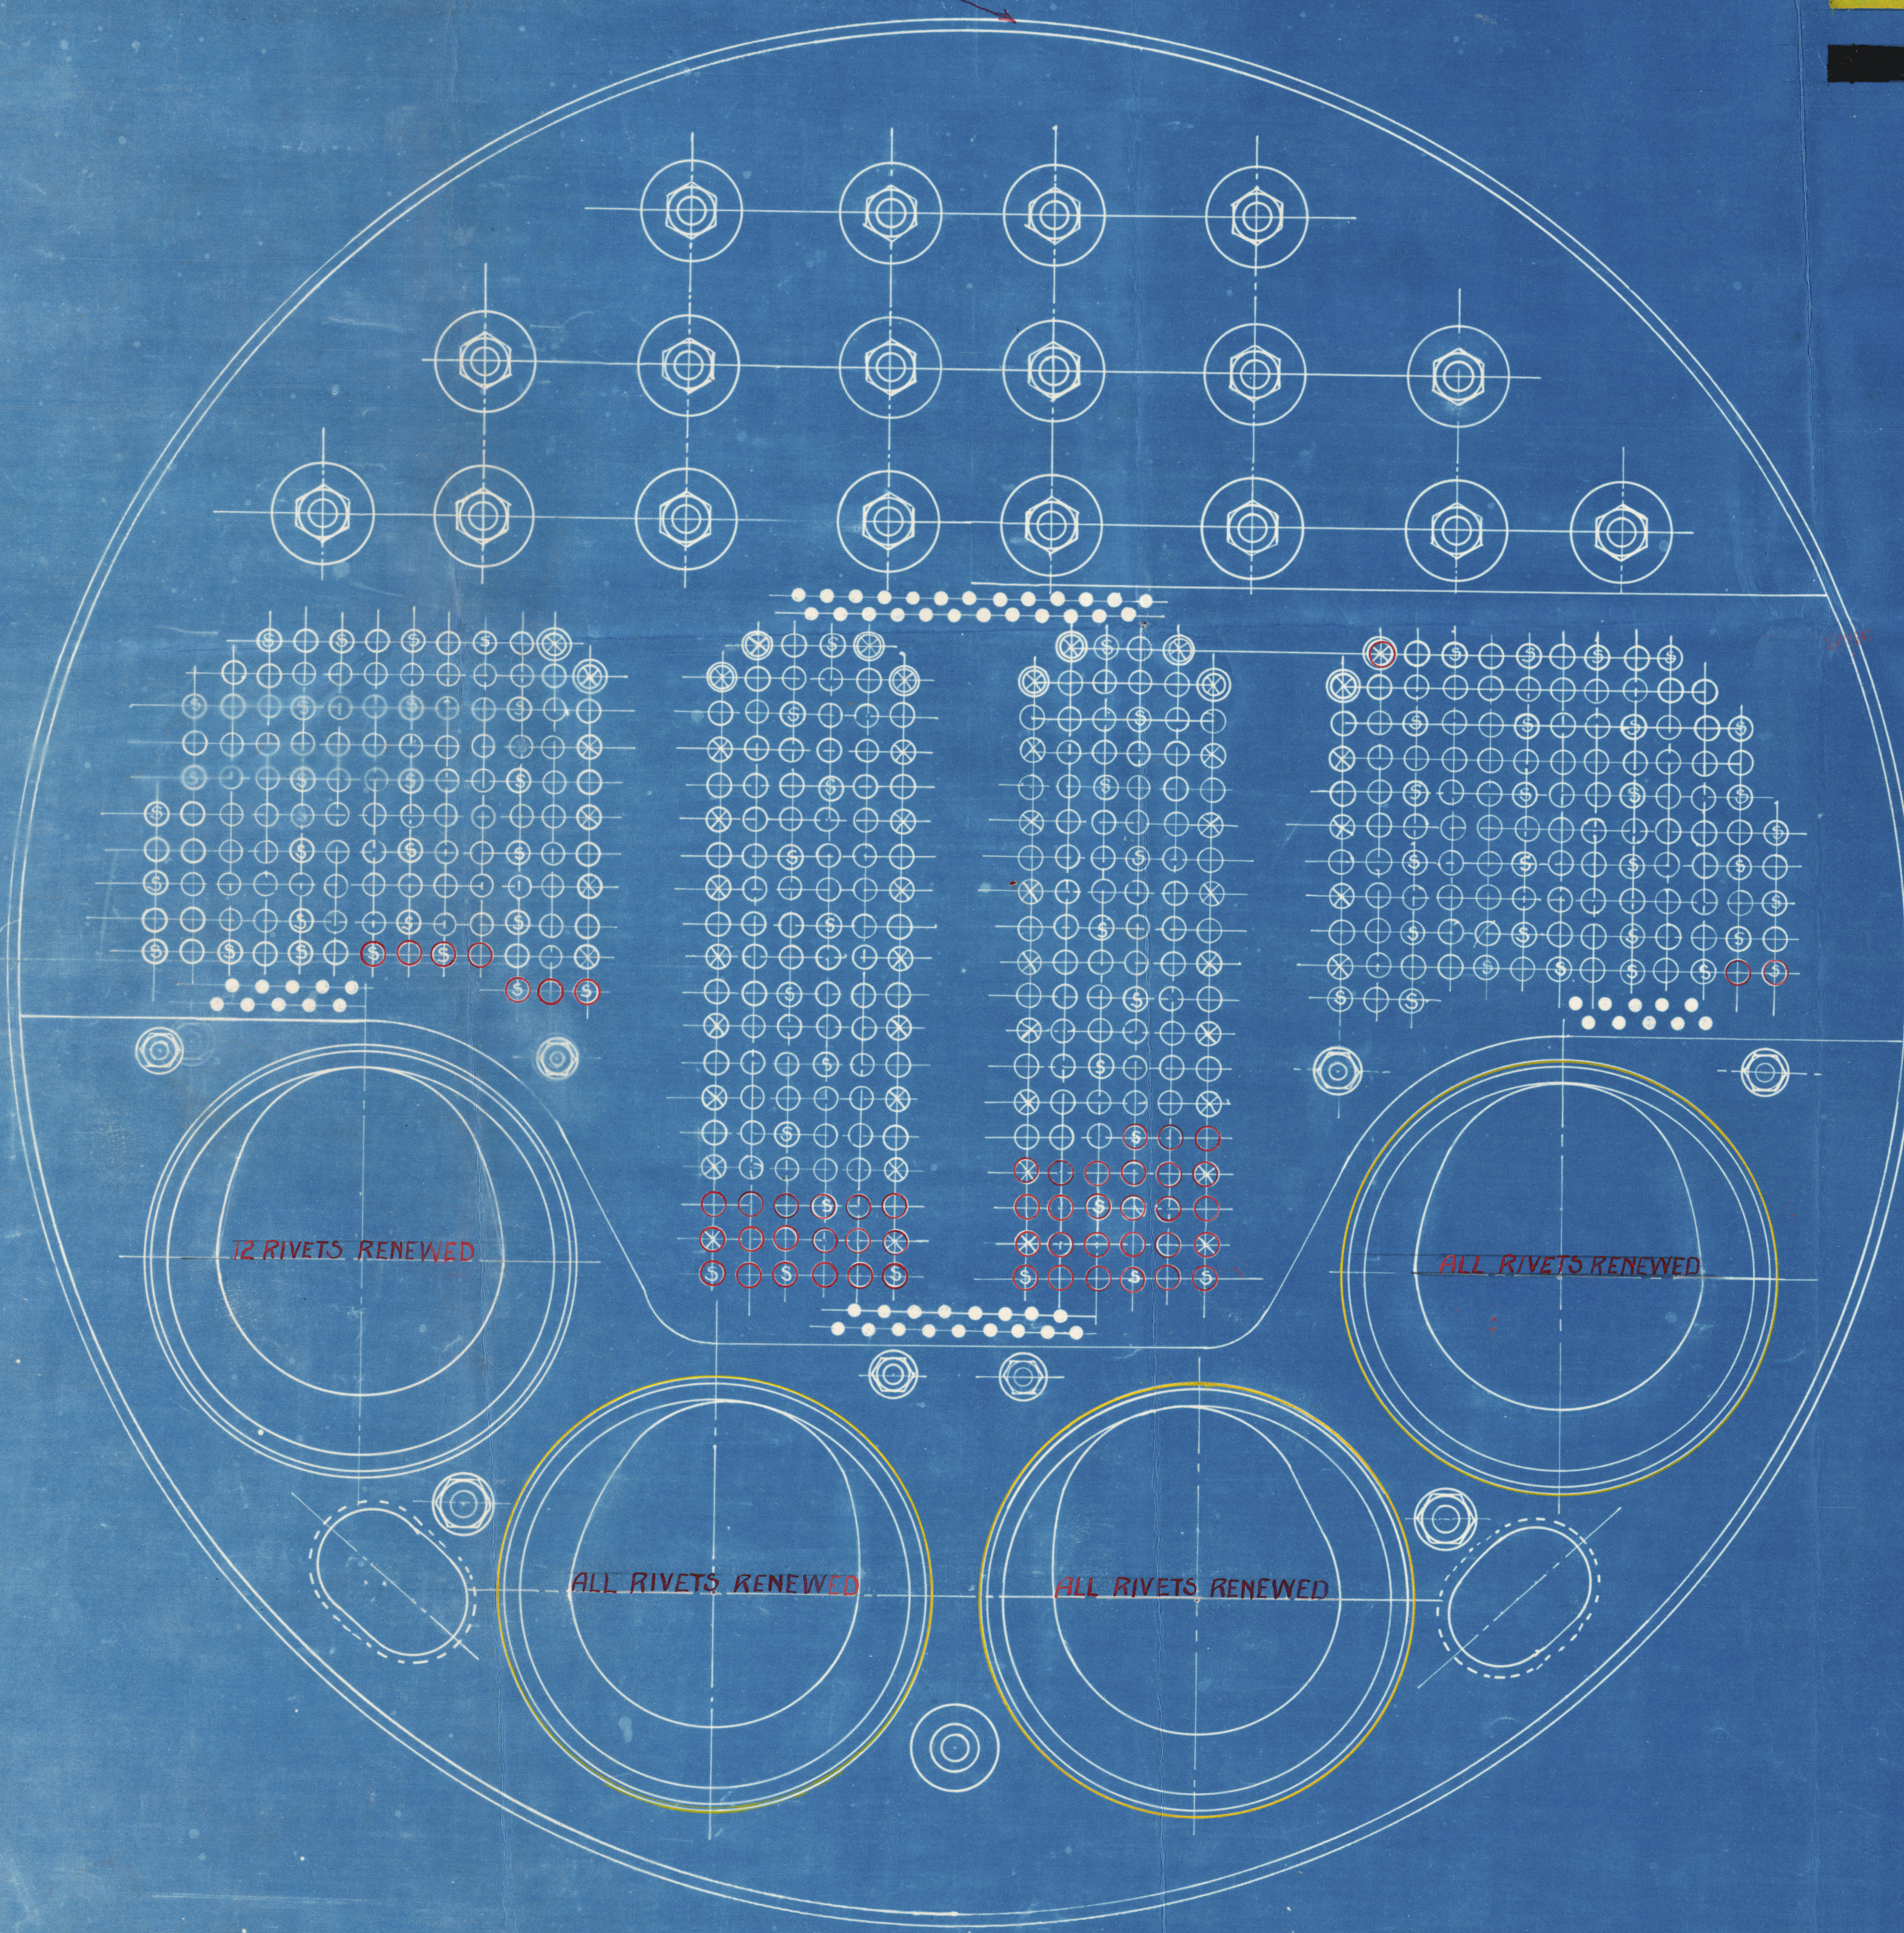

FRONT END FOR OF BOILER

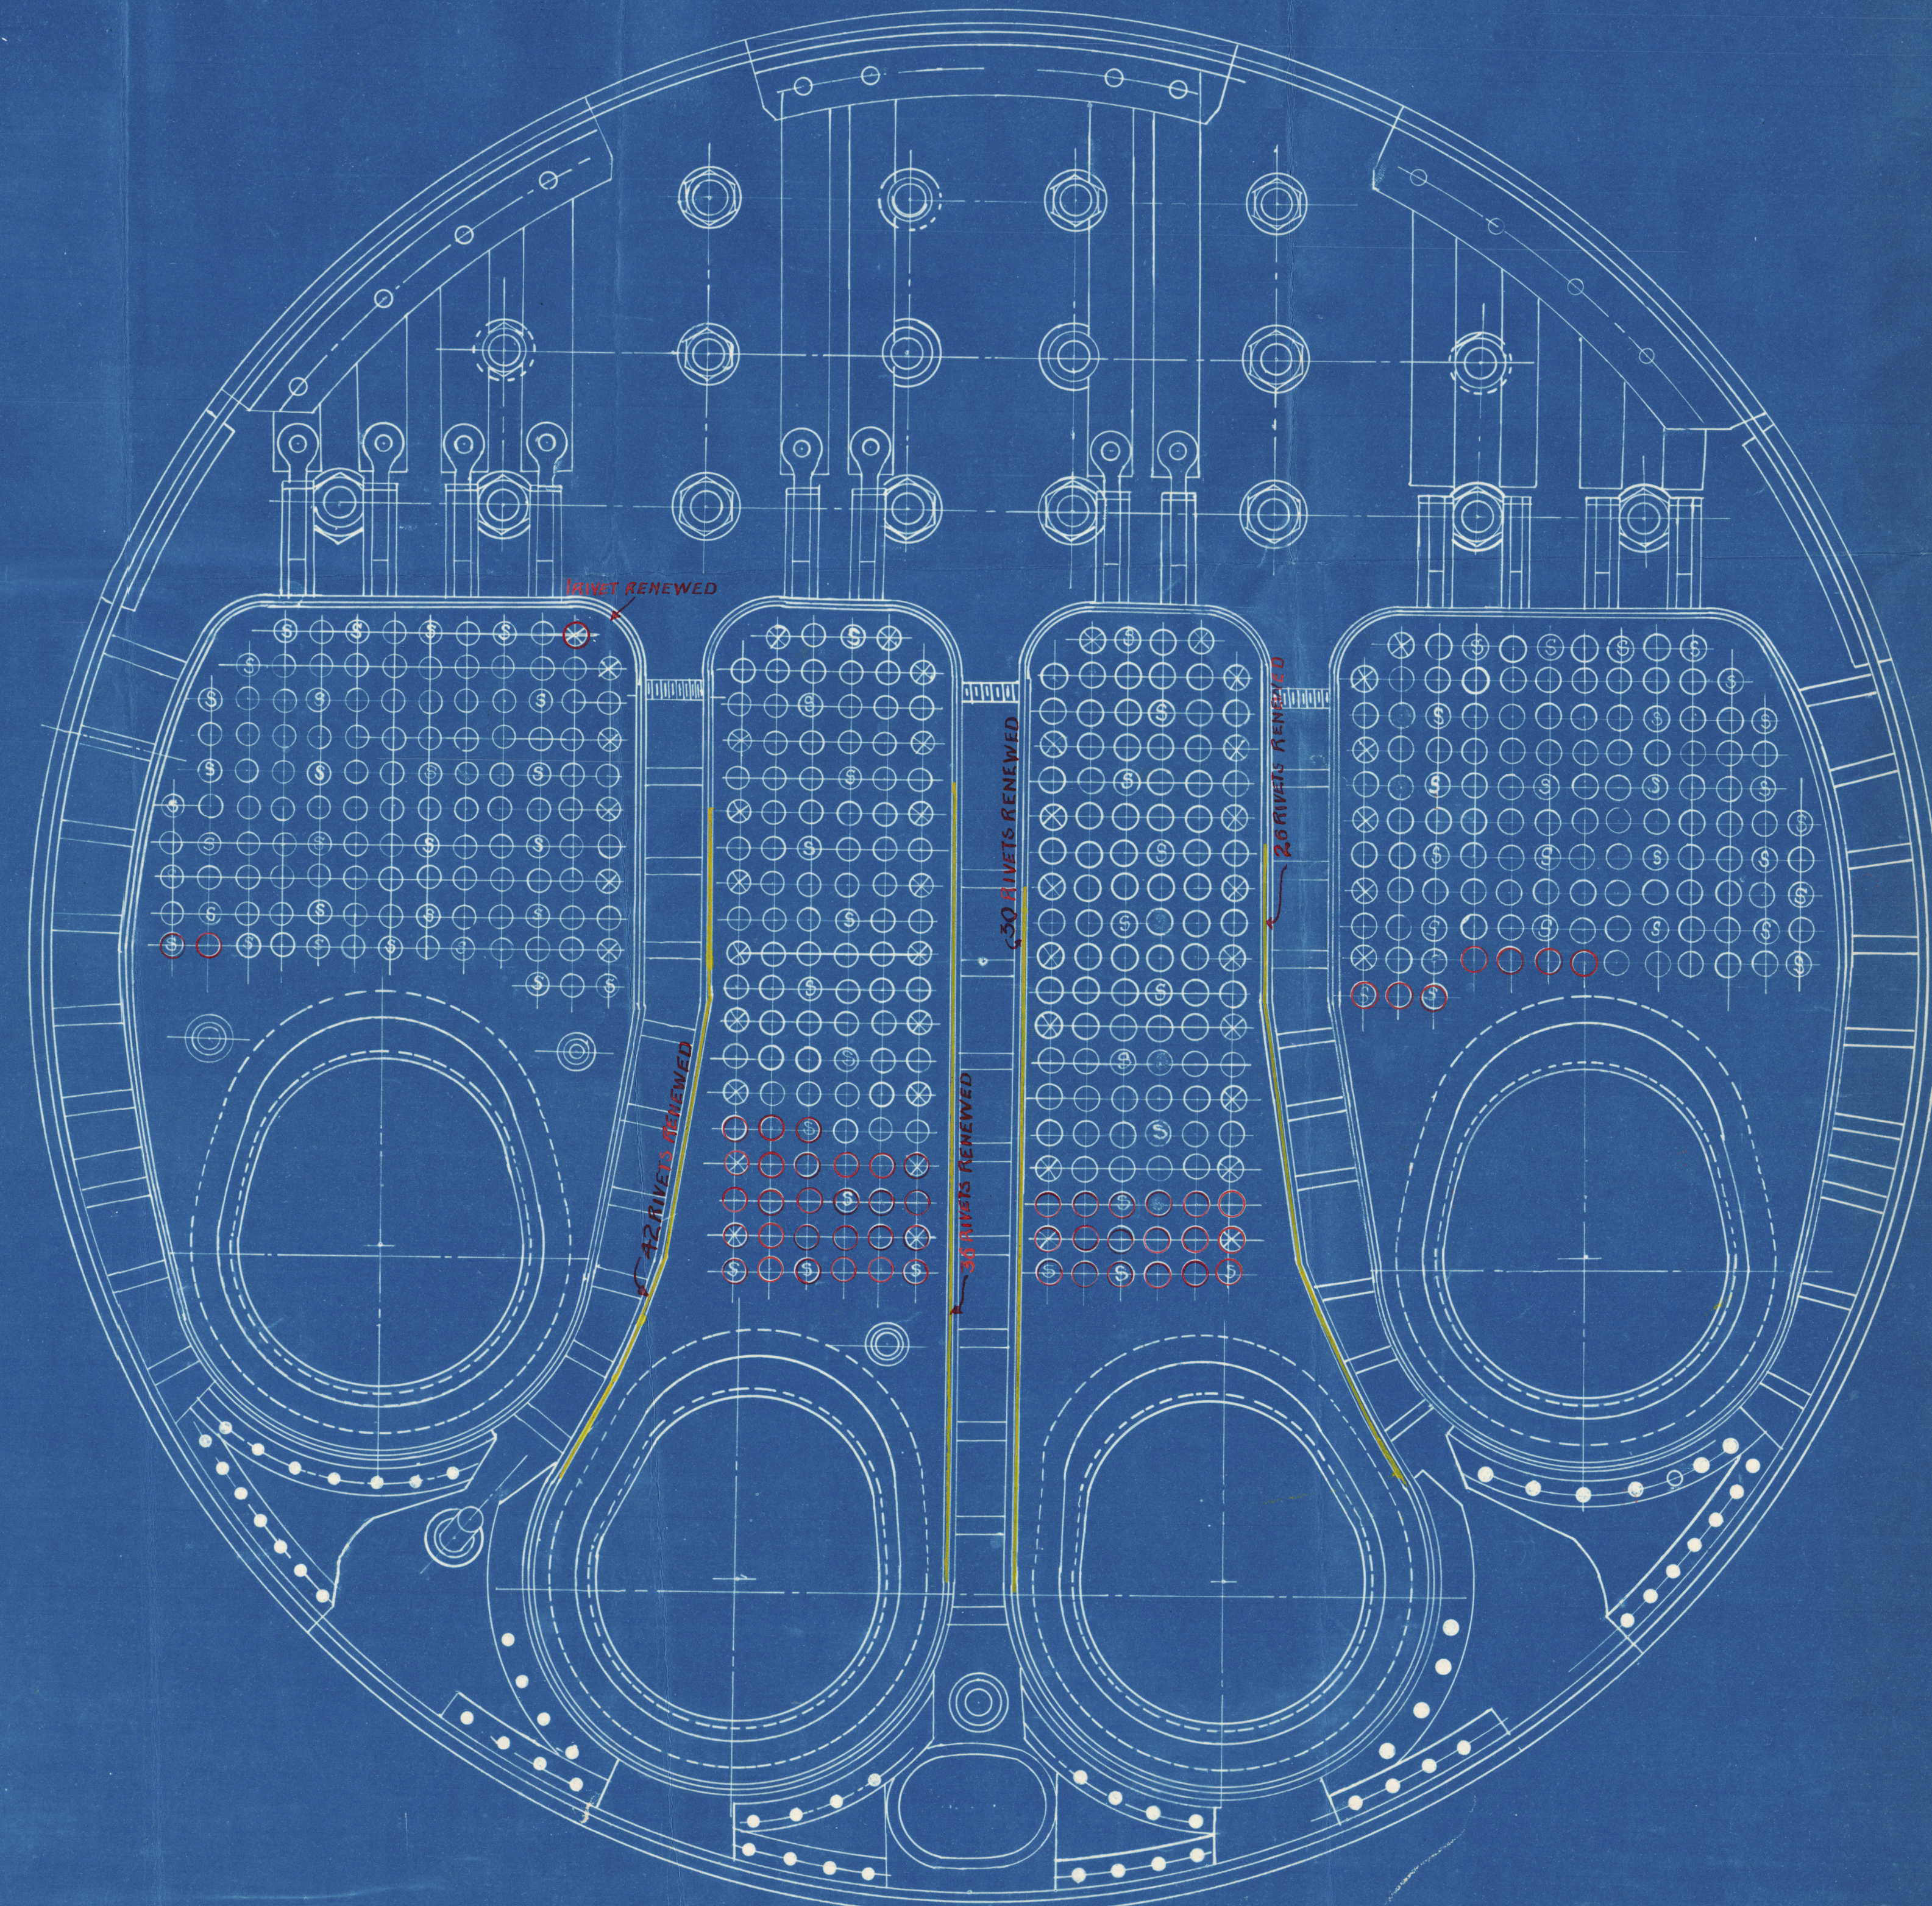

SECTION THROUGH COMBUSTION CHAMBER LOOKING FOR

MARK	
○	PLAIN TUBES
⊗	STAY " NO NUTS
⊗	" " "
⊗	" " WITH

S^r Otaki

London Apr 87326



© 2021

Lloyd's Register
Foundation

W20810062