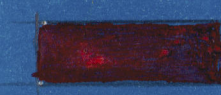



# SS OTAKI.


REPAIRS TO **FOR<sup>p</sup>** END OF **STB** DOUBLE ENDED BOILER.

SCALE - 1" = 1 FOOT


 = WORK RENEWED.

 = CHULKING.

 = WELDING.

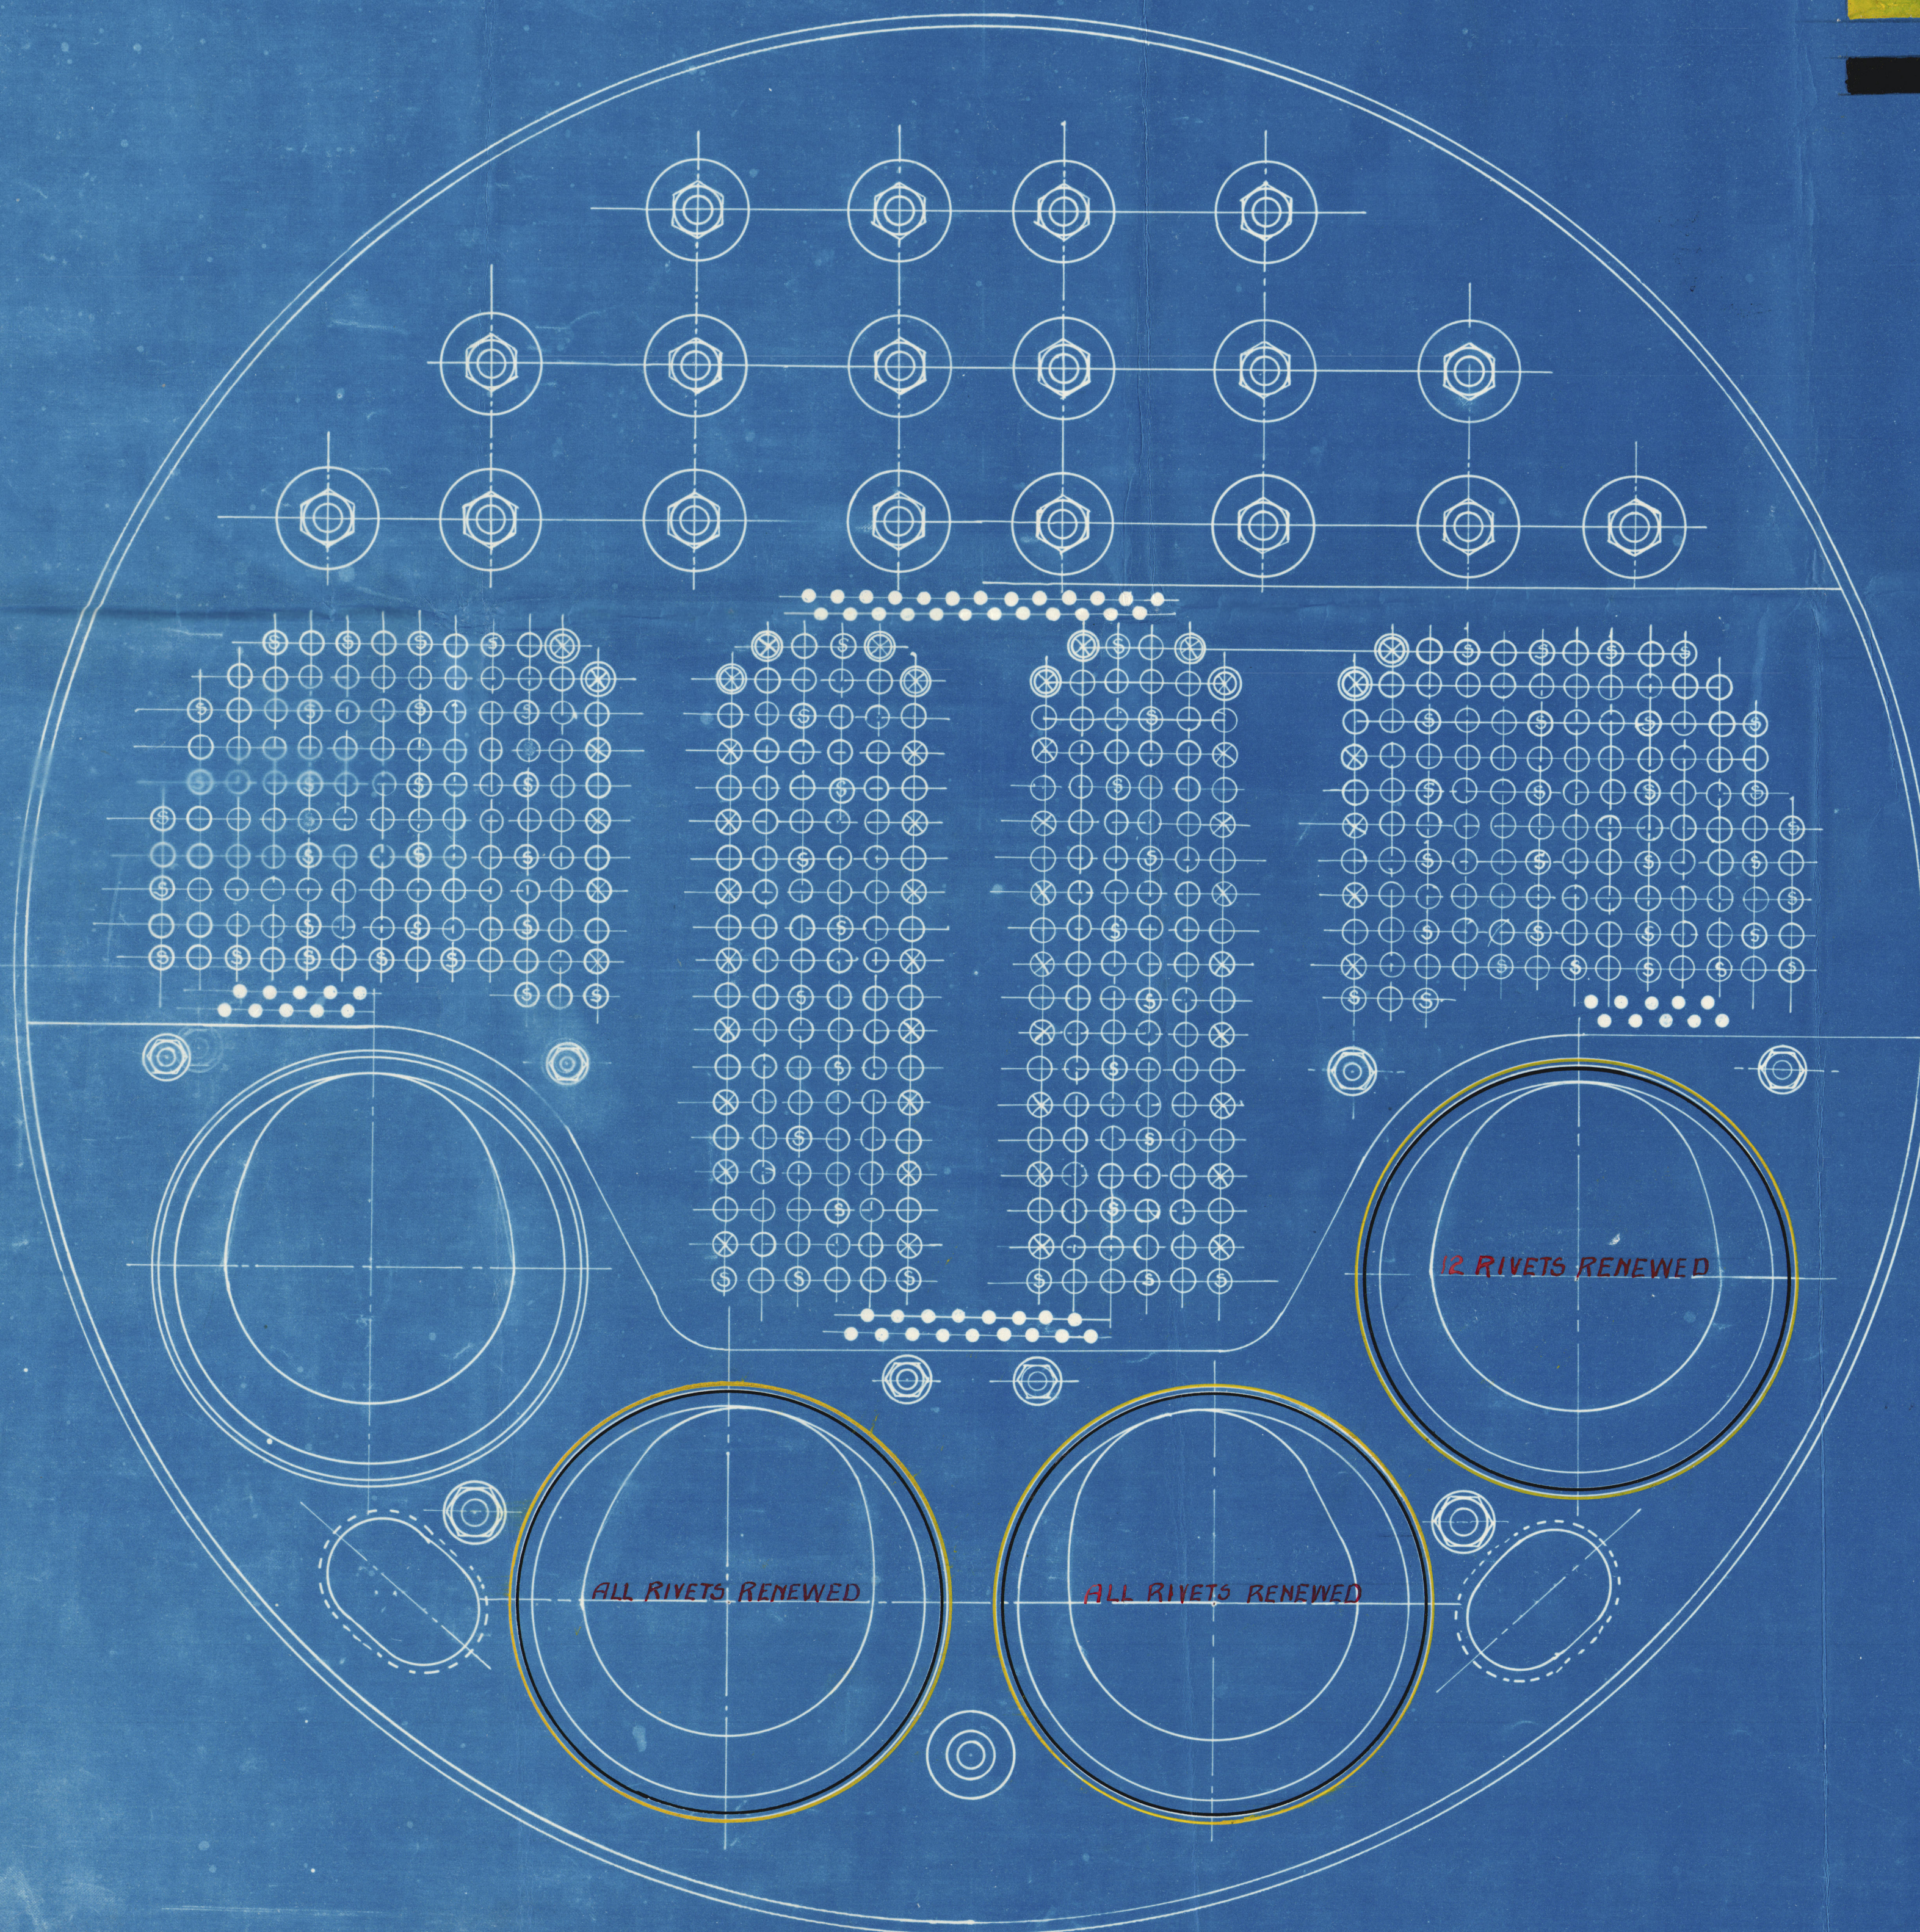

FRONT END **FOR<sup>p</sup>** OF BOILER

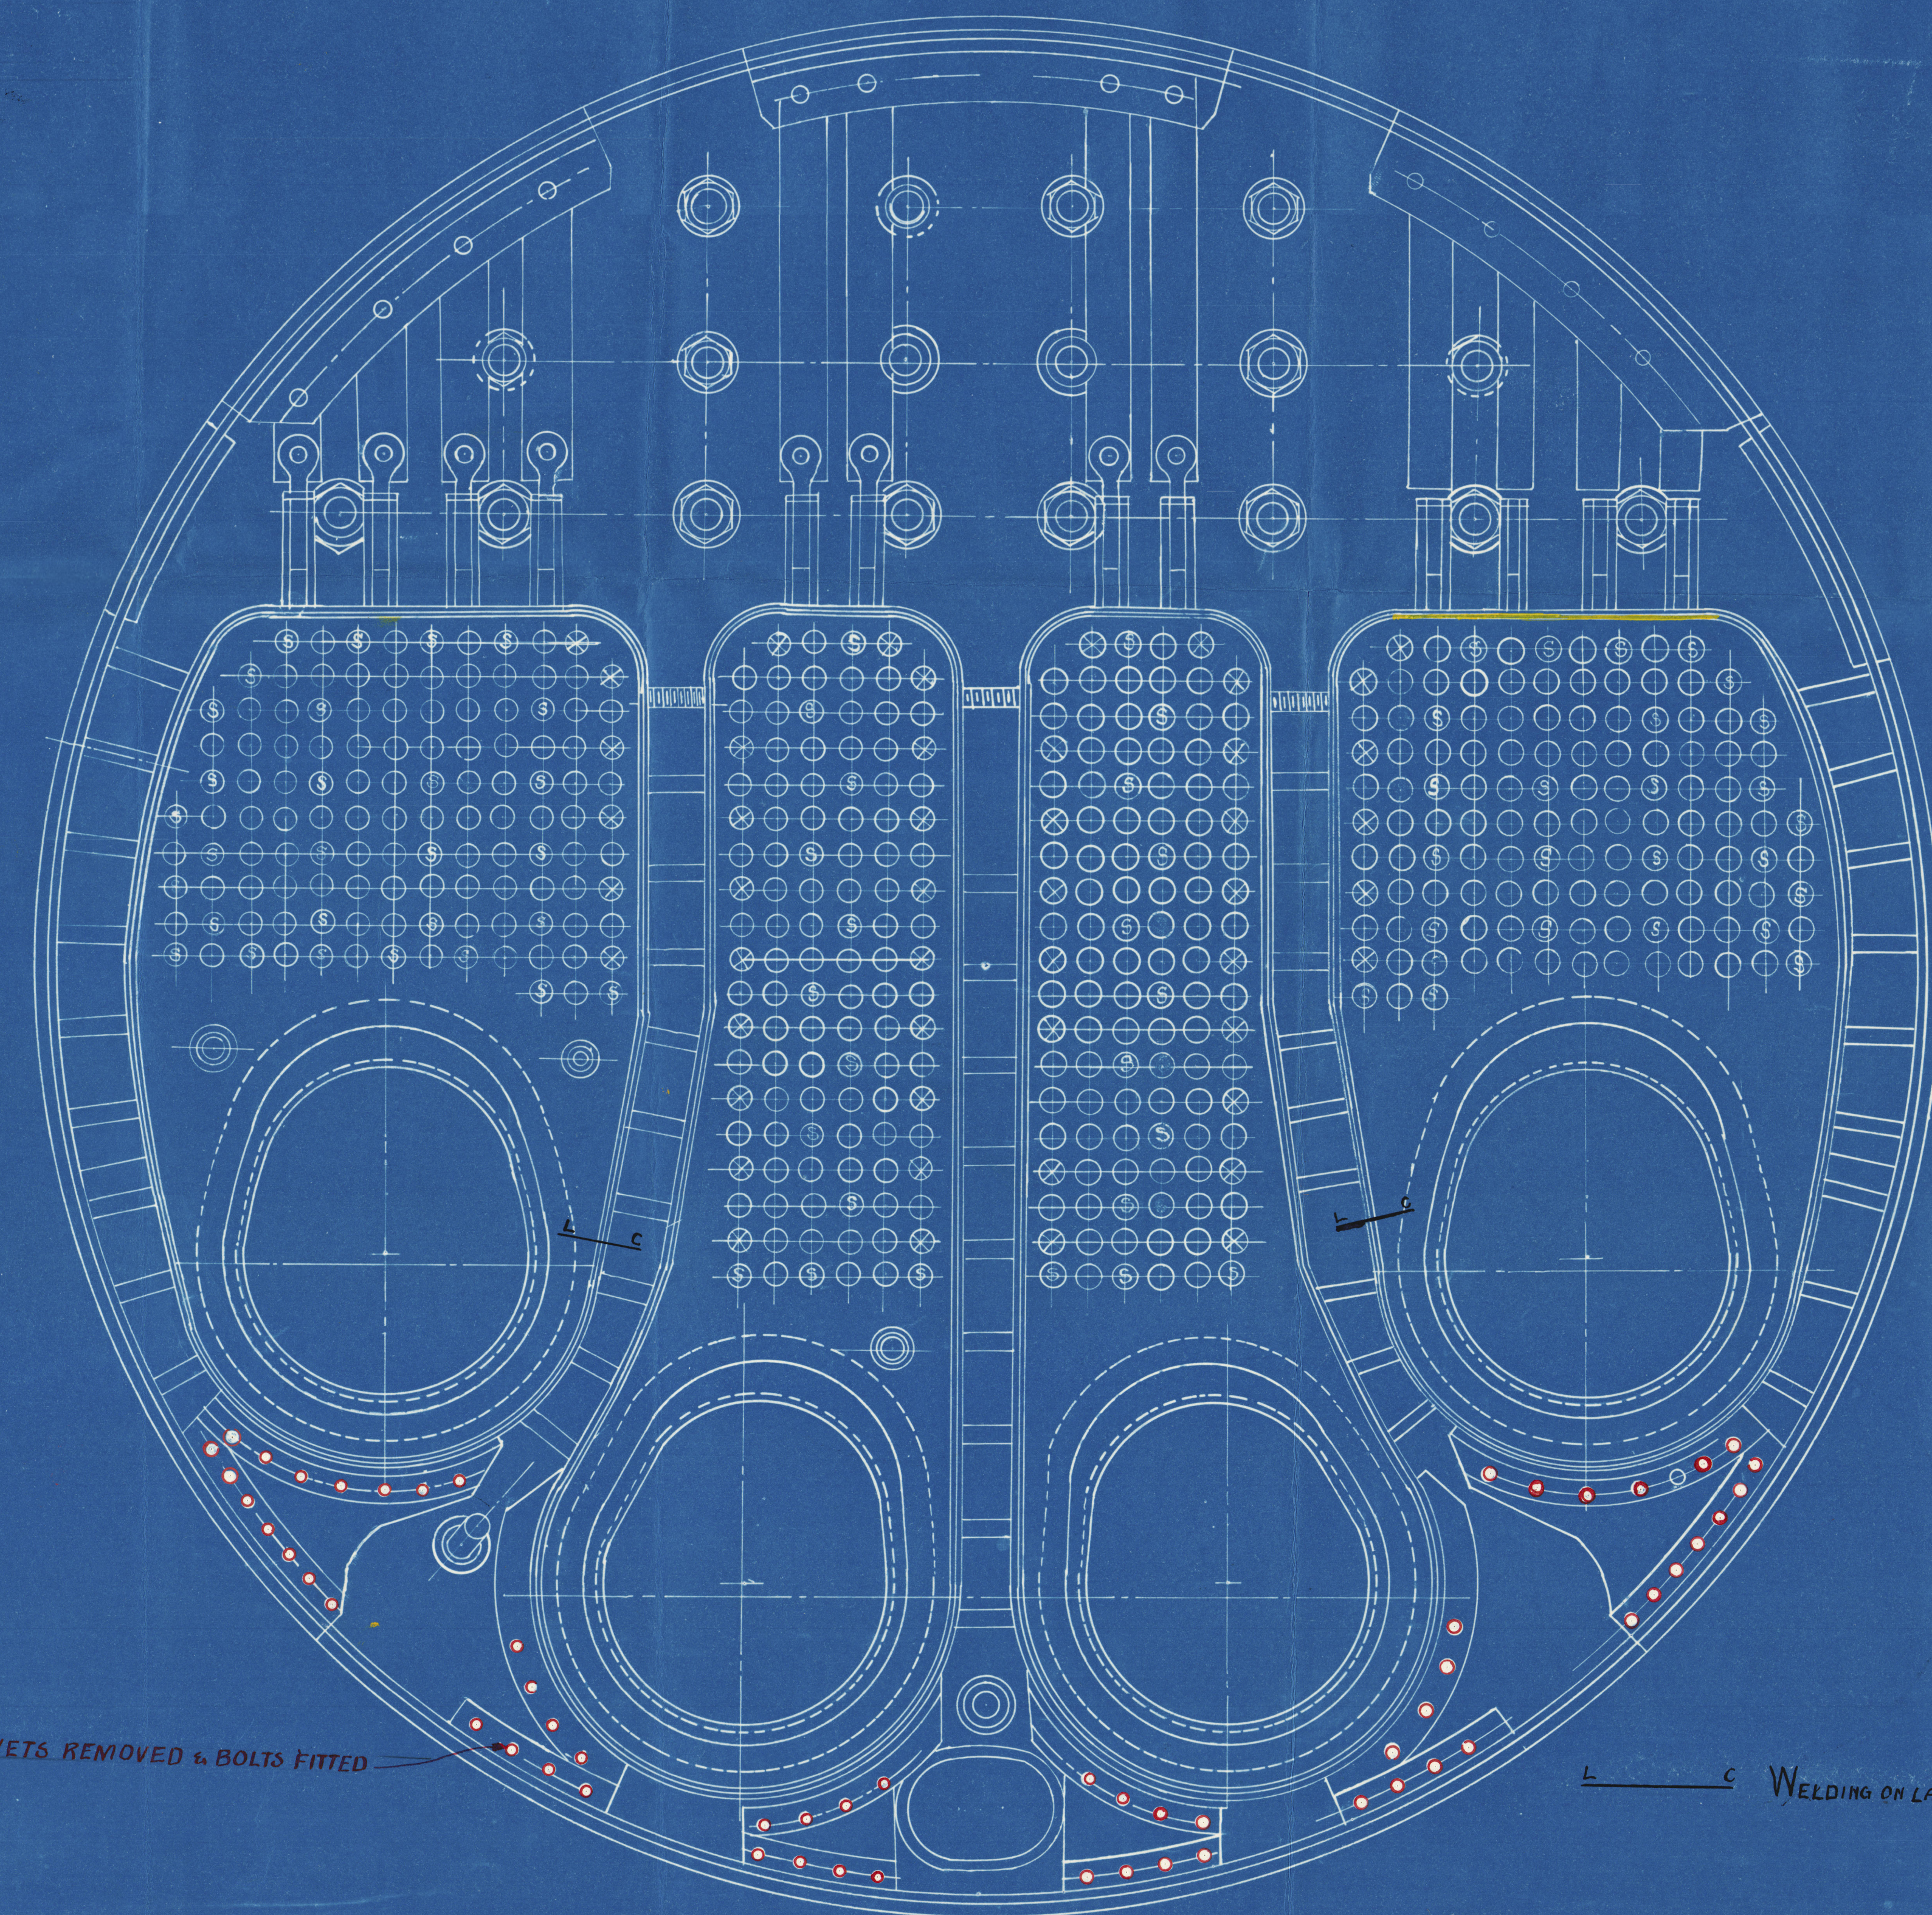

SECTION THROUGH COMBUSTION CHAMBER LOOKING **FOR<sup>p</sup>**

MARK	
○	PLAIN TUBES
⊗	STAY " NO NUTS
×	" " "
•	" WITH

*3/5 Otaki*

*London Rpt 87926*



© 2021

Lloyd's Register  
Foundation

W208-0063