

SS OTAKI.

REPAIRS TO AFT END OF PORT DOUBLE ENDED BOILER.



SCALE:- 1=1 FOOT

 = WORK RENEWED.

 = CHUCKING.

 = WELDING.

PAD FITTED FOR AUX STOP VALVE REFRIG ENGINE.

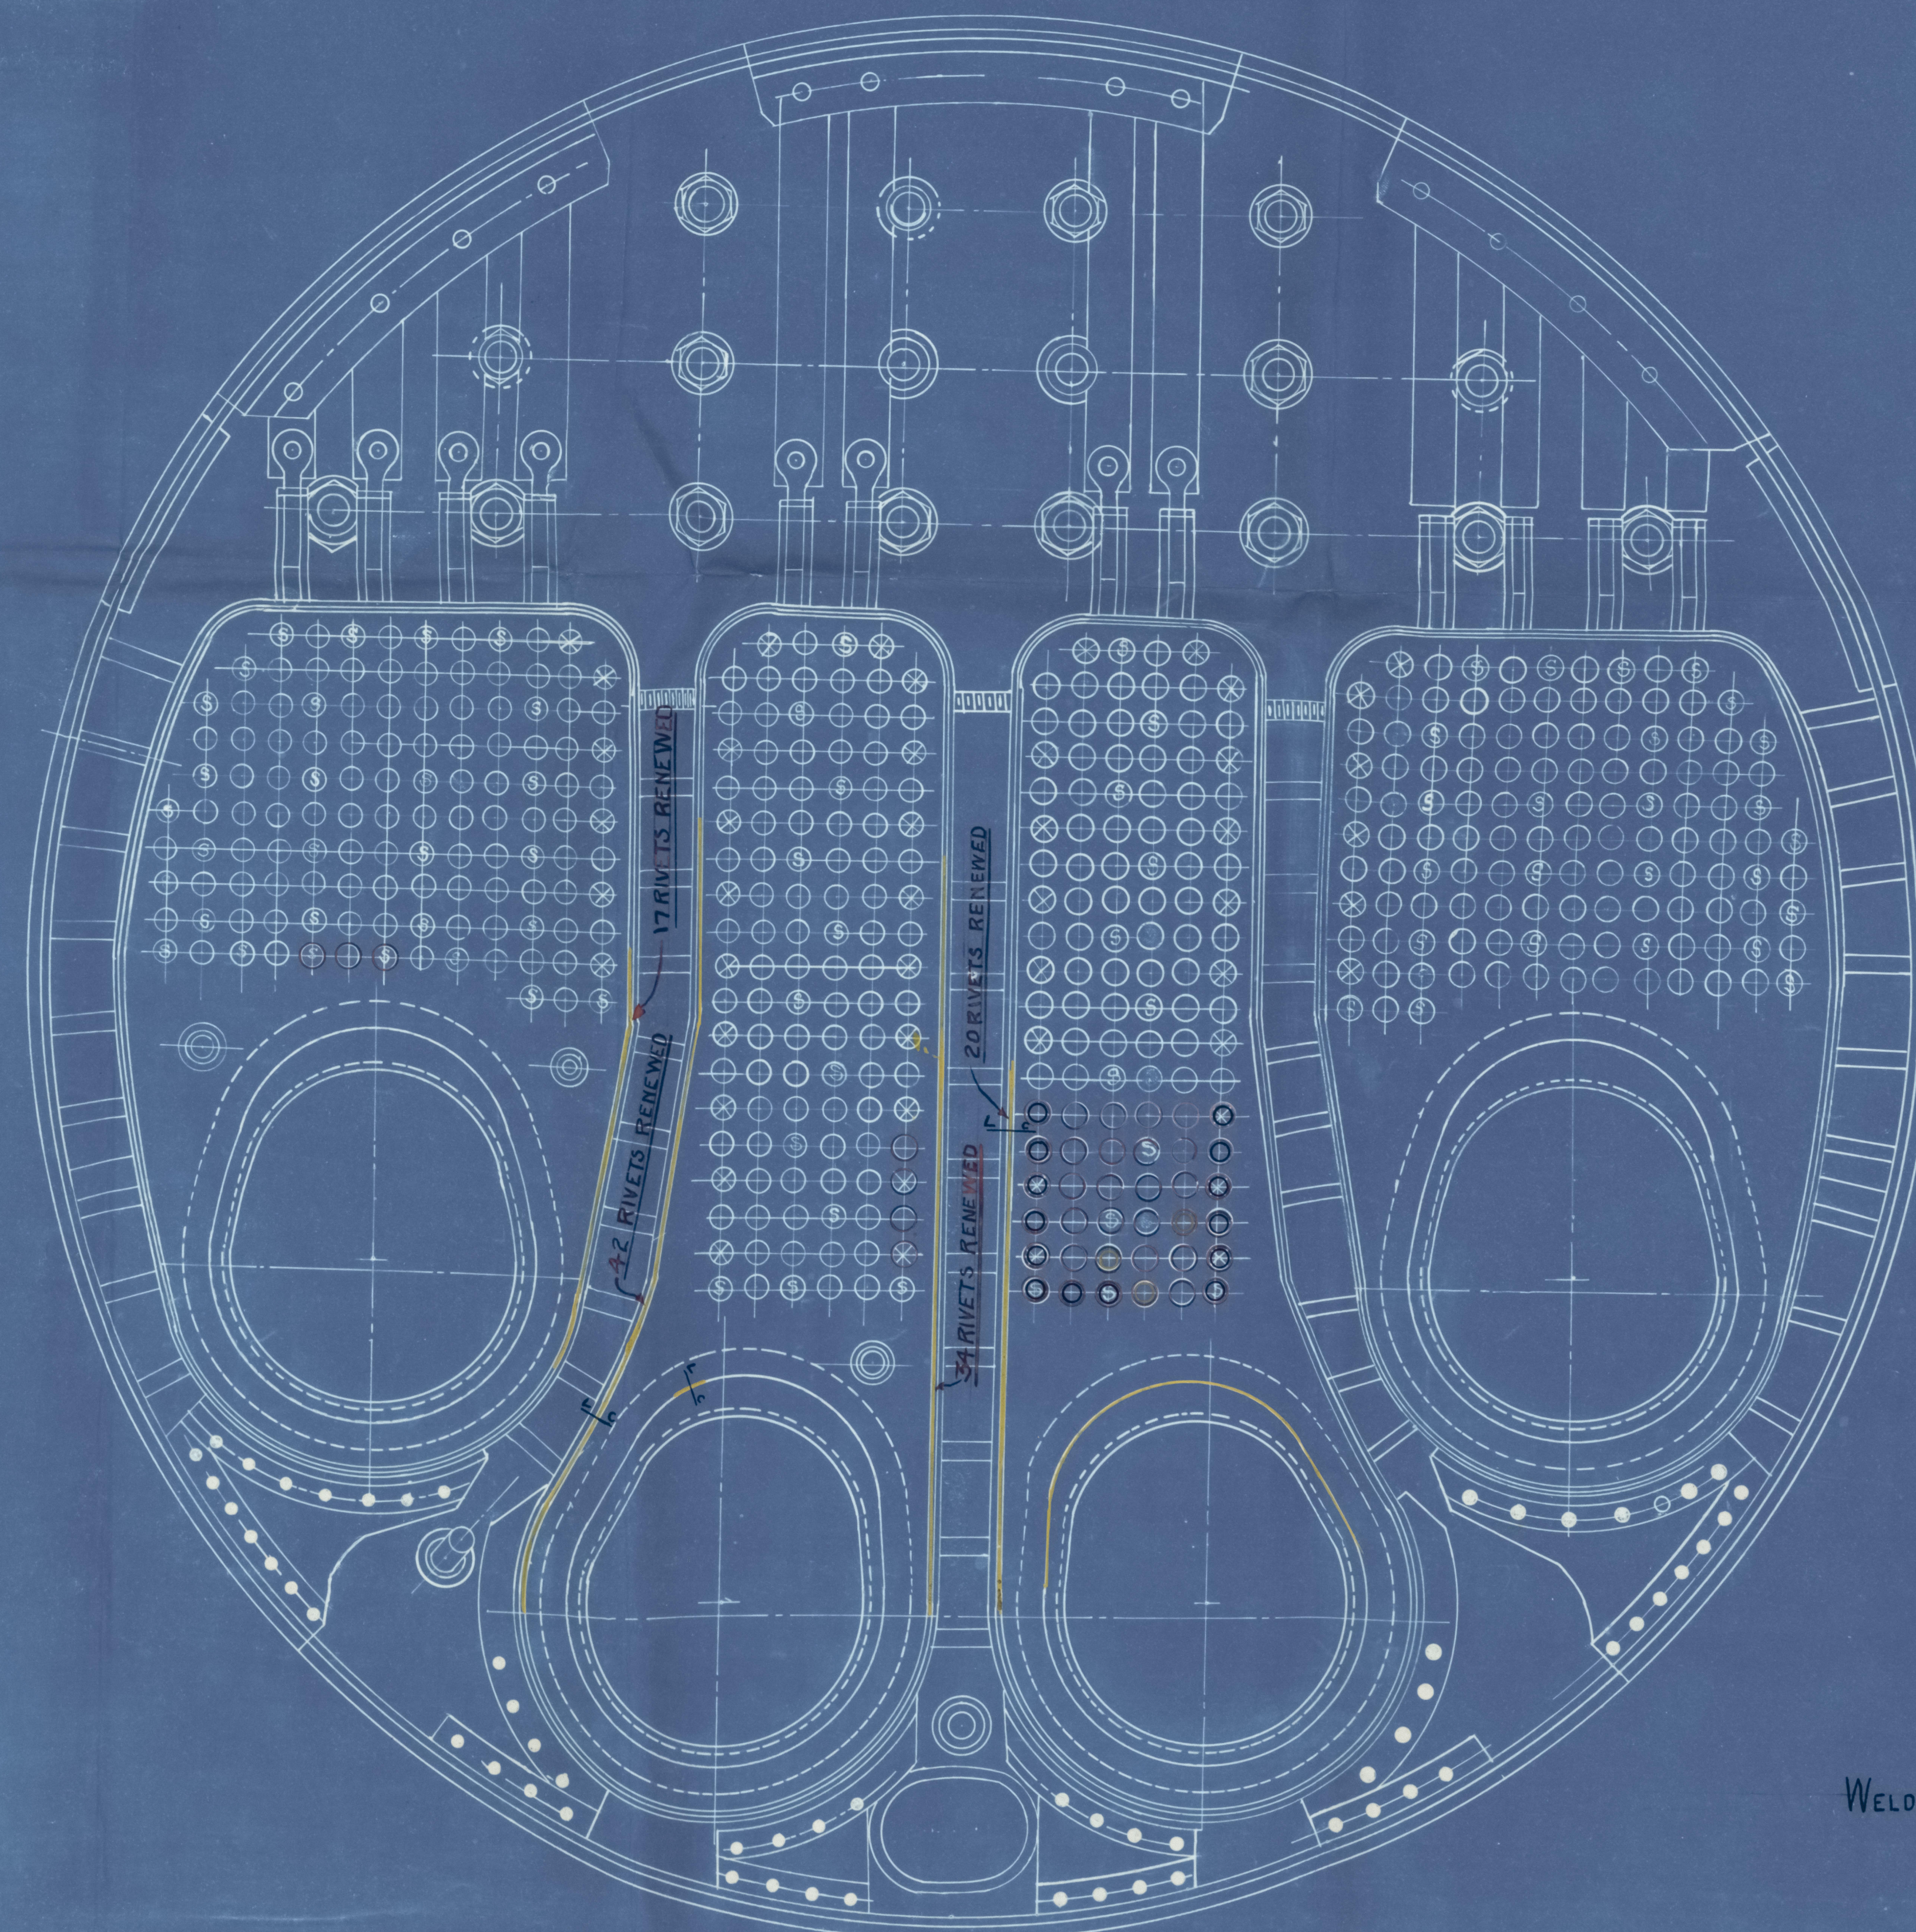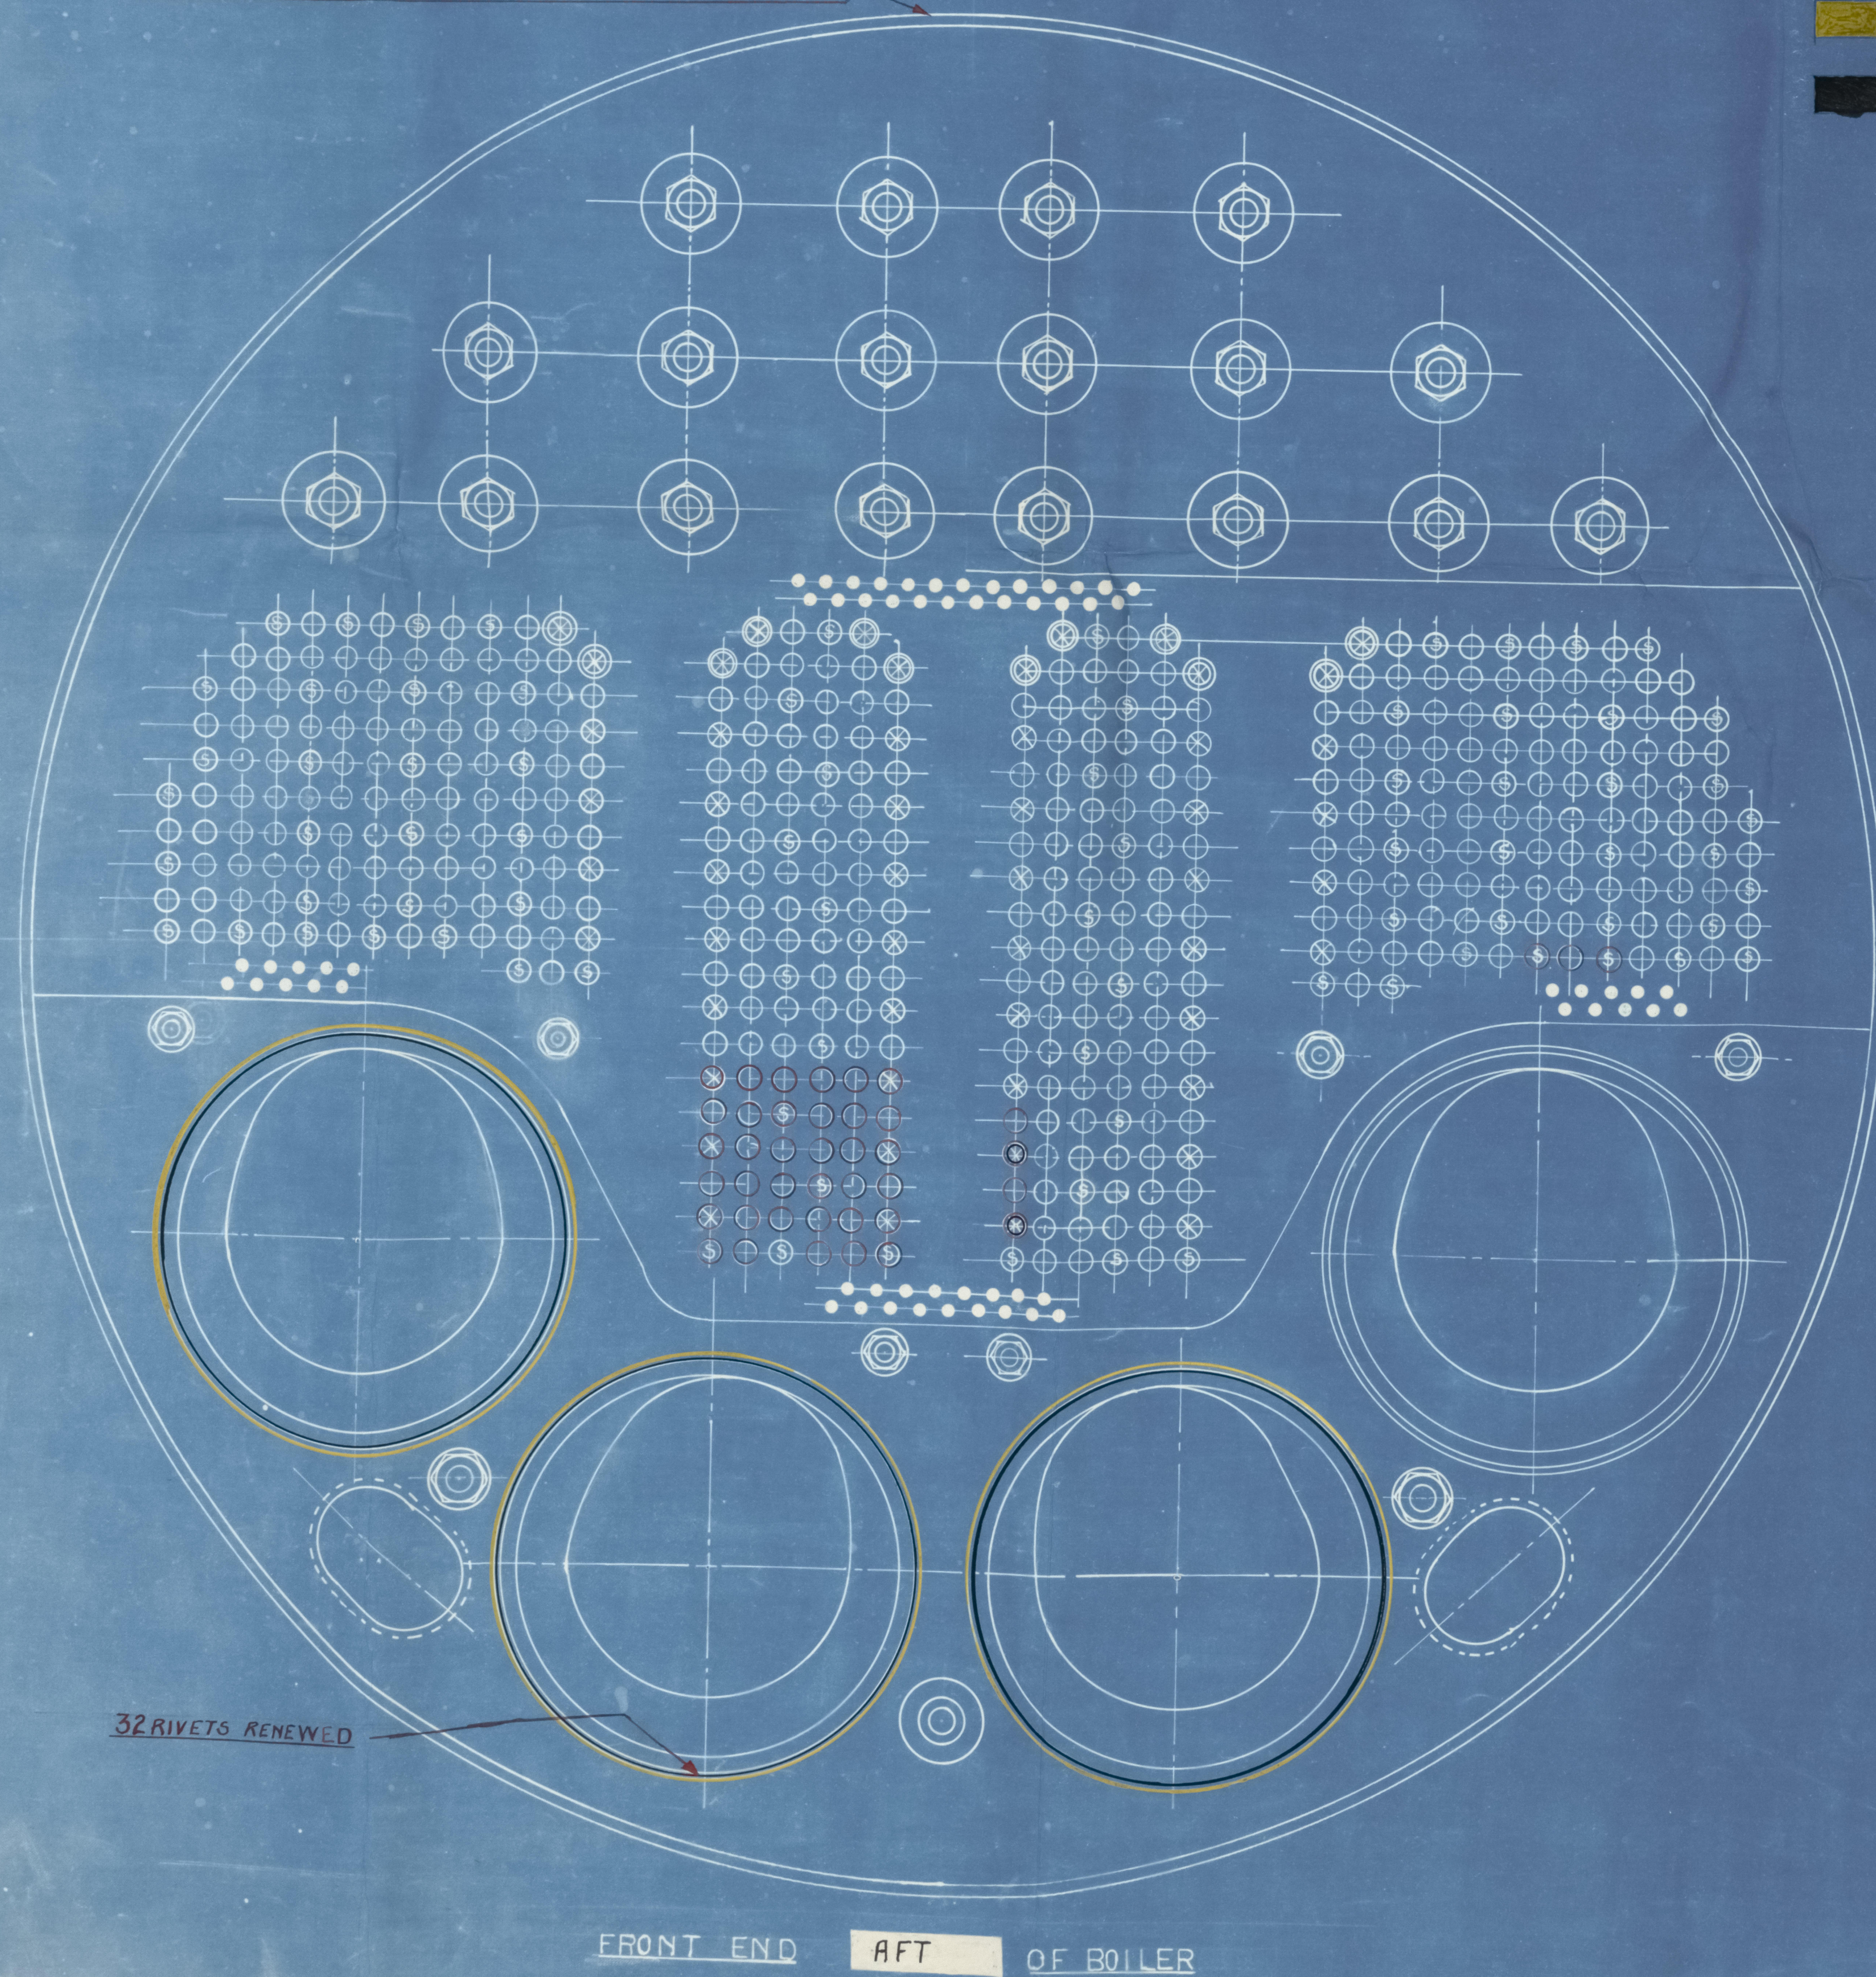

| MARK | |
|------|----------------|
| ○ | PLAIN TUBES |
| ⊗ | STAY " NO NUTS |
| ⊗ | " " WITH |
| ○ | " " WITH |

WELDING ON LANDING CRACKS SHOWN

SECTION THROUGH COMBUSTION CHAMBER LOOKING AFT.

BEEN AND SILLEY WELDED
Hf 2646
H.W.T.
SEP 1 1923

s/s Otaki

London Rpt 87326



© 2021

Lloyd's Register
Foundation

W208-0064