

S. S. OTAKI.

REPAIRS TO FOR<sup>D</sup> SINGLE ENDED BOILER.


SCALE - 1" = 1 FOOT.

WORK RENEWED


CAULKING

WELDING

PAD FITTED FOR AUX STOP VALVE REFUG ENGINE.

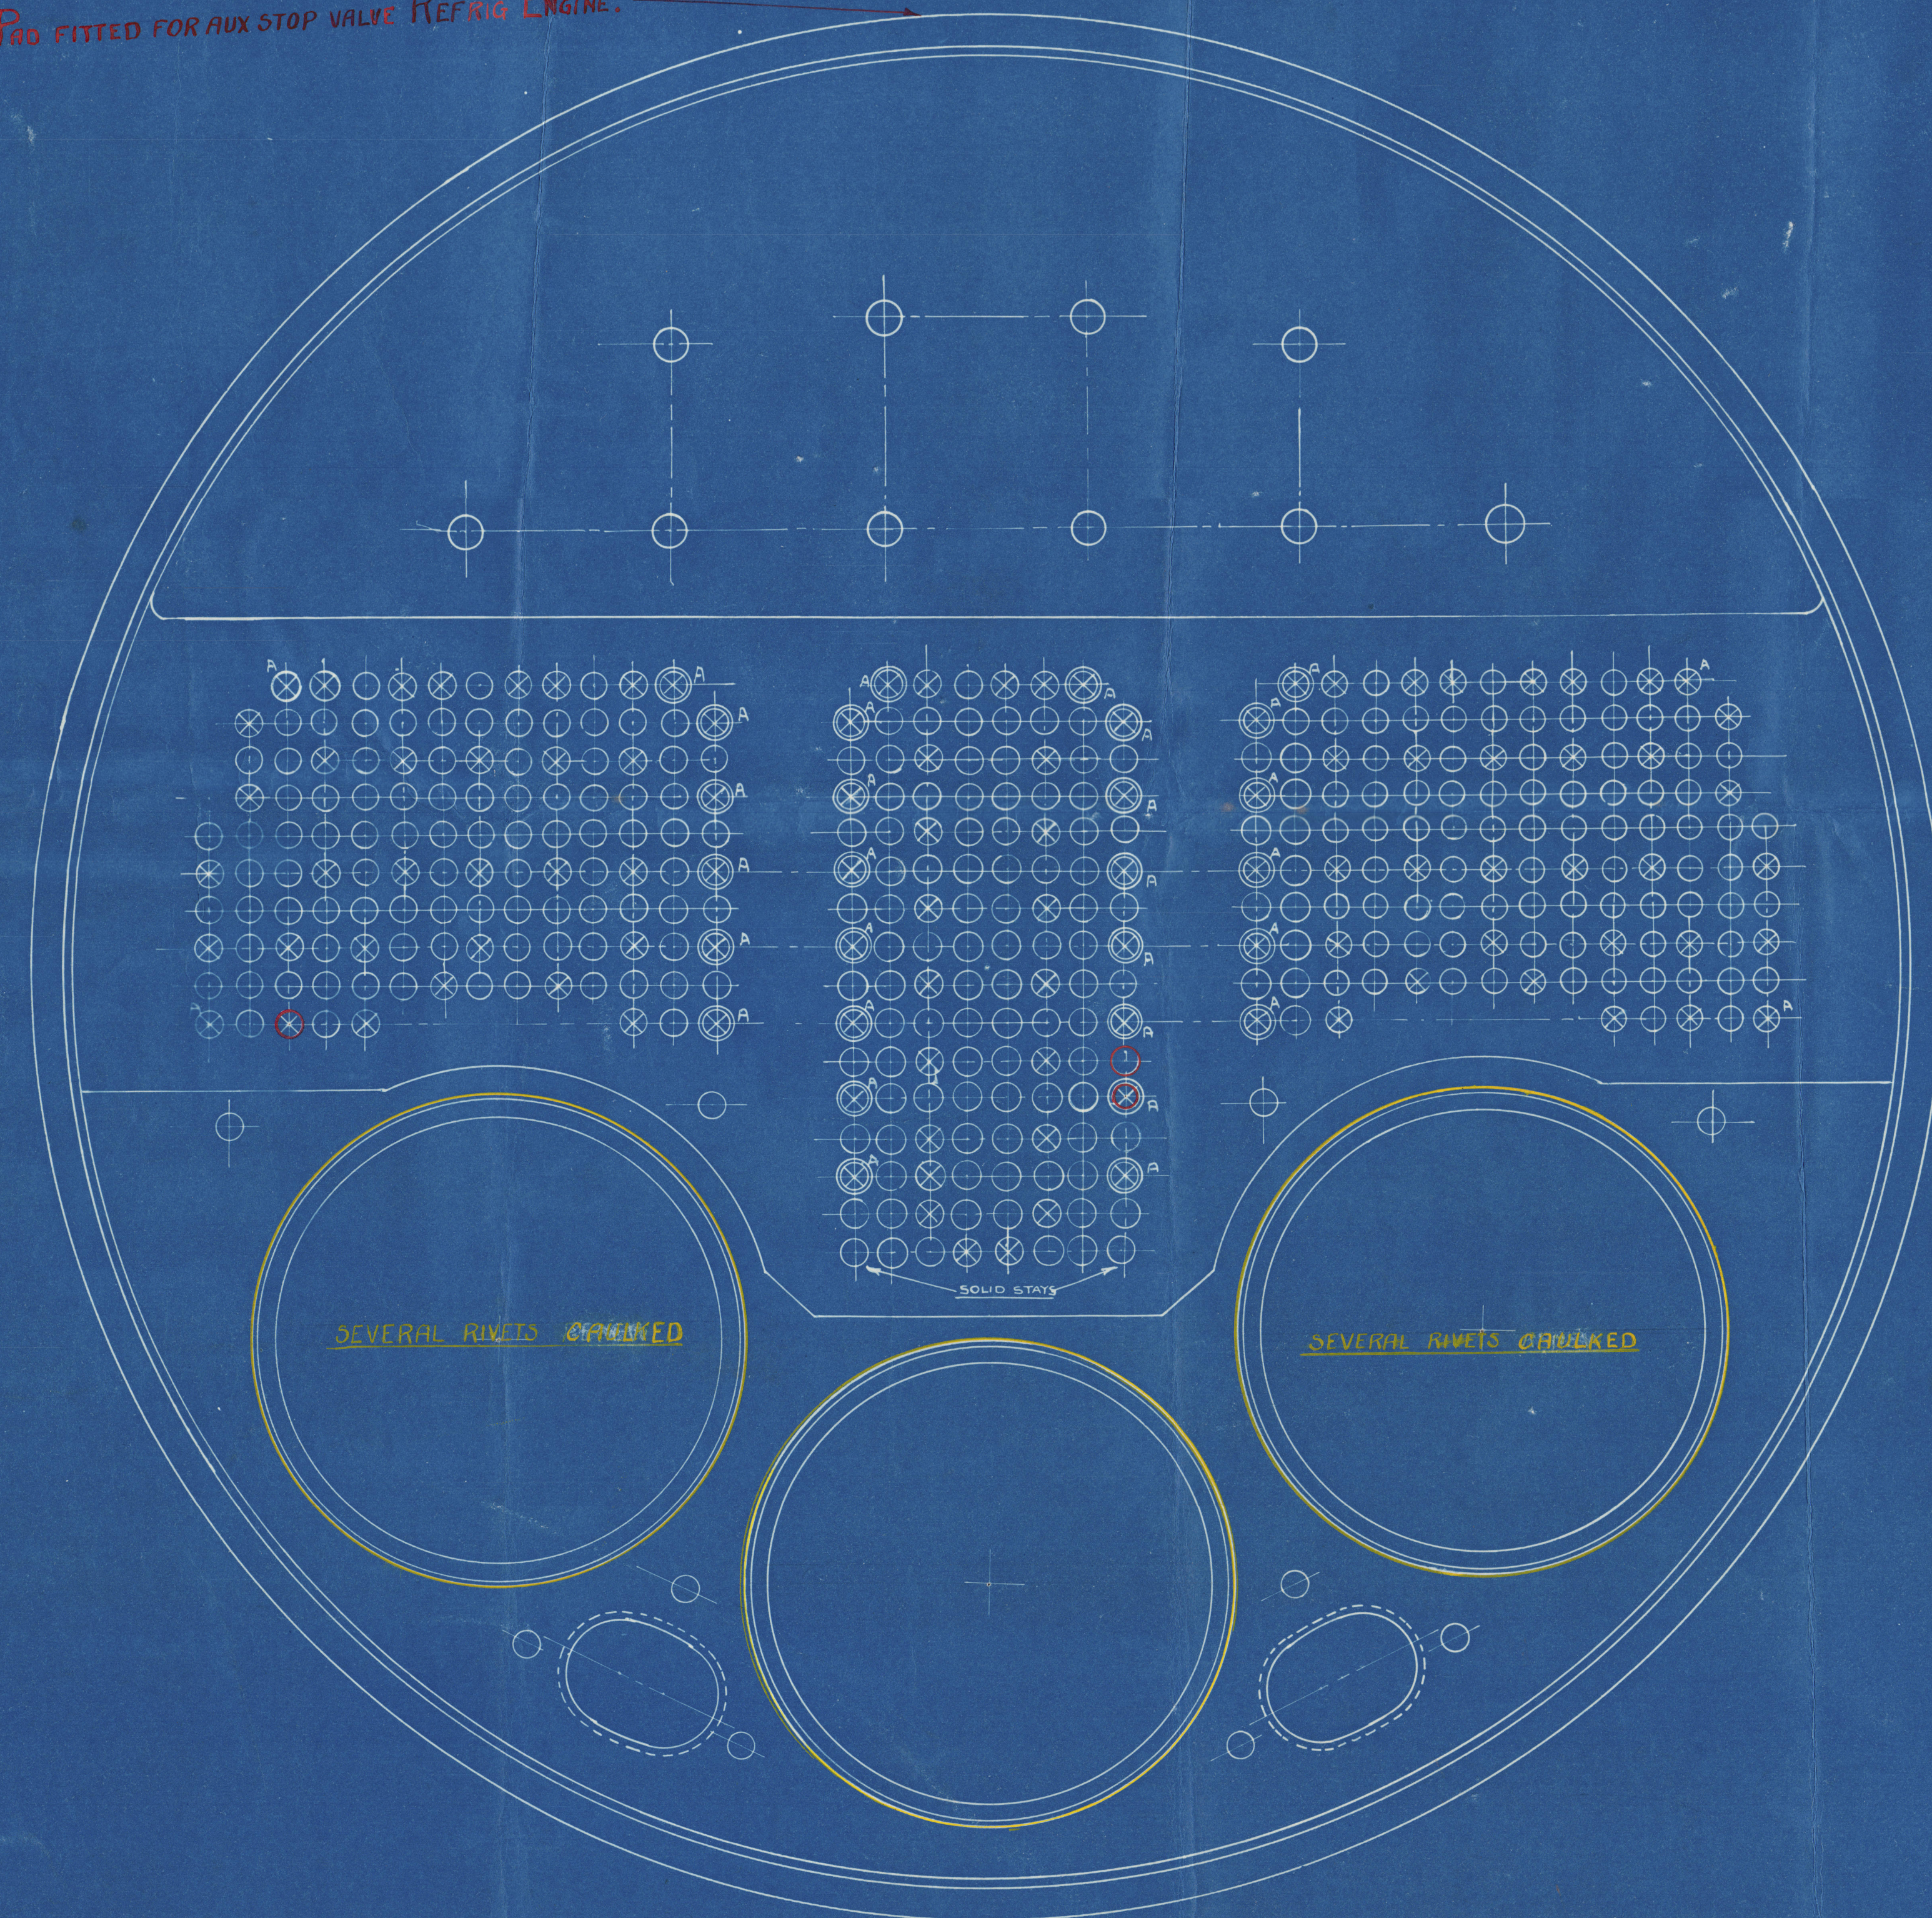


FRONT END

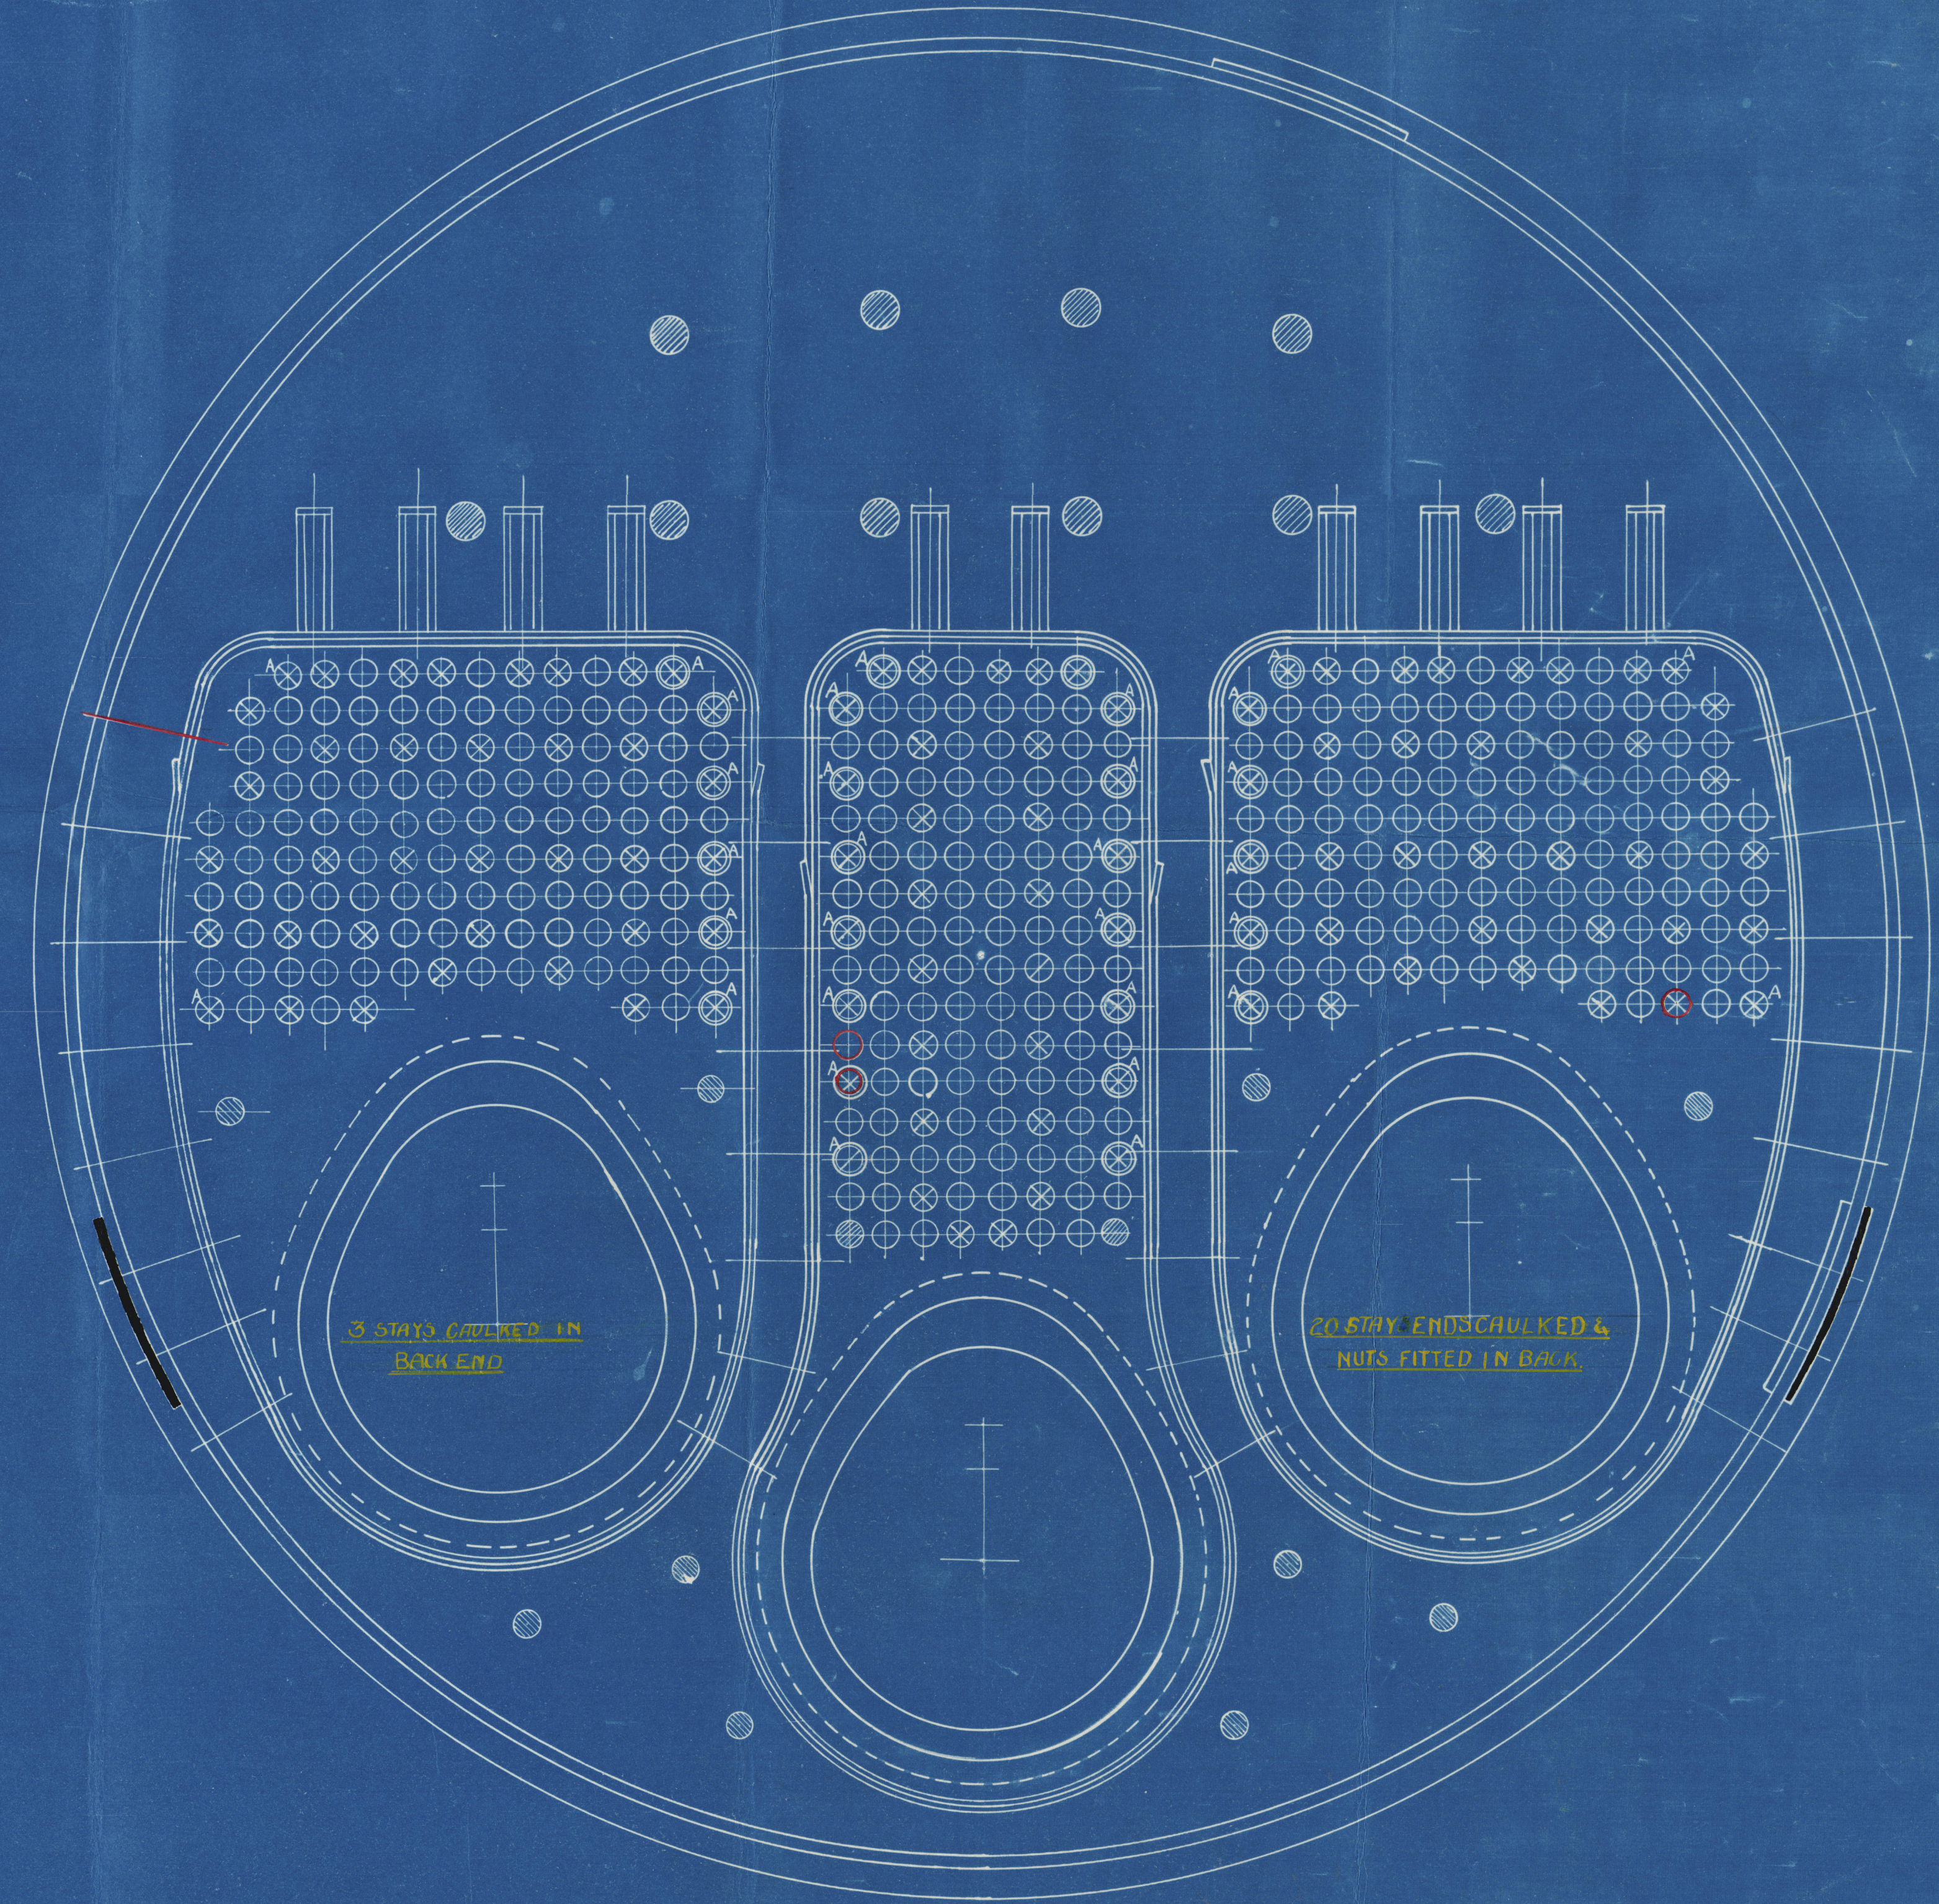

SECTION THRU COMBUSTION CHAMBER LOOKING TO FRONT END.

MARK	DESCRIPTION
○	PLAIN TUBES 2 1/2" EXT. DIA. 9 W.G. THICK
⊗	STAY TUBES 2 1/2" EXT. DIA. 9 W.G. THICK
⊗	STAY TUBES 2 1/2" EXT. DIA. 9 W.G. THICK
⊗	STAY TUBES FITTED WITH NUTS

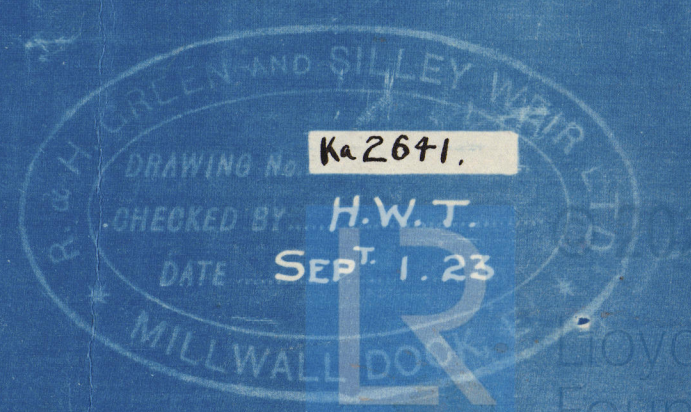

0208-0065



s/s Otaki

London Rpt 87326



© 2021

W208-0065

Lloyd's Register  
Foundation