


DB 105 Steel Twin Screw Steamer for the N.Y. "Nederland."

1.6.09

Midship Section showing re-arrangement of Shell-strakes

to get a clear shifting of edges and stringers or keelsons.

— Scale $\frac{1}{2}" = 1'-0"$ —

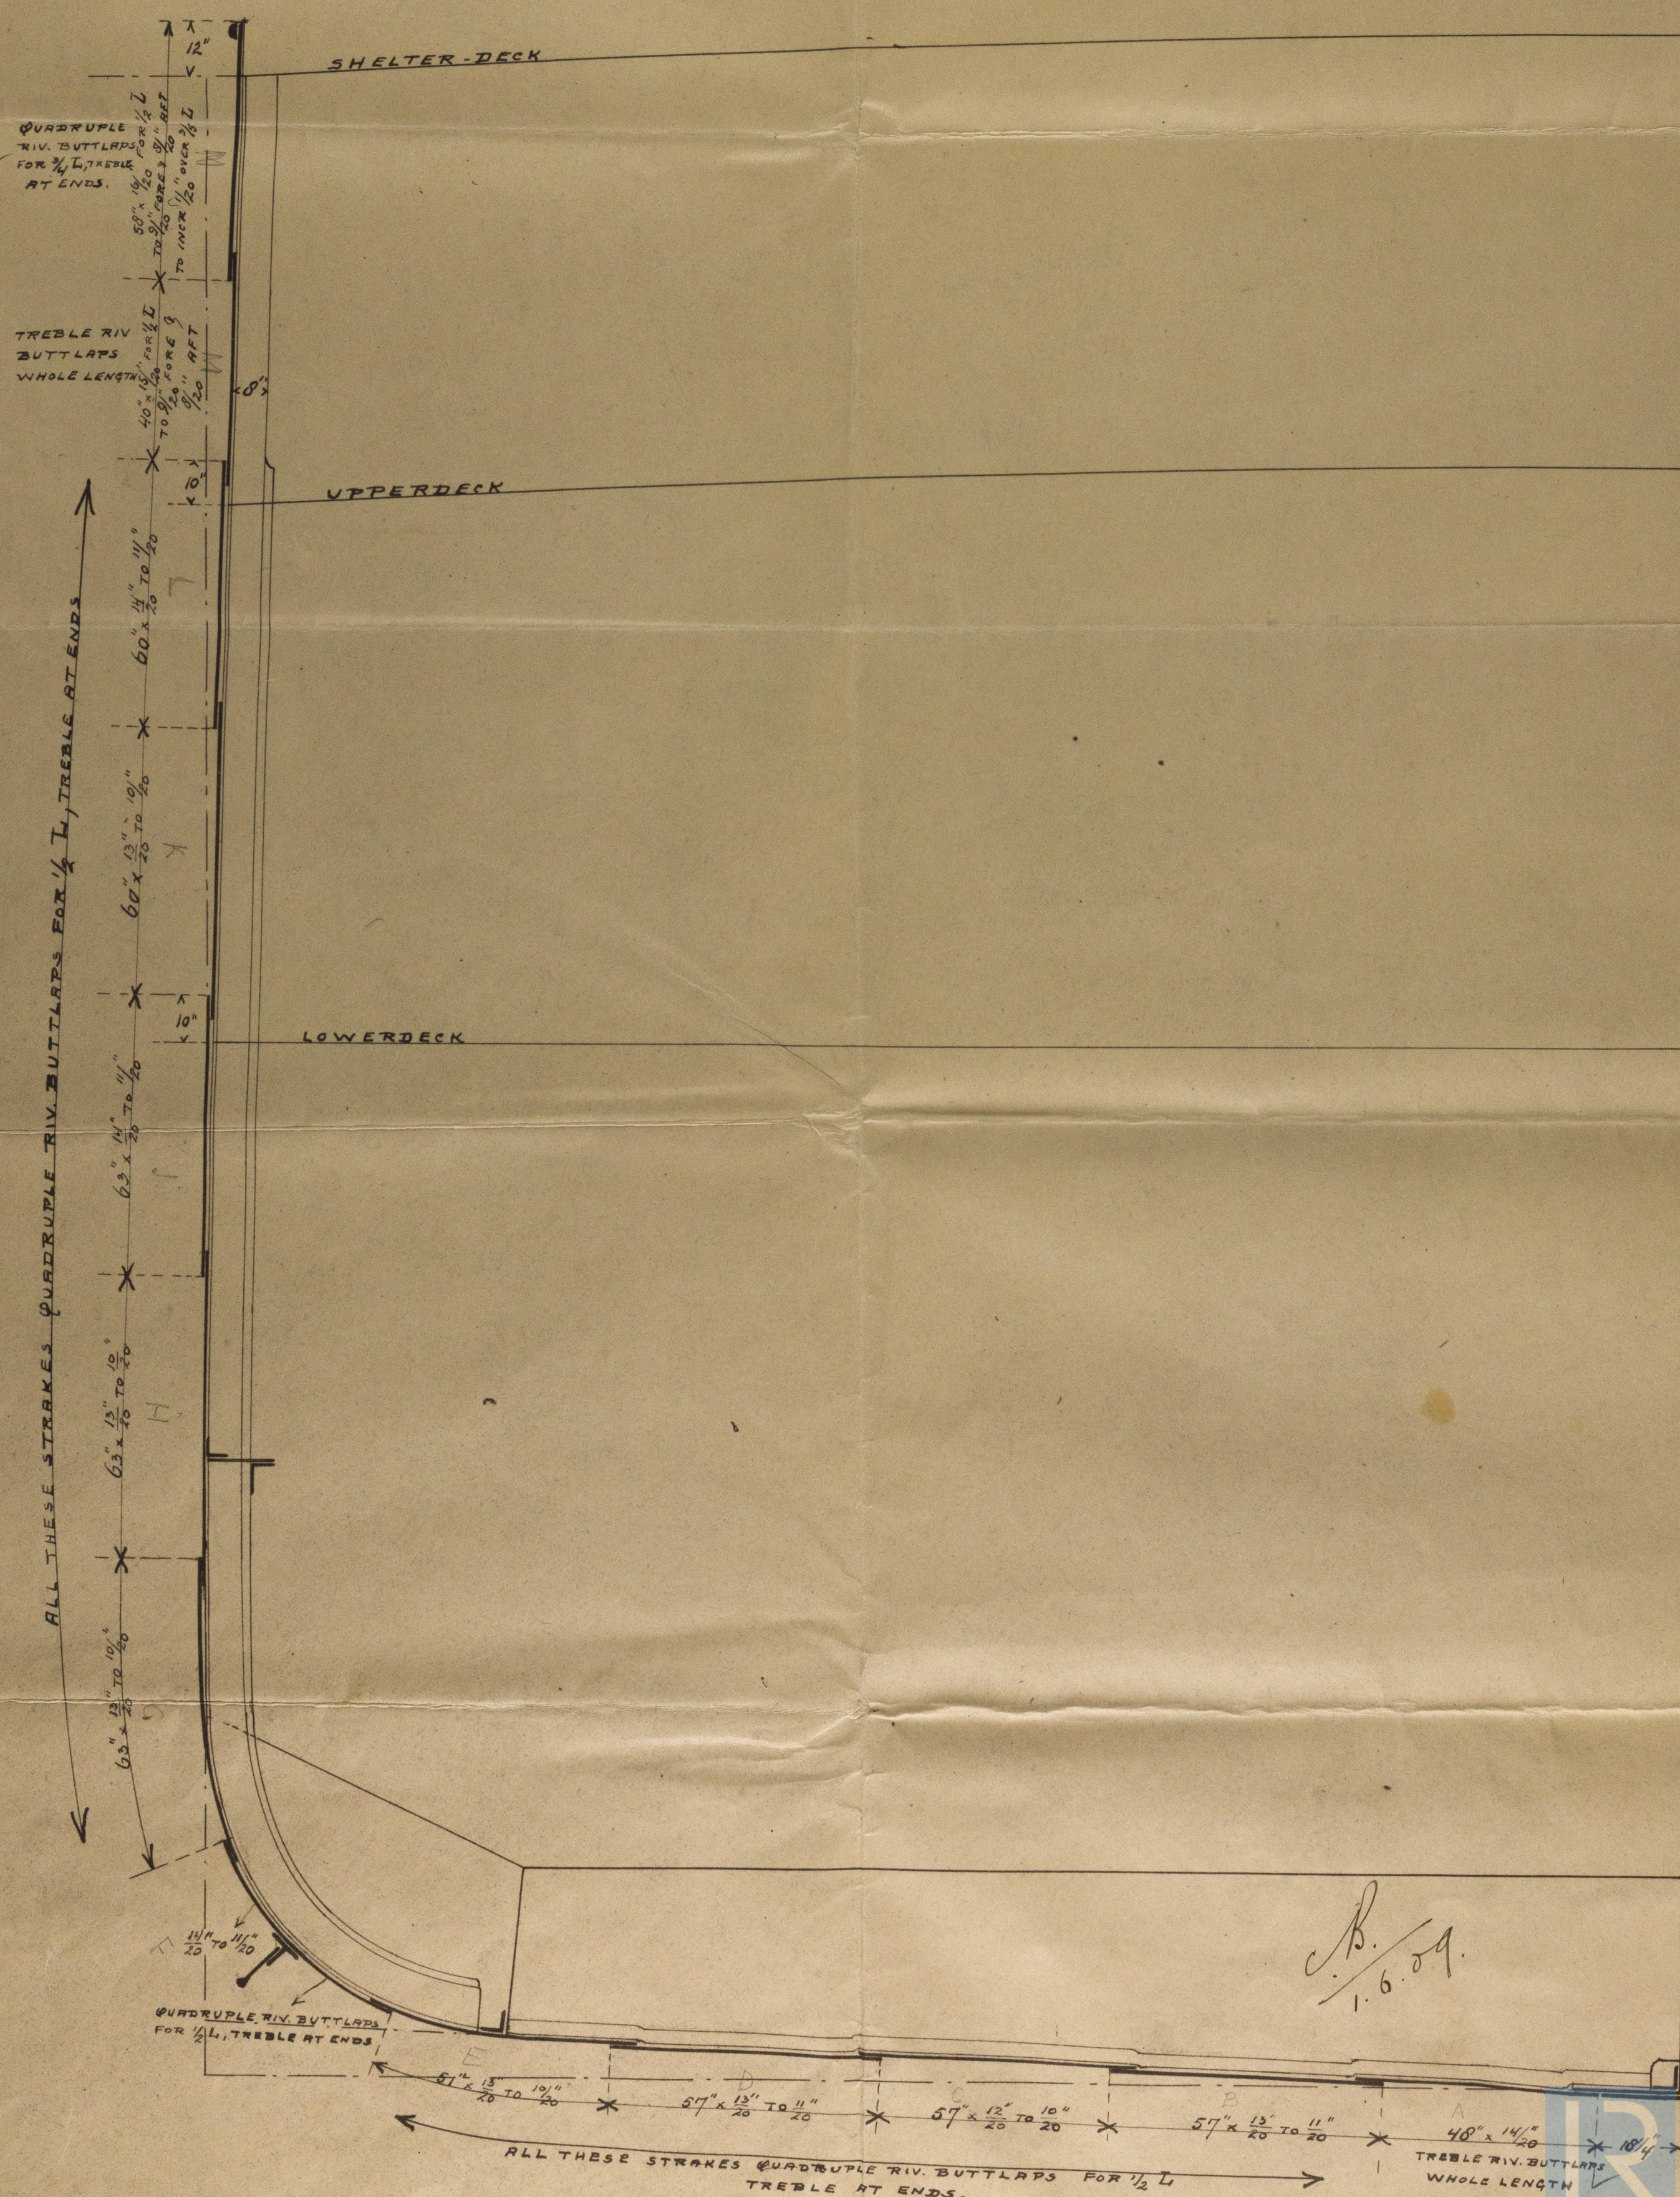

B. 1.6.09



Miss Schreyer's Mount

N^o 105.

Improved Weddell's Section

Shellpith "Costa Rica."
T.S. Pringles Juliana^{ex}
Ans 6635.



© 2019

Lloyd's Register
Foundation
W21-0252