

8.4.09.
29.4.09.
20.5.09.
1.6.09
2.7.09
8.11.09

To Class 100 A. 1. Threedeck Type with Shelterdeck.


Scale 1:24.

PRINCIPAL DIMENSIONS.

LLOYD'S NUMERALS

LENGTH, BETWEEN PERPENDICULARS	455.0
BREADTH, EXTREME TO OUTSIDE OF FRAMES	55.0
DEPTH, MID. AT SIDE TO SHELTER DECK.	37.8
RISE OF FLOOR	

3-HEATER 30" L	
BREADTH	27.50
GIRTH	53.66
DEPTH WITH NORMAL ROUNDUP	30.40
	111.56
	- 7.00
1 st NUMBER.	104.56
LLOYDS LENGTH	4.53
2 nd NUMBER.	473.66

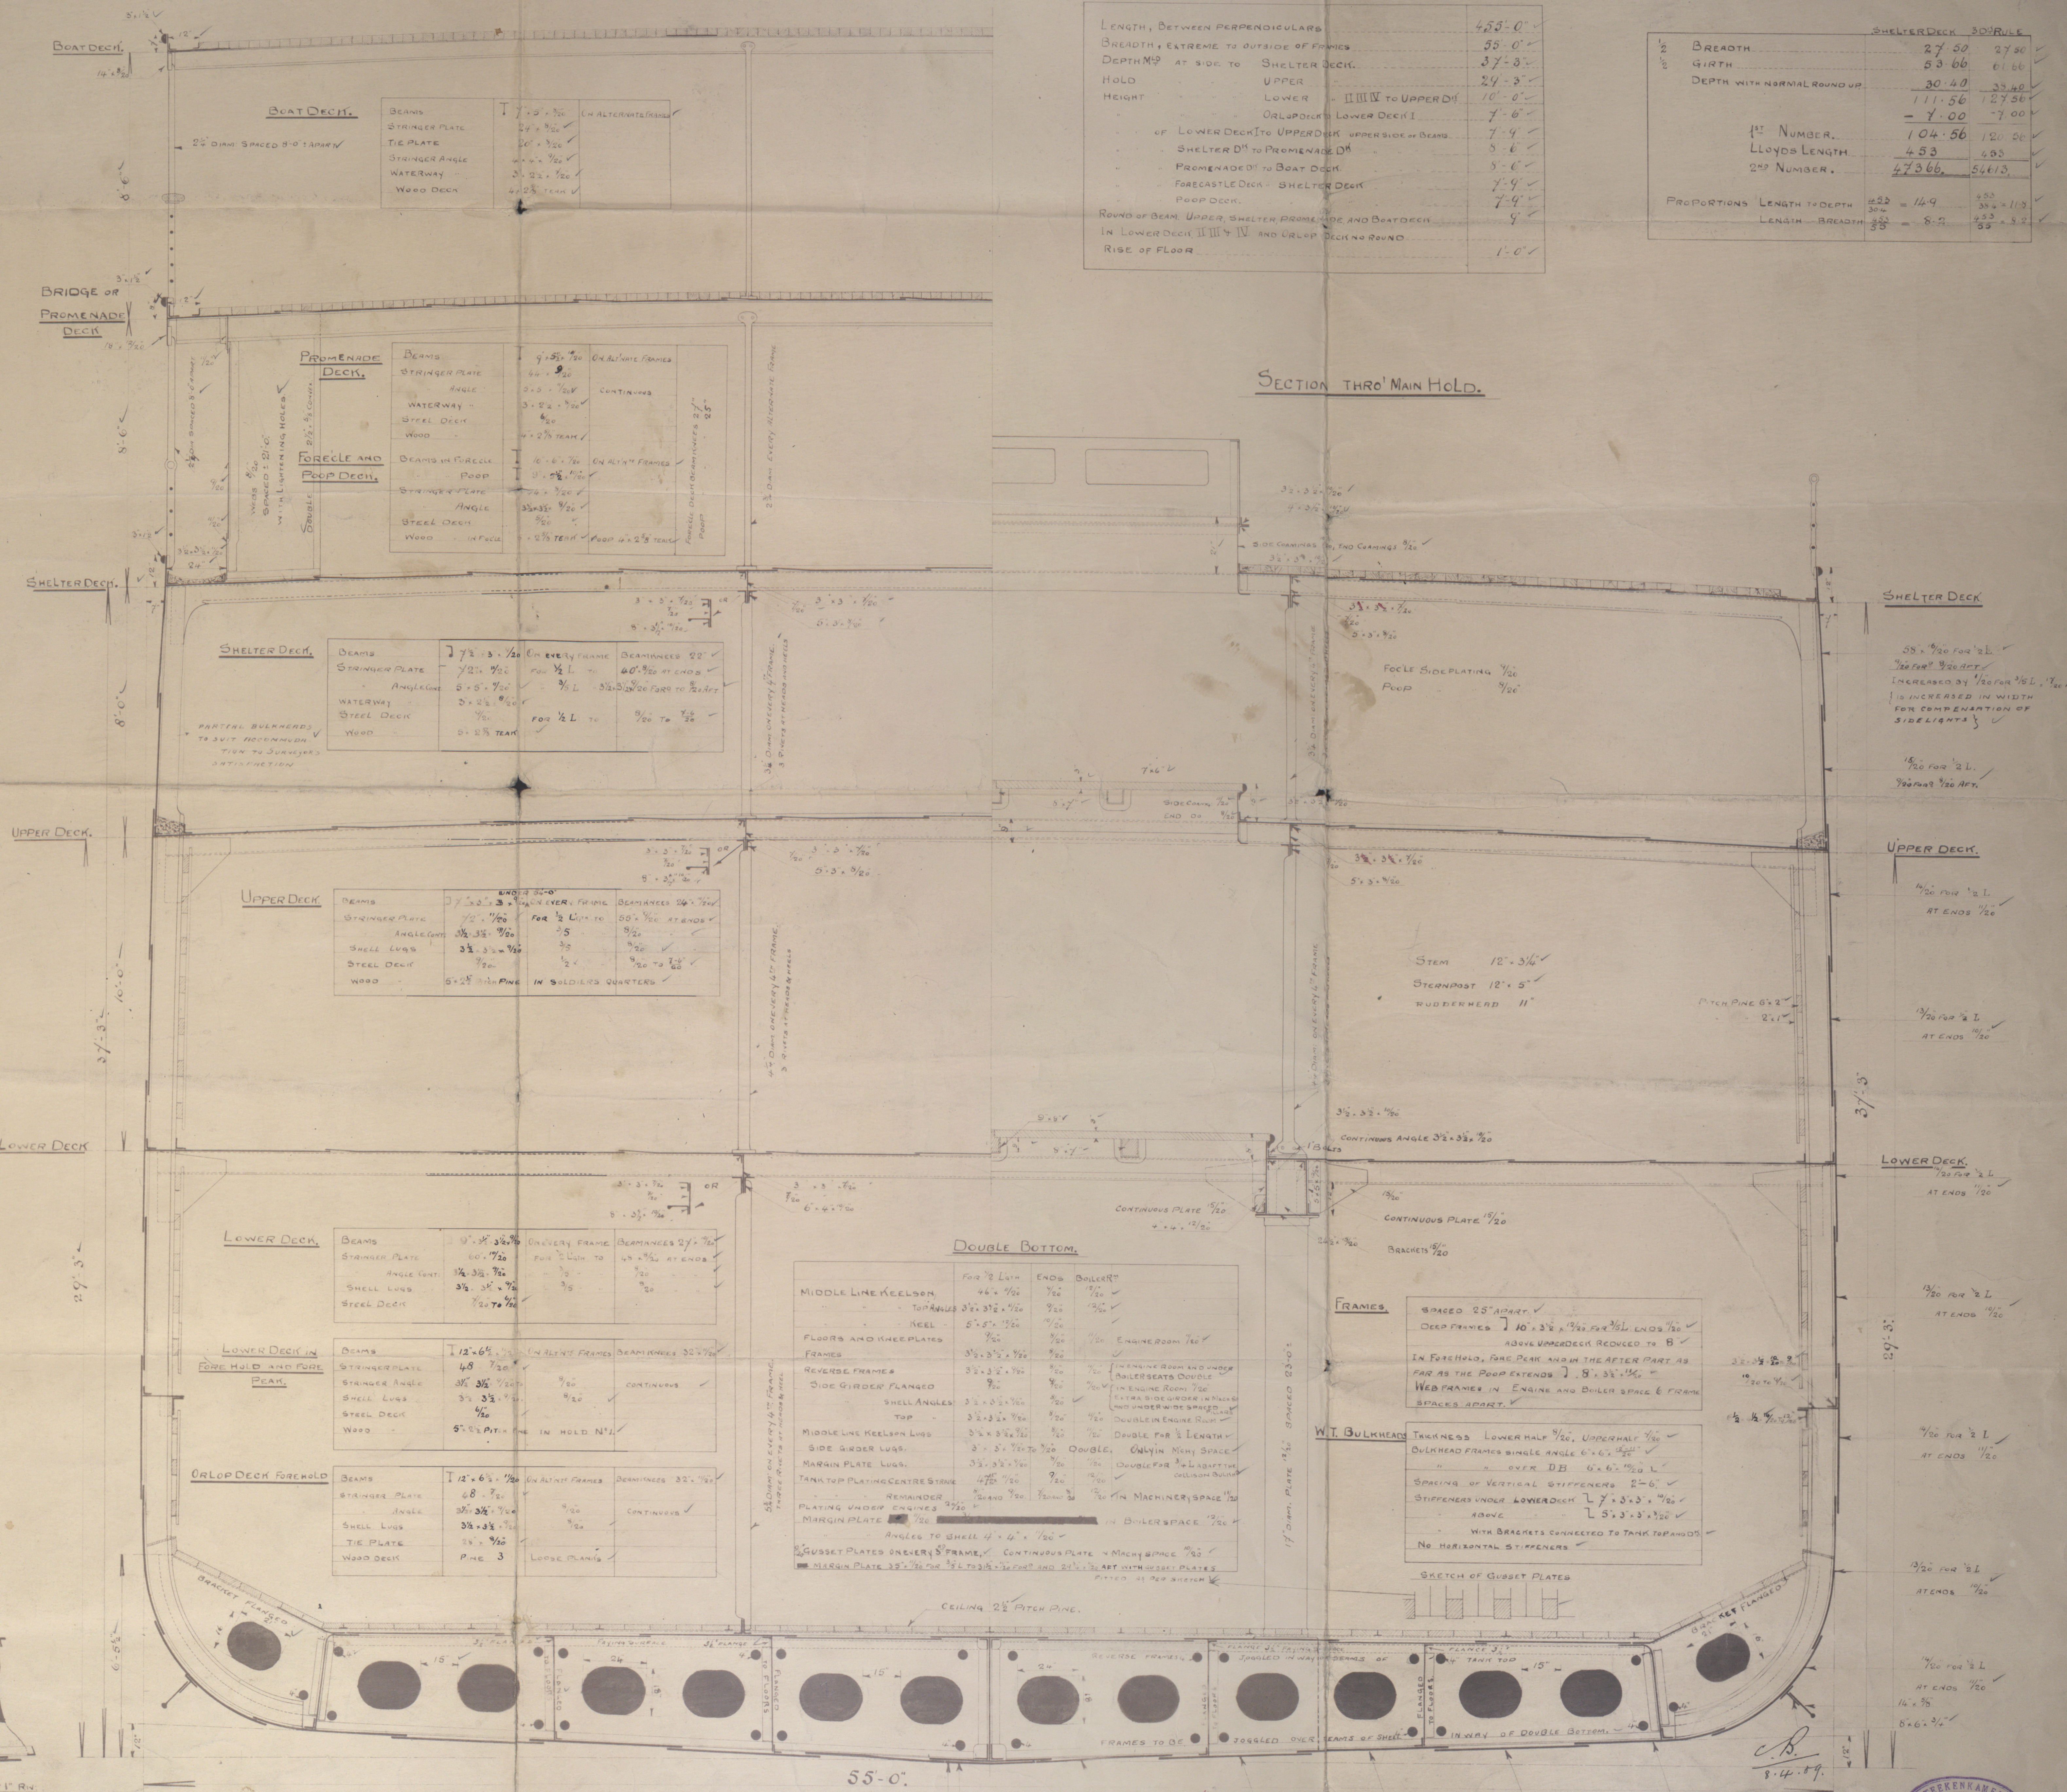

W21-0257






T.S. Princess Juliana
Ann 4635

N.L. No. 115

Midship Section



Costa Rica

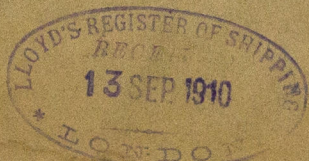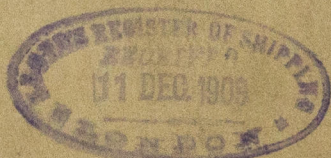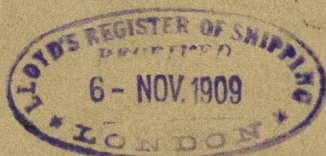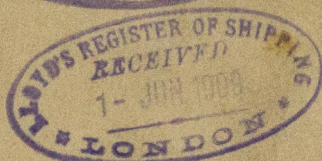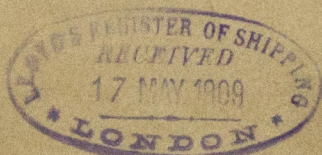

© 2019

Lloyd's Register
Foundation