

APPROVED *Jan 16/0*

U.S. DEPT. OF SHIPPING


H. Dickerson

28.11.31

SHIP N° 162. *v 1/0*

RIVETING OF SKELETON
FRAME STRUTS.

SCALE $\frac{3}{4}$ " = 1 FOOT.

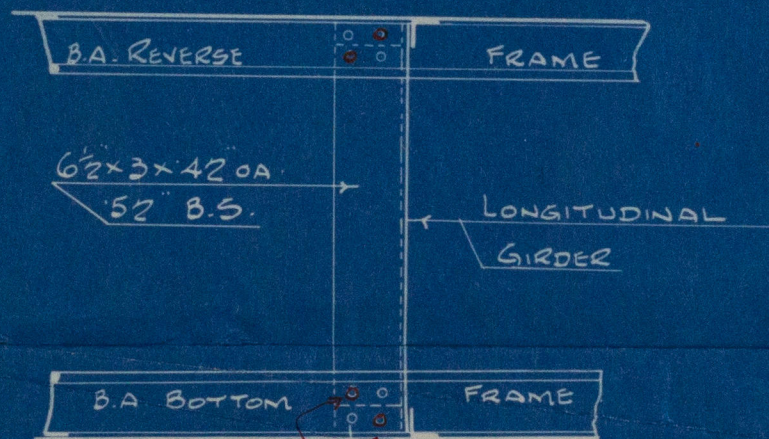

PLAN N° 2517.

PRINT N° 9231

2 additional
4 $\frac{3}{4}$ RIVETS TOP & BOTTOM
loc of fore & aft brackets on pillars
INWAY OF PILLAR TOE BXTS.
5 LAP. 2- $\frac{3}{4}$ RIVETS
TOP & BOTTOM ELSEWHERE

U.S.

H. L. Ward

DATE *5-12-29*

Burnt Island S B Co.
N^o 162

Painting of Skeleton
frame struts

8/5 "Queensbury"
Lth Rpt No 17886

W210-0046



© 2020

Lloyd's Register
Foundation