

PRINCIPAL DIMENSIONS

LENGTH TO RULE	274.6 FEET
BREADTH MOULDED	39.66 FEET
DEPTH MOULDED TO UPPER DECK	20.25 FEET
CLASS	100' A1 *troyos
SCALE $\frac{1}{8}" = \text{ONE FOOT}$	



Nº 307 PROFILE & DECKS.

S. P. AUSTIN & SON, LTD.
SHIPBUILDERS & REPAIRERS,
WEAR DOCK YARD,
SUNDERLAND.



Date 21/1/24
Reference No. 9207 1111

FREEBOARD PARTICULARS	
LENGTH B.P. TO TIP OF STEM	275'-0"
LENGTH ON L.W.L	274'-7 1/4"
BREADTH EXTREME	39'-10 1/2"
BREADTH MOULDED	39'-8"
DEPTH OF HOLD <small>MEASURED FOR STOWING ON L.W.L. TIP</small>	18'-2 1/2"
DEPTH MOULDED	20'-3"
UNDER DECK TONNAGE <small>[CORRECTED]</small>	1610
DISPLACEMENT COEF	.76
SHEER FORWARD	6'-9"
" B.L. FROM STEM	3'-8 1/2"
SHEER AFT	3'-3"
SHEER B.L. FROM AFT	1'-9 1/2"
RAISED QUARTER DECK <small>65'-4 1/2" x 4'-2"</small>	
FORECASTLE <small>30'-3" x 7'-0"</small>	
RAISED QUARTER DECK TYPE DEEP BULBANCE FRAMES	
NO CEILING ON TANK TOP	
CARGO BATTENS TO BE FITTED	



Windlass, winches, steering gear &
supported to Surveyors satisfaction.

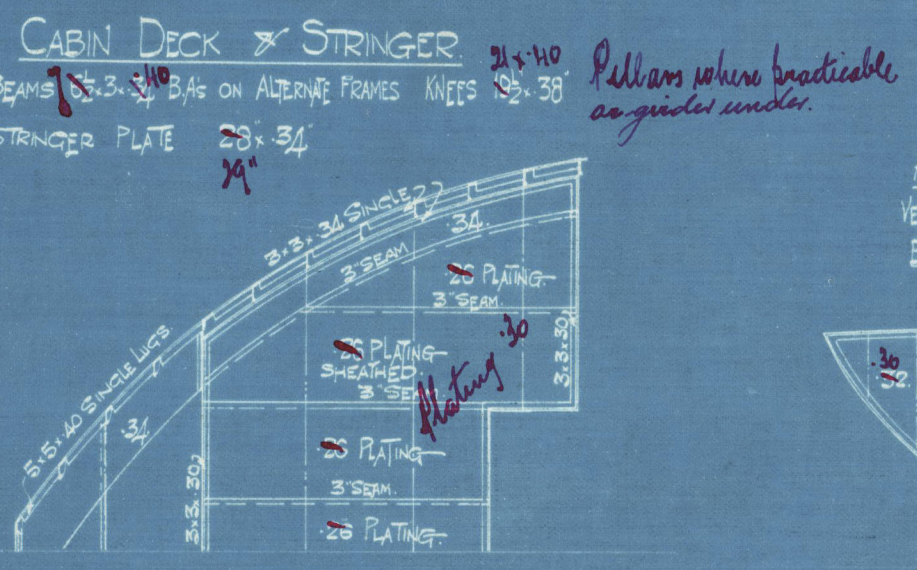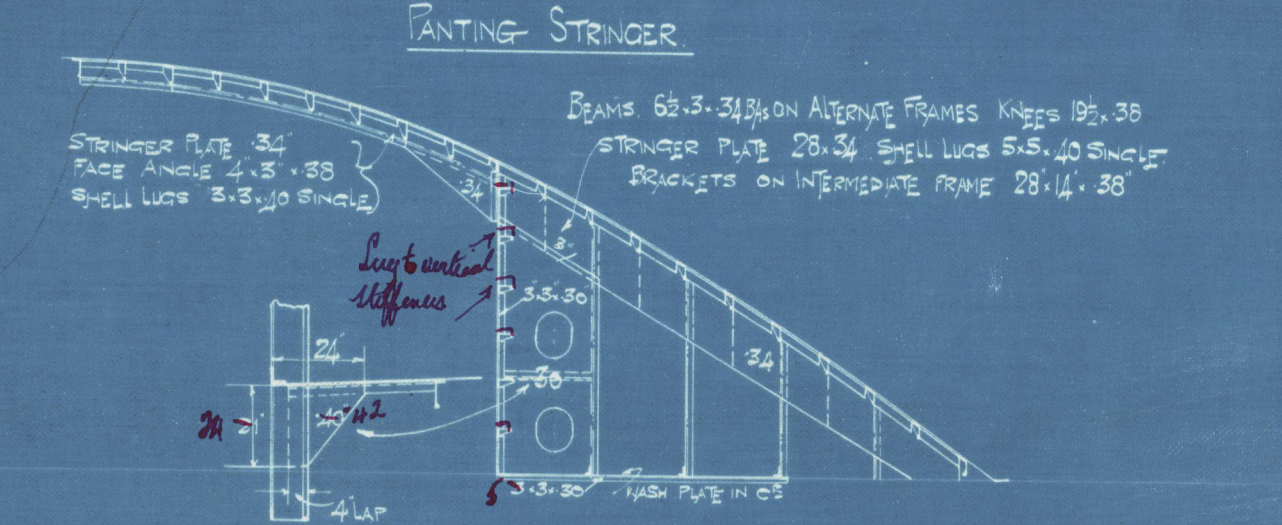


AFTER PEAK BULKHEAD ON 6 FRAME.
VERTICAL STIFF^{RS} 7-3-~~40~~ 40 B.A.s SPACED 24" APART. Rugged to horizontal
BRACKETS TO DECK 17-40 4 3/4" RIVETS. at lower ends.

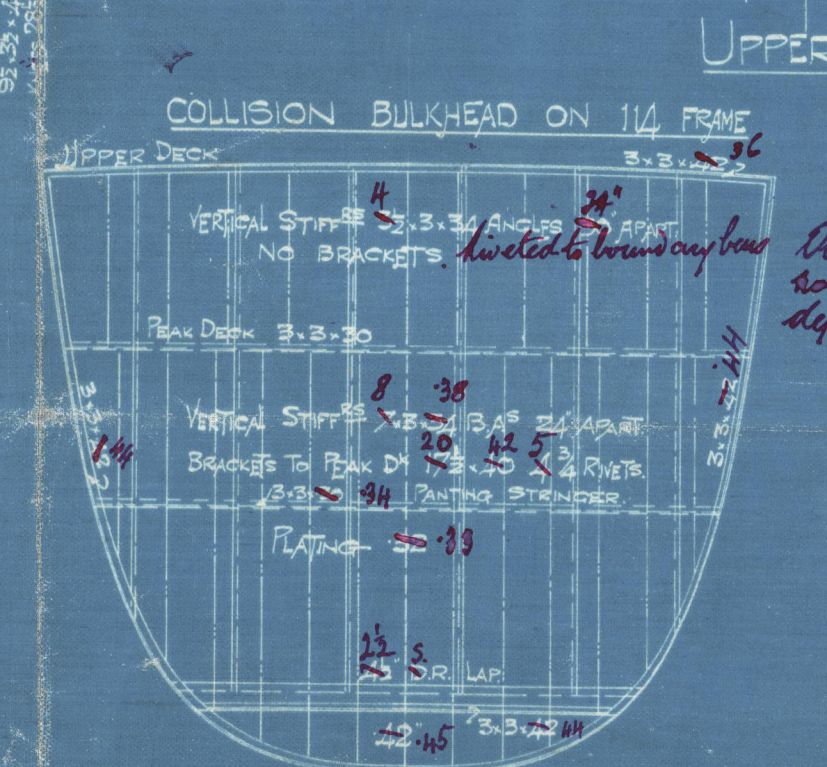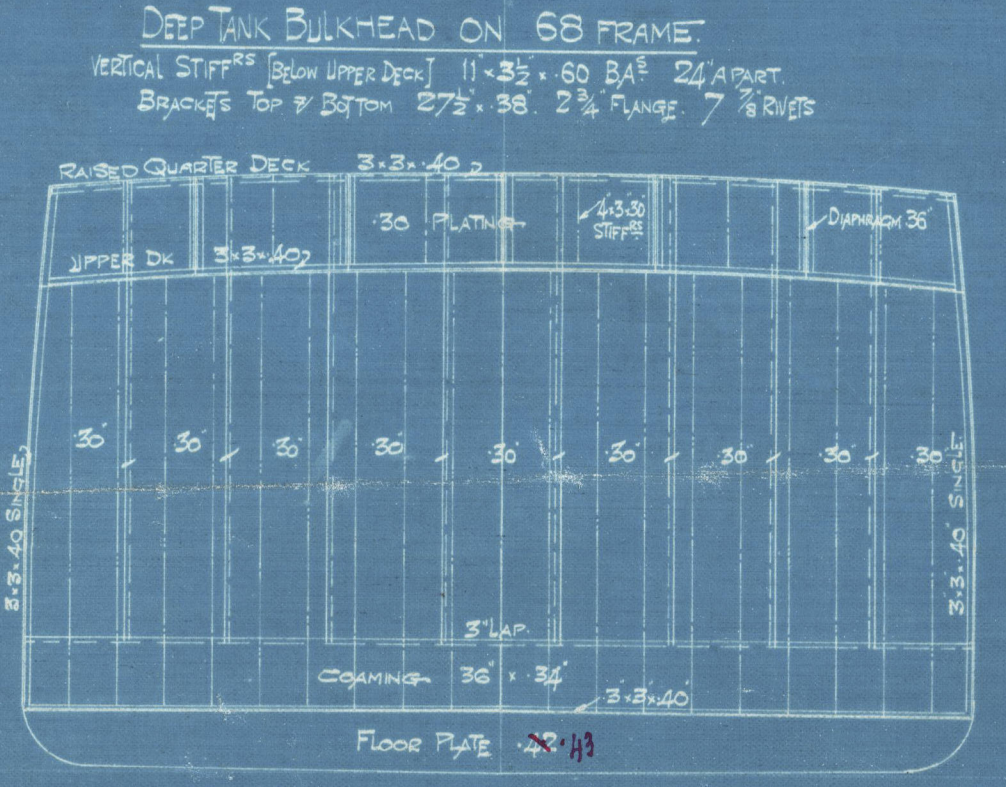

Continued at lower ends of cliffs
to Surgeons satisfaction.

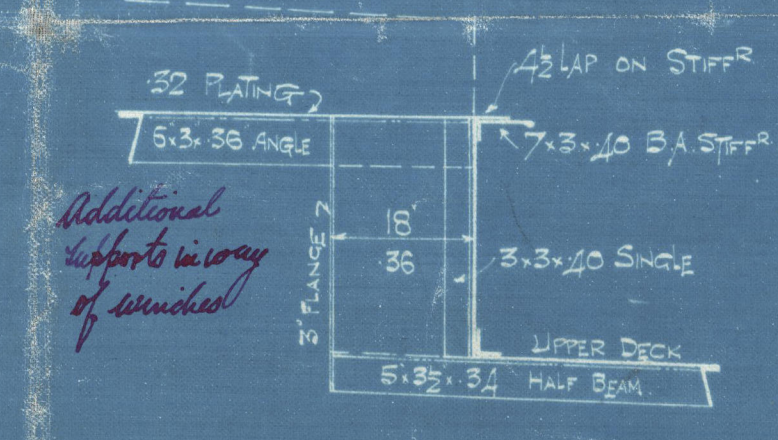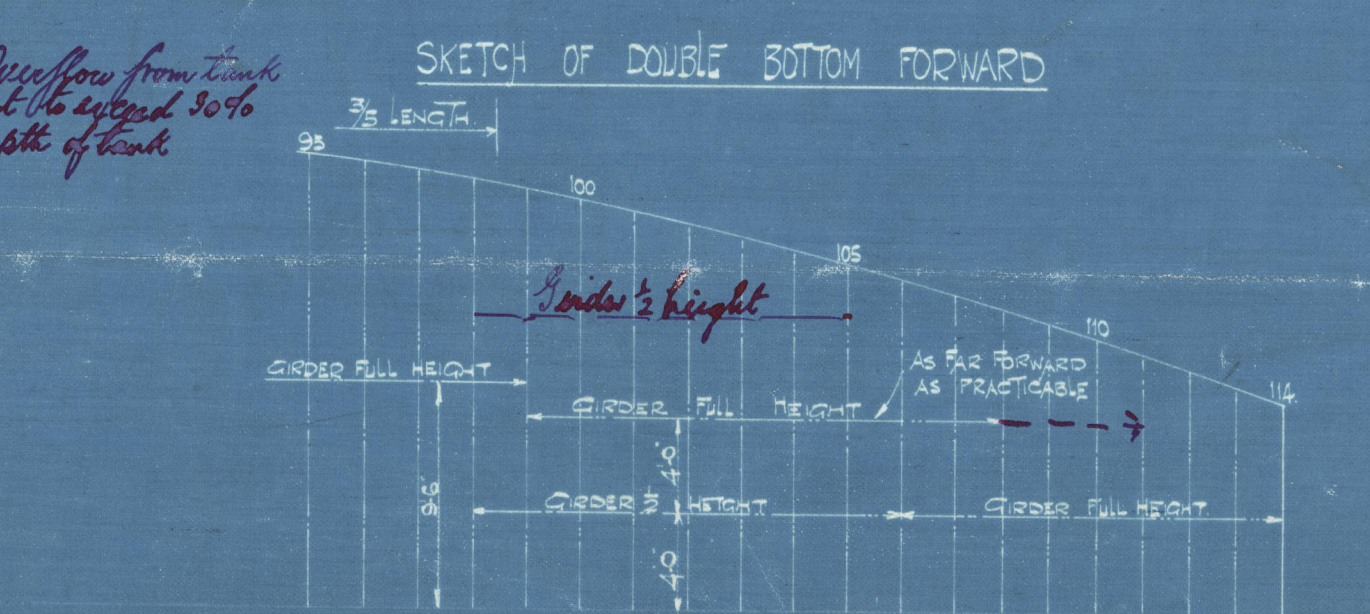

Additional
Supports in way

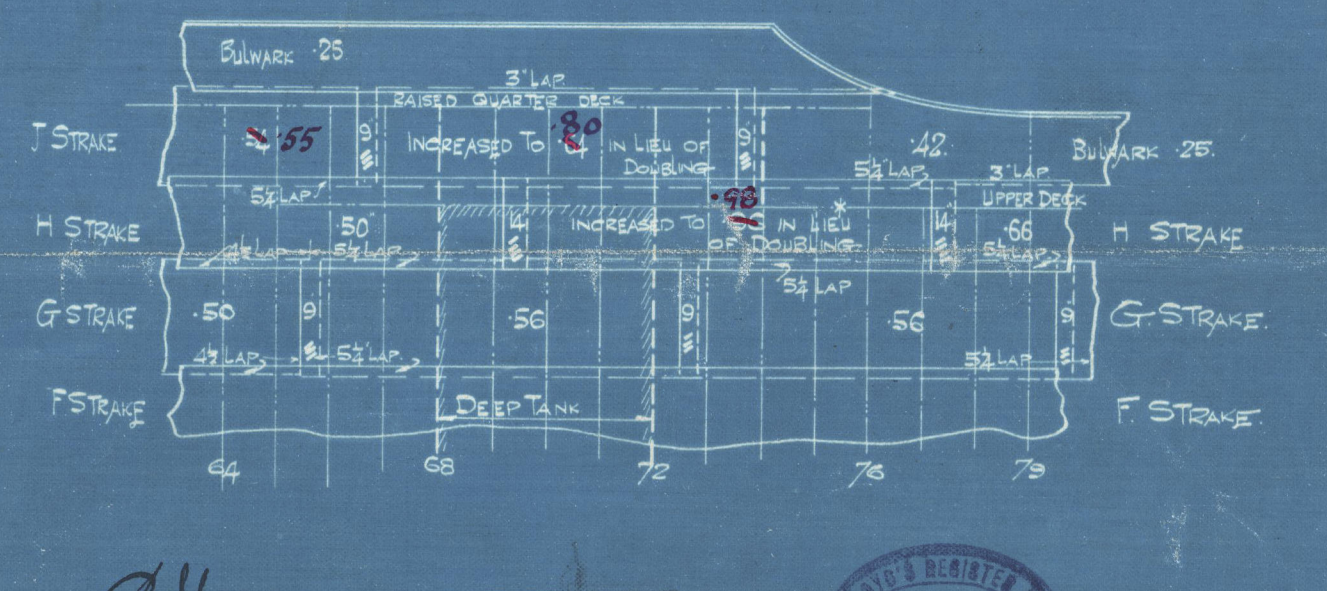

Sunderland

S. P. Austin & Son.

— No 307 —

Profile & Decks.

"S.S. QUEENWORTH."

Std Rpt No. 28939



© 2020

Lloyd's Register
Foundation

W210

-0109