


13.7.03

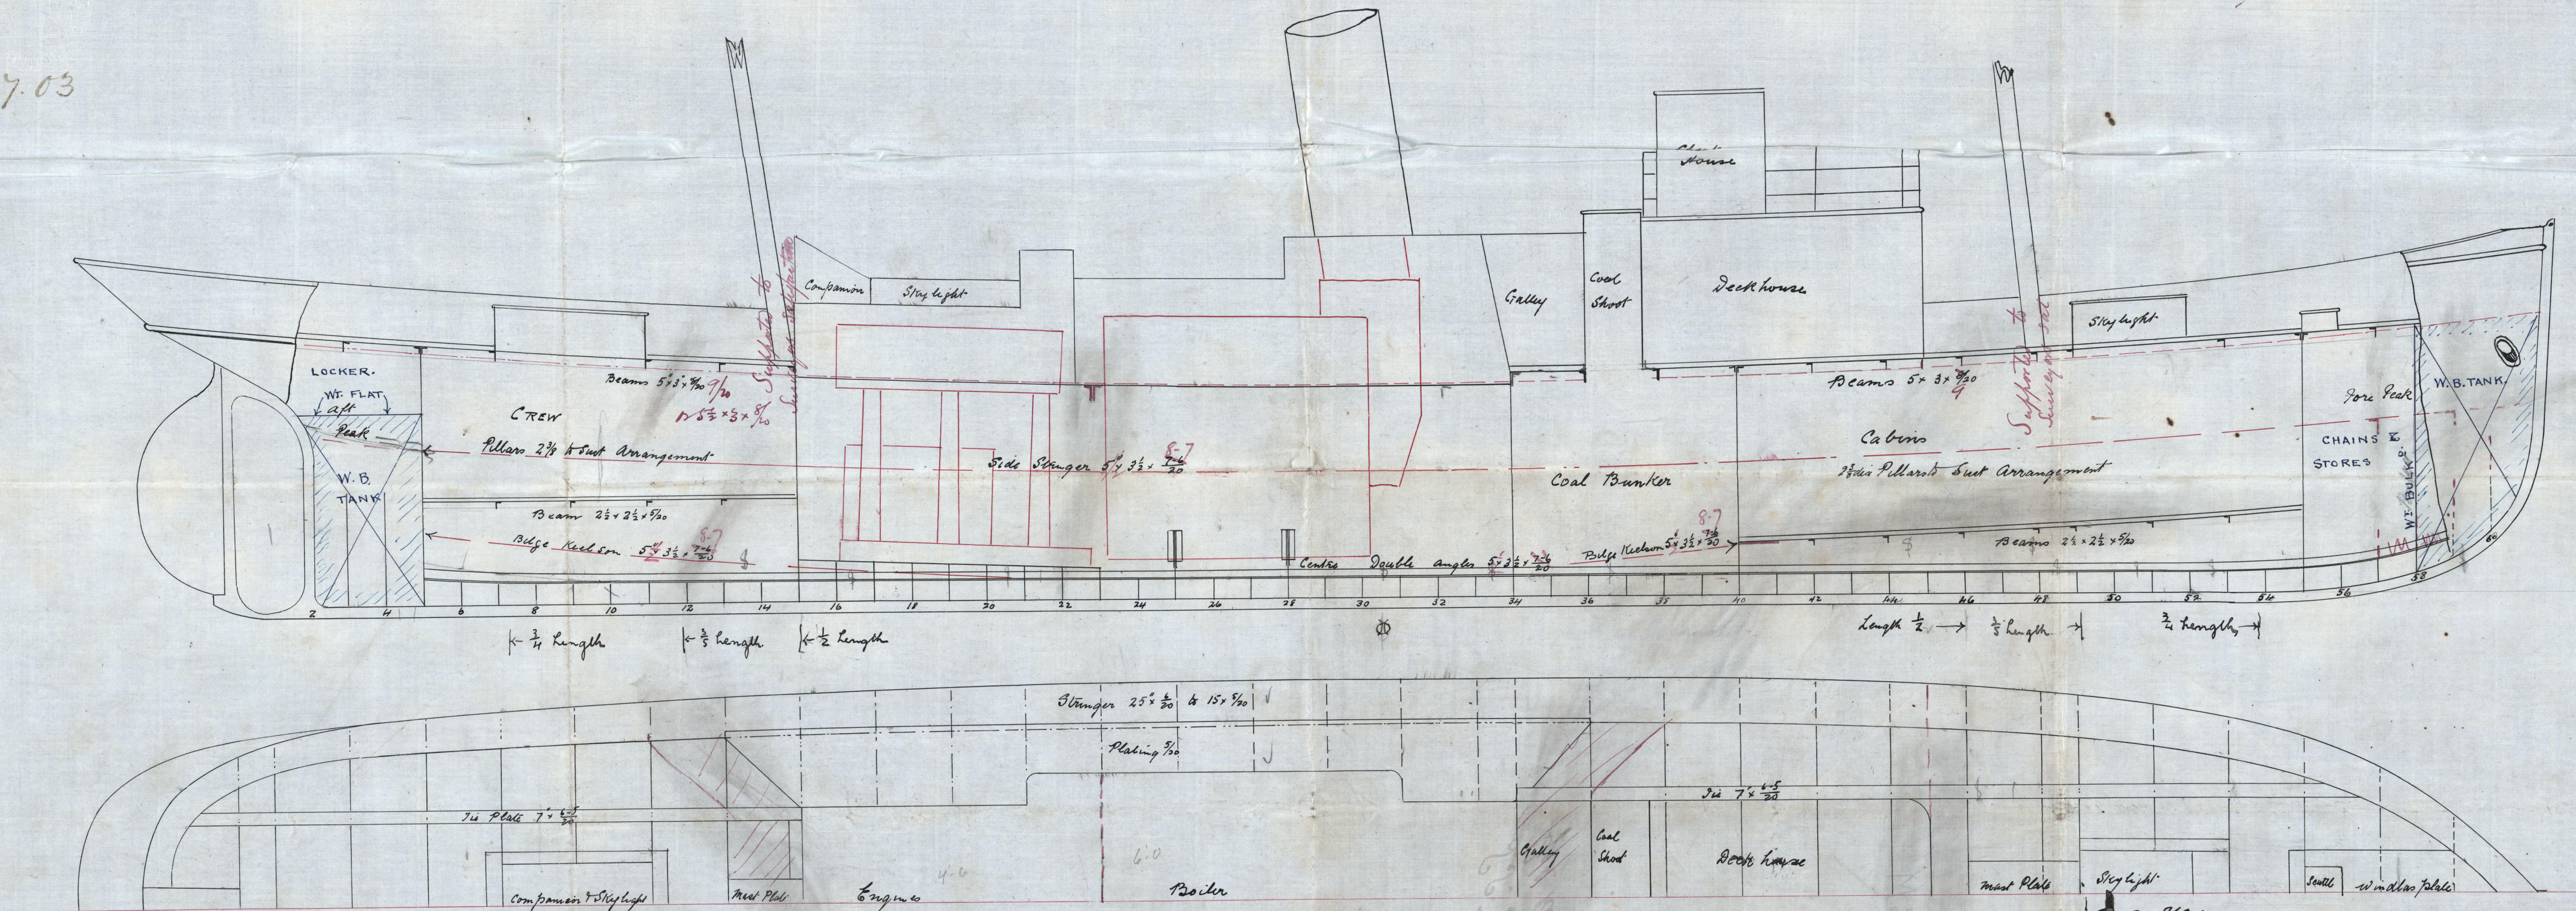

S.S. 4020  
Profile and deck plan  
Dims 108' x 21' x 10' max  
Scale  $\frac{1}{4}" = 1$  foot

To class 100 A1 at Lloyd's


W210-0202

9/7/03  
Bennett



Profile & Plan  
G. Brown No  
No 20

S.S. Protector  
Gen report No 13862

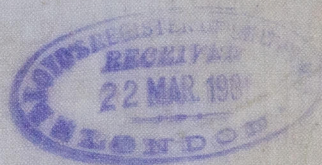

W210-0202

© 2020



Lloyd's Register  
Foundation