


### HORIZONTAL FLUE TUBES.

17 NOV 1964

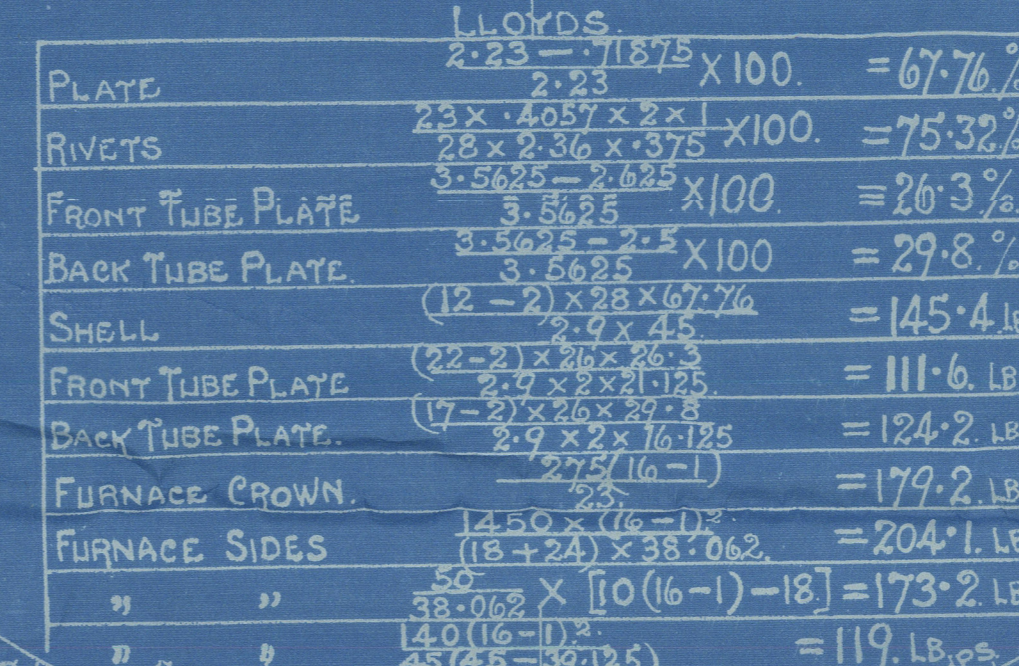

AVE  
&

PATENT BOILER N<sup>o</sup> 13429
$$3' - 9''_{DA} \times 10' - 0''_{High} \times 100 \text{ F.H.S.} \times 100 \text{ L.B. W.P.}$$

22249

DRAWING NO. 20782



Lloyd's Register  
Foundation

SURVEY:- LLOYDS.

Rollin  
N<sup>os</sup> 13429-30

Drawing  
N<sup>o</sup> 22249

W P 100

Sub hor 11-11-36

app " 17-11-36

Roxburgh Castle

13429 Bel. 11967.

N<sup>o</sup> 19865

Lloyds test

200 lbs

W P 100

JSC 16-12-36

GLASGOW REPORT No 57802

W212-0134

Lloyd's Register  
Foundation