


CLASS:-100.A.1.LLOYDS.

	POOP	F'CSLE.
SIDE PLATING	.36"	.38"
STRINGER PLATE	32" x 32"	32" x 32"
" ANGLE	3" x 3" x 32"	3" x 3" x 32"
DECK PLATING	.25"	.30"
BEAMS	7" x 3" x 36 BA.	8" x 3" x 44 BA
BEAM KNEES	20" x 40"	20" x 40"
PILLARS	2 3/4"	2 3/4"

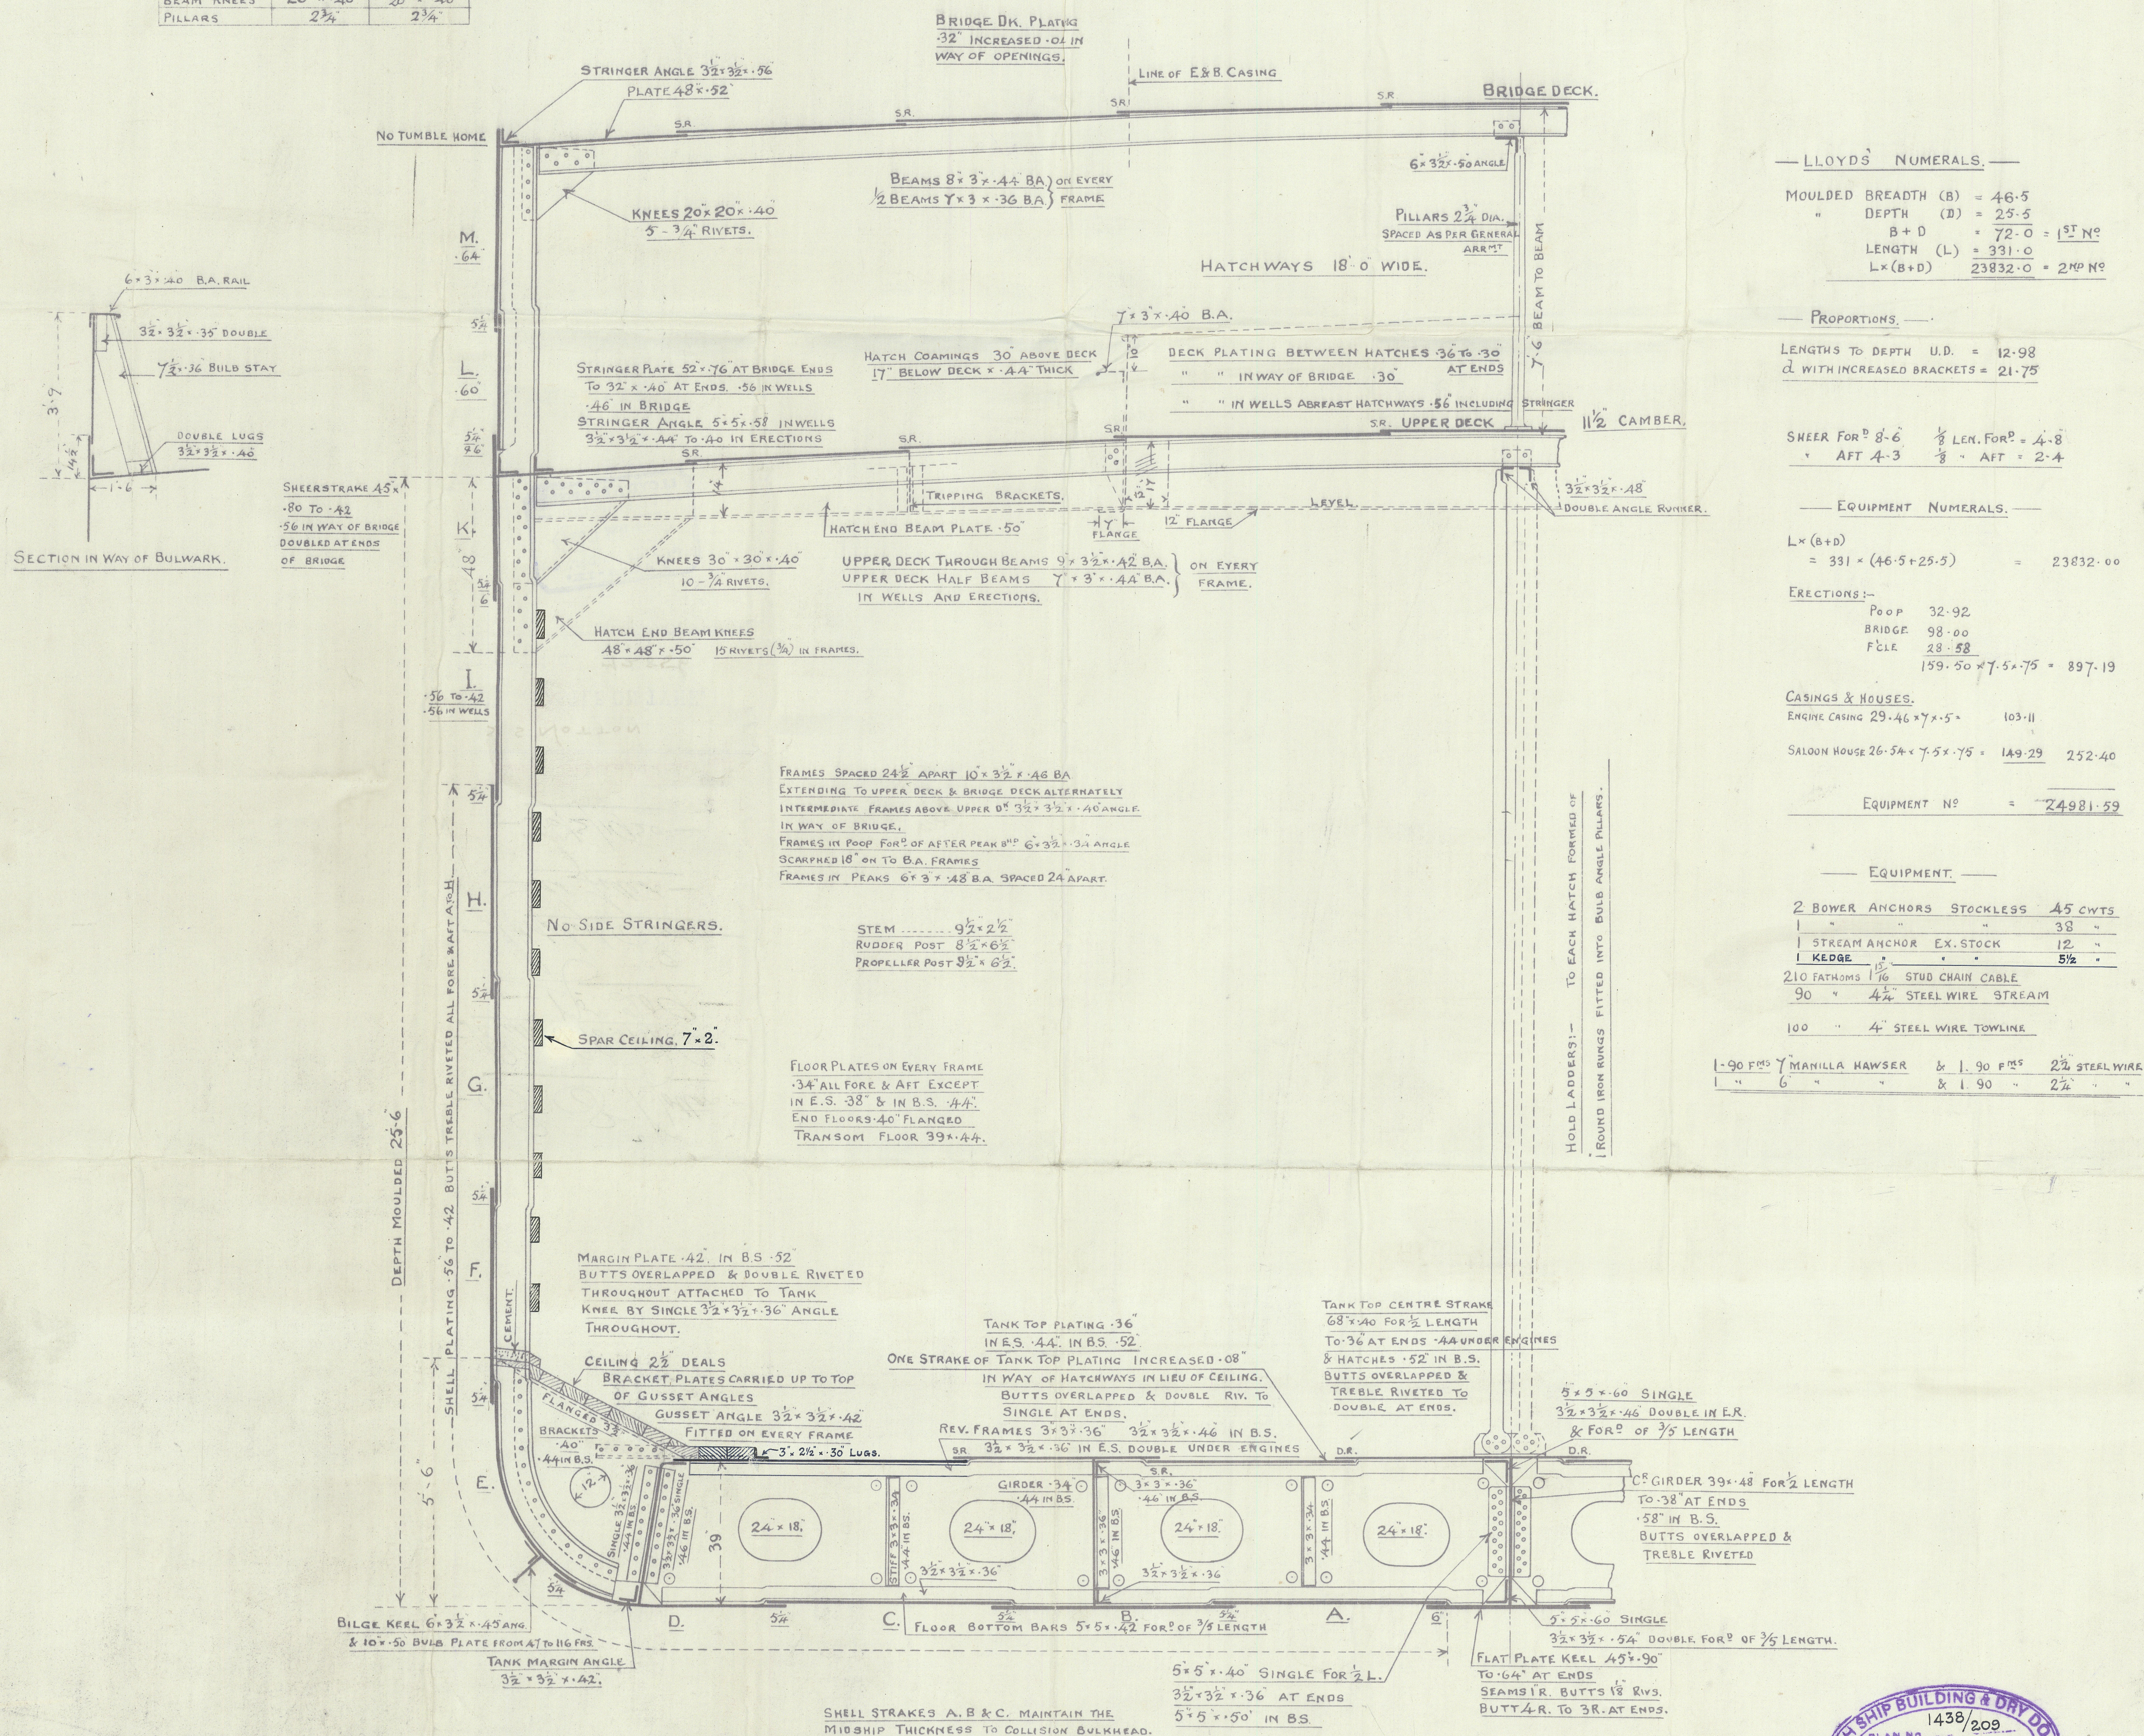

— LLOYD'S NUMERALS. —

$$\begin{aligned} \text{MOULDED BREADTH (B)} &= 46.5 \\ \text{" DEPTH (D)} &= 25.5 \\ \text{B + D} &= 72.0 = \underline{1^{\text{ST}} \text{ NO}} \\ \text{LENGTH (L)} &= 331.0 \\ \text{L} \times (\text{B} + \text{D}) &= 23832.0 = \underline{2^{\text{ND}} \text{ NO}} \end{aligned}$$

## PROPORTIONS.

LENGTHS TO DEPTH U.D. = 12.98  
d WITH INCREASED BRACKETS = 21.75

SHEER FOR<sup>D</sup> = 8'-6"       $\frac{1}{8}$  LEN. FOR<sup>D</sup> = 4'-8"  
AFT 4'-3       $\frac{1}{8}$  " AFT = 2'-4"

— EQUIPMENT NUMERALS. —

$$L \times (B+D) = 331 \times (46.5 + 25.5) = 23832.00$$

ERECTIONS:—

POOP	32.92
BRIDGE	98.00
F'CLE	28.58
<hr/>	
	159.50 * 7.5 * .75 = 897.19

CASINGS & HOUSES.

ENGINE CASING  $29.46 \times 7 \times .52$  103-11

SALOON HOUSE  $26.54 \times 7.5 \times .75 = 149.29$  252.40

EQUIPMENT NO = 24981-59

— EQUIPMENT.

2	BOWER ANCHORS	STOCKLESS	45 CWTs
1	"	"	38 "
1	STREAM ANCHOR	EX. STOCK	12 "
1	KEDGE	"	5 1/2 "
210 FATHOMS	15" STUD CHAIN CABLE		
90 "	4 1/2" STEEL WIRE	STREAM	
100 "	4" STEEL WIRE	TOWLINE	

1-90 FMS	7" MANILLA HAWSER	& 1-90 FMS	2 1/2" STEEL WIRE
1 "	6 " "	& 1-90 "	2 1/4 " "

THE BLYTH SHIP BUILDING & DRY DOCK CO. LTD.

PLAN NO. 1438/209

DATE FEB. 26<sup>TH</sup> 1920.



- S. S. Nottan. -

- Depth S. B. & D. Co. -

- No. 209. -

- Midship Section. -  
- as fitted -


- 26/2/1920. -

"Rose Schiaffino" ex.

S. S. NOTTON

NEWCASTLE ON TYNE.

Report No. 12856

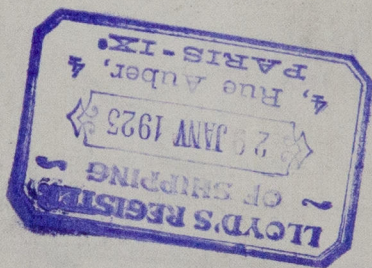

© 2020

W212-0261  
Lloyd's Register  
Foundation