

PROPOSED S/S 650'-0" x 77'-0" x 48'-0" TOP OF KEEL TO UPPER DK BEAMS 57'-0" TO BRIDGE DK BEAMS

To CLASS 100.A1. AT LLOYDS WITH FREEBOARD

SCALE  $\frac{1}{2}'' = 1$  FOOT.

## NUMERALS.


## PROPORTIONS

$$\underline{38.5 + 80.62 + 48 + .6 + .20} = 167.92 \text{ NUMERAL}$$
$$167.92 \times 647.6 = 108745 \quad 2^{(H)} \quad -H-$$
$$\underline{108745 + 17381} = 126126. \text{ Equip}^{\text{MT}}.$$

11:3 DEPTHS TO BRIDGE DECK

13.43 -11- -11- UPPER -11-

8.41 BREADTHS TO LENGTH,

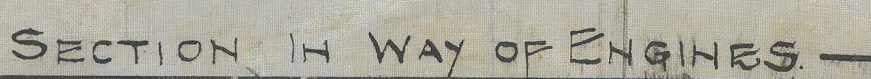



Belfast  
Harland & Wolff L<sup>2</sup>  
650 ft J.B.S


No 390

Rotterdam  
Rel by 95



© 2018  
W213-0163

Lloyd's Register  
Foundation