

254-19.


New Waterway Shipbuilding Company
ENGINEERING DEPARTMENT

EXP. No. 205
DATE 3-5-19
[Signature]

Schiedam - Rotterdam

WITH ENG. LLOYD'S TEST.

85 REVOLUTIONS PER MIN.

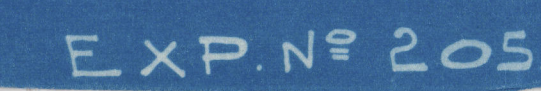

10/11/19
13/5/19


Lloyd's Register
Foundation

Plan of Shaping
New Waterway Ship Co. No. 110-110.

Sl. "Gemma"
Rot. 12167.

Sl. "Zosma"
Rot. 12315.

W214-0211

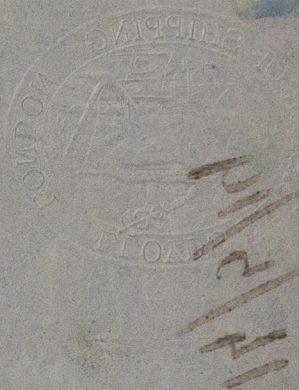

© 2019

Lloyd's Register
Foundation